

check out - 12/15/61  
9:30 - 1/5/62

# PERMIT

P 04629  
A 03111

SEWAGE DISPOSAL SYSTEM

MARYLAND STATE DEPARTMENT OF HEALTH

HOWARD COUNTY

ELLICOTT CITY

DISTRICT 4

DATE 12/12/61

Howard Pickett

IS PERMITTED TO INSTALL  ALTER

ADDRESS \_\_\_\_\_ PHONE \_\_\_\_\_

A SEWAGE DISPOSAL-SYSTEM LOCATED AT Bushy Park Road - approx. 100 ft. to right  
of Cemetery Rd.

SUBDIVISION \_\_\_\_\_ ROAD \_\_\_\_\_ LOT \_\_\_\_\_

PROPERTY OWNER Dukes, Pearly

ADDRESS \_\_\_\_\_

### SPECIFICATIONS

DRAIN FIELD \_\_\_\_\_ DEPTH \_\_\_\_\_ FEET, BOTTOM AREA \_\_\_\_\_ SQ. FT.

SEEPAGE PITS  ABSORBENT SIDE-WALL AREA 300 SQ. FT.

SEPTIC TANK CAPACITY 750 GALLONS


FOR GARBAGE GRINDER, INCREASE DISPOSAL AREA 22% & TANK CAPACITY 50%.

OTHER Place the dry well about 110 ft. to 130 ft. from Bushy Park Road and  
about 30 ft. to 50 ft. from the barbed wire fence on the sideline.

PLANS APPROVED BY Raymond Hodges DATE 12/7/60

FILL SEPTIC TANK AND DISTRIBUTION BOX WITH WATER BEFORE CALLING FOR AN INSPECTION. COVER NO WORK UNTIL INSPECTED AND APPROVED.

NEITHER THE HOWARD COUNTY COMMISSIONERS NOR THE HEALTH DEPARTMENT IS RESPONSIBLE FOR THE SUCCESSFUL OPERATION OF ANY SYSTEM.

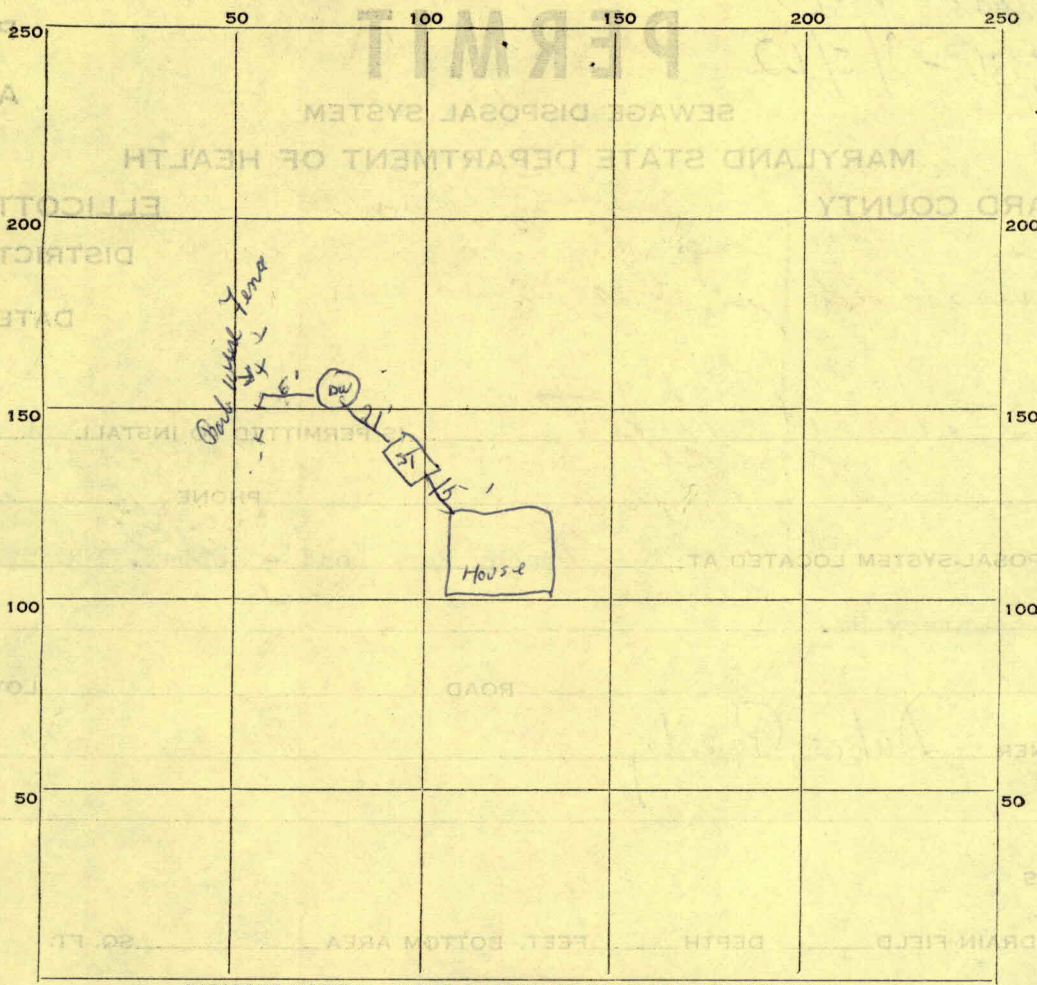

$$\begin{array}{r} 314 \\ 11 \\ \hline 314 \\ 314 \\ \hline 3454 \end{array}$$

$$\begin{array}{r} 345 \\ 9 \\ \hline 3105 \end{array}$$

INDICATE NORTH - NAME ADJOINING ROADWAY AS BASE LINE.

*Bushy Park Rd*

PERMIT CARD OK  
 SEPTIC TANK, LEVEL  CLEANOUTS   
 DISTRIBUTION BOX, LEVEL \_\_\_\_\_  
 TILE FIELD, DEPTH \_\_\_\_\_ FT. TRENCH WIDTH \_\_\_\_\_ FT.  
 GRAVEL DEPTH \_\_\_\_\_ IN. TOTAL LENGTH \_\_\_\_\_ FT.  
 NUMBER OF TRENCHES \_\_\_\_\_ TOTAL BOTTOM AREA \_\_\_\_\_  
 SEEPAGE PITS, INSIDE DIAMETER 11 FT. DEPTH BELOW INLET 9 FT.

ABSORBENT AREA 310 + SQ. FT.

REMARKS: *Dry Well system should be about 30 to 40 ft from fence not 6 ft*  
*Cleanout pipe an. Dry Well cemented tight - could not measure depth 1 1/2 / 15 / 4 DWM*

DATE SYSTEM APPROVED 1-19-62 INSPECTOR D.W. Monaghan