


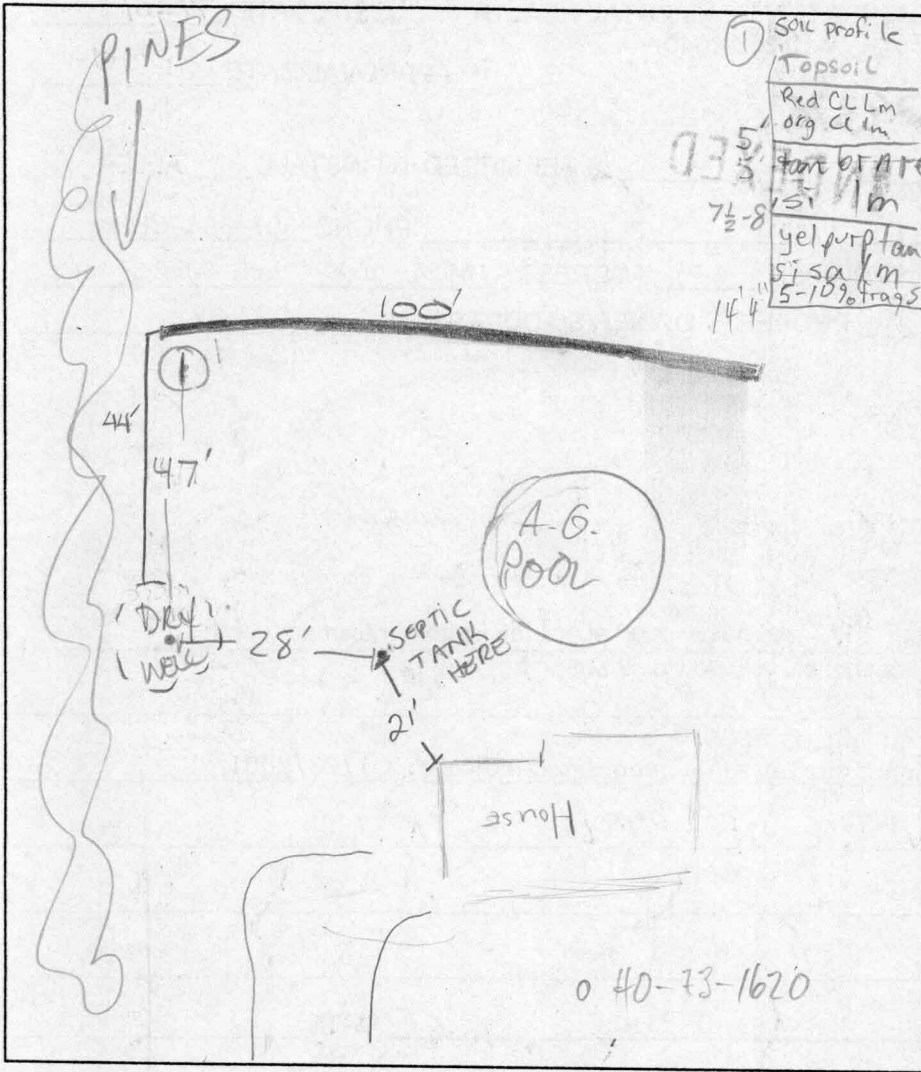

NOT TO SCALE



**TRENCH DATA**

TRENCH WIDTH 2  
 TRENCH INLET DEPTH 4.5  
 TRENCH BOTTOM DEPTH 11.0  
 DEPTH OF STONE 6.5  
 NUMBER OF TRENCHES 1  
 TOTAL TRENCH LENGTH 100  
 ABSORBENT AREA 650  
 DISTRIBUTION BOX LEVEL N/A  
 BAFFLE IN DISTRIBUTION BOX N/A

**SEPTIC TANK DATA**

SEPTIC TANK EXISTING GALLONS  
 MANHOLE RISER \_\_\_\_\_  
 6 INCH INSPECTION PORT \_\_\_\_\_

**PUMP CHAMBER DATA**

~~PUMP CHAMBER GALLONS \_\_\_\_\_  
 MANHOLE RISER \_\_\_\_\_  
 ALARM \_\_\_\_\_  
 PUMP PERFORMANCE TEST \_\_\_\_\_~~

PRE-CONSTRUCTION INSPECTION: 7/26/01 OK TO START PER SPECS MR/KG

INSPECTION COMMENTS: 7/27/01 FINAL INSP- OK TO COVER ALL SEPTIC WORK. DKC

INSPECTOR [Signature] DATE SYSTEM APPROVED 7/27/01