

2/21/02 B0013449

Proposed Deck
O.K. as Shown
BB

Apr 10 01 02:22p

VALUED CUSTOMER

410-381-7533

p.1

Williamsburg Attn: Bob Corbett


Village of 3 Keys 4-10-01

NO.	REVISION	DATE
1.	Rev. loc. of hse & grd. on Lot 1	4-10-01

JESSE WHITE

443-535-8755

PRESERVATION PARCEL A
(NON-BUILDABLE)

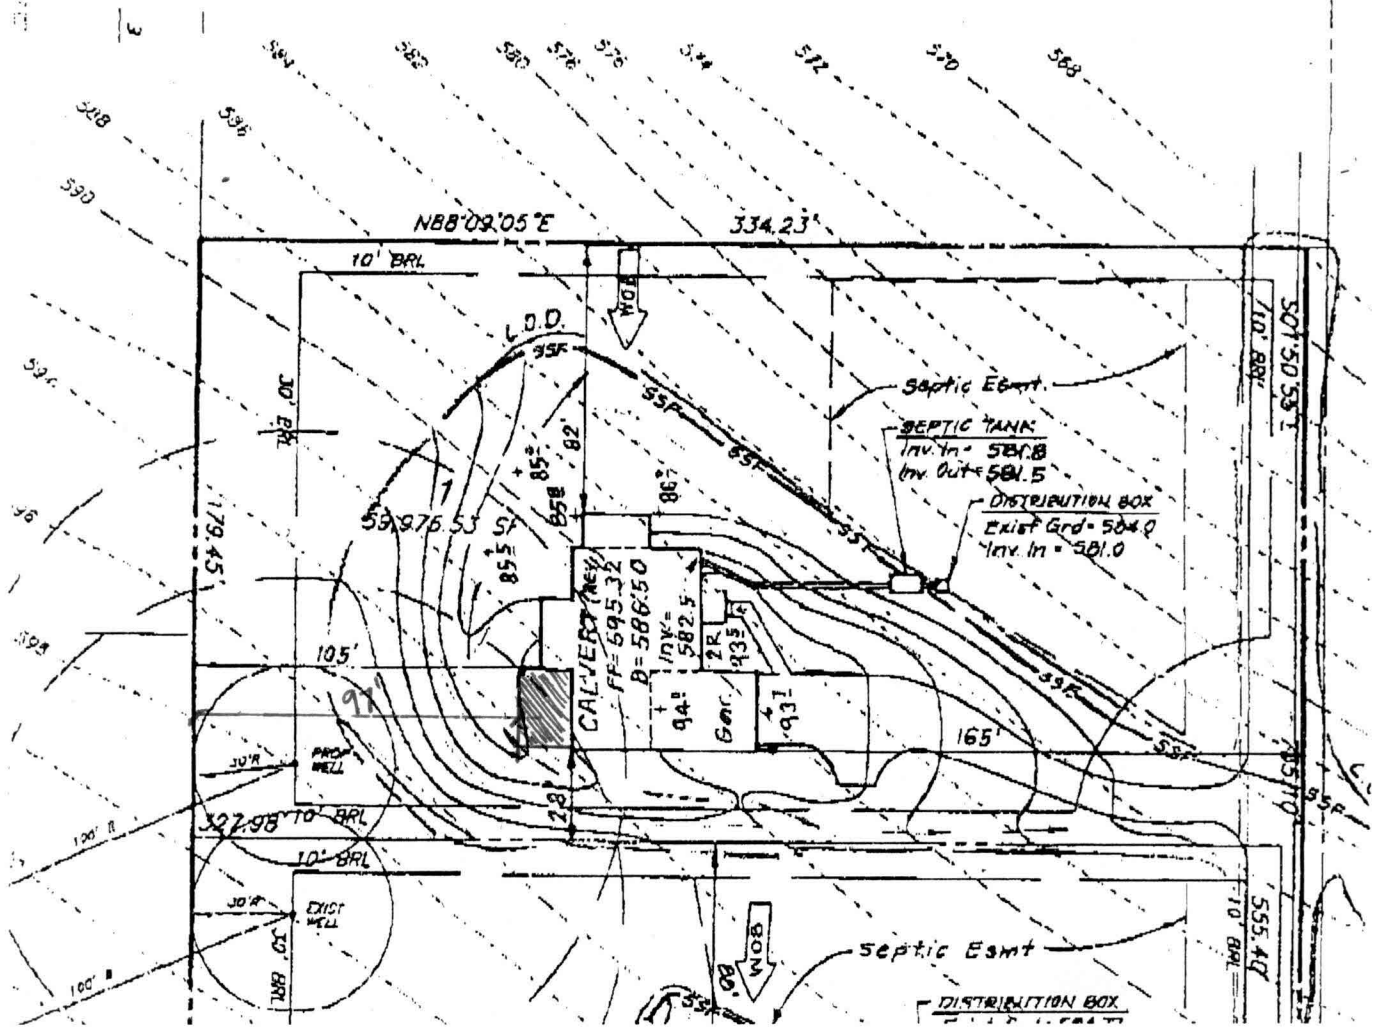

Approved Septic System Plan

Howard County Health Department

SHARED & PRIVATE WITH DRIVEWAY FOR "A" THE DRIVEWAY THE LAND RECORDS

provided
Exist d
Limit of
Plat Ref

Total linear feet of trench required 240 feet

Width of trench(es) 3.0 feet

Depth of trench(es) 6.0 feet

Depth of stone required below distribution pipe 1.5 feet

Amy M. Moore 4/1/01
Signature Date

PRESERVATION PARCEL A
(NON-BUILDABLE)

N 602400
E 1300500

N/V
D. BERNARDO ET. UX. CLARK, FINEFROCK & SACKETT N/V

