

B.1 5054

SEQUENCE NO. (MDE USE ONLY)

STATE OF MARYLAND PERMIT TO DRILL WELL

STATE PERMIT NUMBER

40-94-3221

W515999

please print or type

fill in this form completely

Date Received (APA)

08/20/01

OWNER INFORMATION

8736

B 3

Howard

LOCATION OF WELL


GORDON MONTA
7408 FLAMEWOOD DRIVE
CLARKSVILLE, MD 21029

Flamewood
Fulton
NEAREST TOWN

DRILLER INFORMATION

George F. Easterday
L. Franklin Easterday, Inc.
9265 Brown Church Rd., MT. Airy, Md. 21771

DIRECTION OF WELL FROM TOWN (CIRCLE BOX)

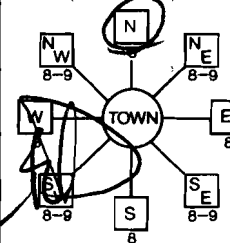

7408 Flamewood Drive
NEAR WHAT ROAD
ON WHICH SIDE OF ROAD (CIRCLE APPROPRIATE BOX)
DISTANCE FROM ROAD 100 Ft.

WELL INFORMATION
APPROX. PUMPING RATE (GAL. PER MIN.) 5

AVERAGE DAILY QUANTITY NEEDED (GAL. PER DAY) 500

USE FOR WATER (CIRCLE APPROPRIATE BOX)

- DOMESTIC POTABLE SUPPLY & RESIDENTIAL IRRIGATION
FARMING (LIVESTOCK WATERING & AGRICULTURAL IRRIGATION)
INDUSTRIAL, COMMERCIAL, DEWATERING
PUBLIC WATER SUPPLY WELL
TEST, OBSERVATION, MONITORING
GEO-THERMAL

Handwritten note: 'Well not drilled - verified 2/12/02'

NOT TO BE FILLED IN BY DRILLER HEALTH DEPARTMENT APPROVAL

Howard COUNTY NAME
13 COUNTY NO.
DATE ISSUED 08/20/01
CO SIGNATURE K. Koedey
EXP DATE 08/19/02

APPROXIMATE DEPTH OF WELL 300 FEET

APPROXIMATE DIAMETER OF WELL 6 INCH

METHOD OF DRILLING (circle one)

- BORED (or Augered)
JETTED
Jetted & DRIVEN
AIR-ROTARY
AIR-PERCussion
ROTARY (Hydraulic Rotary)
CABLE
REVERSE-ROTARY
DRIVE-POINT

REPLACEMENT OR DEEPEMED WELLS (CIRCLE APPROPRIATE BOX)


- THIS WELL WILL NOT REPLACE AN EXISTING WELL
THIS WELL WILL REPLACE A WELL THAT WILL BE ABANDONED AND SEALED
THIS WELL WILL REPLACE A WELL THAT WILL BE USED AS A STANDBY-CONTACT LOCAL APPROVING AUTHORITY FOR POLICY ON STANDBY WELLS
THIS WELL WILL DEEPEMED AN EXISTING WELL

Not to be filled in by driller (MDE OR COUNTY USE ONLY)

APPROX. PERMIT NUMBER G
PERMIT No. 40-94-3221

SHOW MAJOR FEATURES OF BOX & LOCATE WELL WITH AN X
SOURCES OF DRILLING WATER
1. wells
WRITE THE BOX NUMBER FROM THE MAP HERE
E 8209
N 4805

DRAW A SKETCH BELOW SHOWING LOCATION OF WELL IN RELATION TO NEARBY TOWNS AND ROADS AND GIVE DISTANCE FROM WELL TO NEAREST ROAD JUNCTION 18 K 2

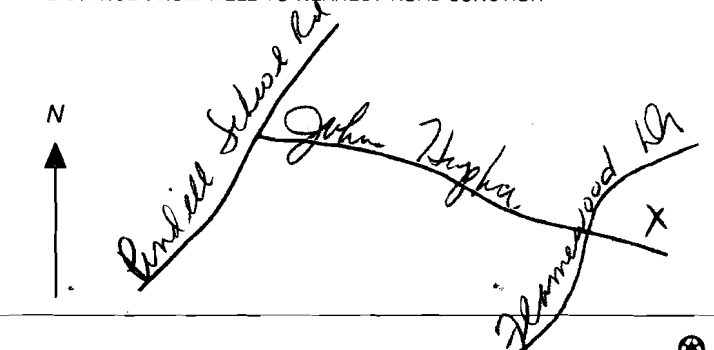

SPECIAL CONDITIONS

NOTE - APPROVING AUTHORITY'S SHOULD USE SEPARATE SHEET IF NEEDED

NEVER DRILLED

SITE INSPECTION SHEET

OWNER: Monta Gordon

DATE REQUESTED: 8/20/01 11:00

ADDRESS: 7408 Flamewood Drive

DRILLER/CONTRACTOR: Easterday


WELL TAG NUMBER: _____

TAX & PARCEL: _____

COUNTY: Howard

PROPOSAL: Ex. well has gone dry per driller.

LOCATION DIAGRAM

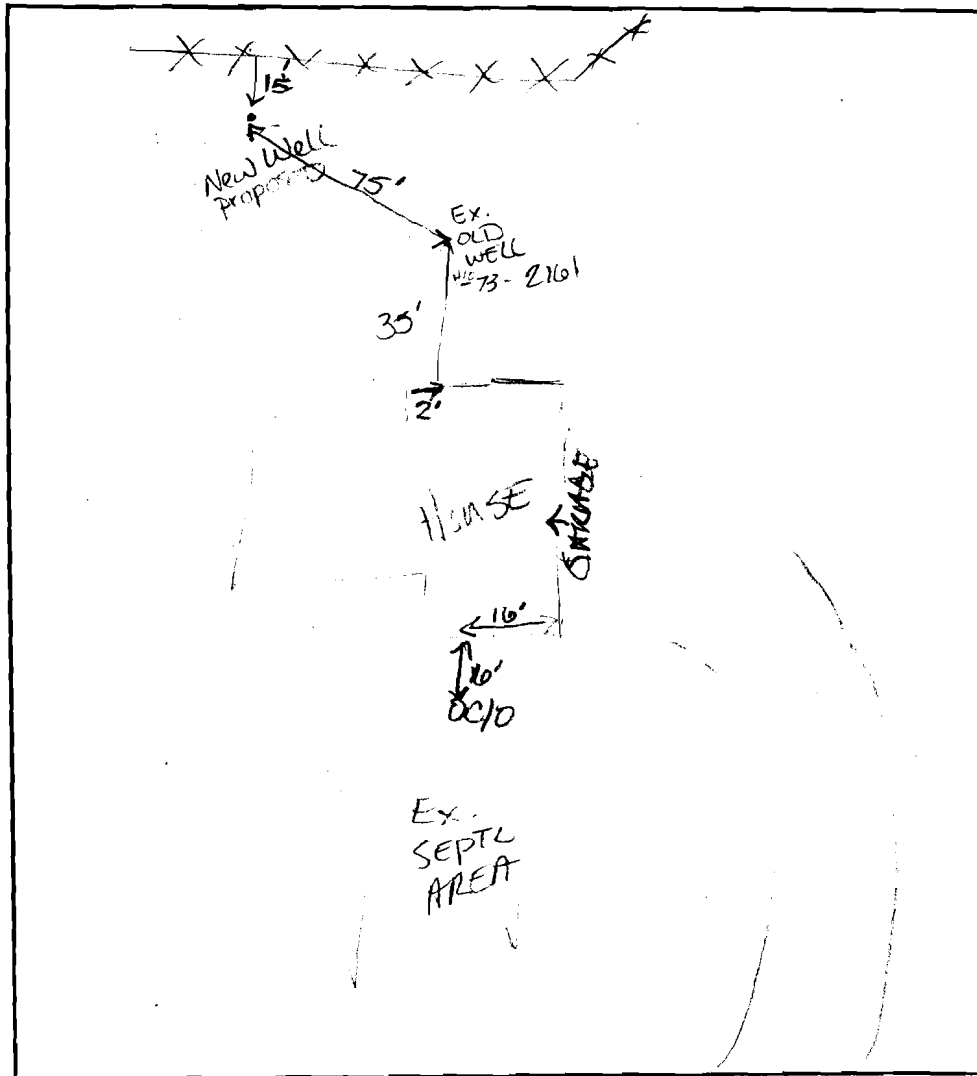

Flamewood Drive

COMMENTS: Owner said septic sys. was replaced w/o permit by previous owner. Plans on keeping Ex. well for gardening

DATE: 8-20-01

INSPECTOR: Goedely