

HOWARD COUNTY
 PERMIT APPLICATION

PERMIT NUMBER
 B09001657

Building Address 7432 FLAMENWOOD DR.
CLARKSVILLE, MD, 21029
 Suite/Apt. #: _____ SDP/WP/Petition #: _____
 Census Tract _____ Subdivision _____
 Section _____ Area 2 Lot 4
 Tax Map 41 Parcel 412 Grid 15
 Zoning _____ Map Coordinates _____ Lot size 125x320
40,000 sq. FT.
 Existing Use NONE
 Proposed Use DECK (OPEN)
 Estimated Construction Cost \$ 7000.00
 Description of Work CONSTRUCT NEW 14X36
IRREGULAR SHAPED DECK WITH STEPS
TO GRADE.

Property Owner's Name Bill & Chrissy Murphy
 Address 7432 FLAMENWOOD DR.
 City CLARKSVILLE State MD Zip Code 21029
 Home Phone 410 451-6492 Work Phone 443 223 3367
 Applicant's Name & Mailing Address, (if other than stated hereon):
MIKE GRUENTZEL
 Phone 443 790 7035 Fax 410 315 7792
 Contractor Company THE APEX GROUP, LLC
 Contact Person MIKE GRUENTZEL
 Address 8213 JUMPERS HOLE Rd. SUITE 103
 City MILLERSVILLE State MD Zip Code 21108
 License No. 85367
 Phone 410 315 7776 Fax 410 315-7792

Occupant or Tenant _____
 Contact Name _____
 Address _____
 City _____ State _____ Zip Code _____
 Phone _____ Fax _____

Engineer or Architect Company _____
 Contact Person _____
 Address _____
 City _____ State _____ Zip Code _____
 Phone _____ Fax _____

BUILDING DESCRIPTION - COMMERCIAL

BUILDING DESCRIPTION - RESIDENTIAL

Building Characteristics
 Height: _____
 No. of stories: _____
 Gross area, sq. ft. per floor: _____
 Use group: _____
 Construction type:
 _____ Reinforced Concrete
 _____ Structural Steel
 _____ Masonry
 _____ Wood Frame
 _____ State Certified Modular

Utilities
 Water Supply:
 _____ Public
 _____ Private
 Sewage Disposal:
 _____ Public
 _____ Private
 Electric Yes No
 Gas Yes No
 Heating System:
 Electric Oil
 Natural Gas
 Propane Gas
 Sprinkler system: N/A
 _____ Full
 _____ Partial
 _____ Other Suppression
 _____ # of Heads

Building Characteristics
 SF Dwelling SF Townhouse
 _____ Depth _____ Width
 1st floor: _____
 2nd floor: _____
 Basement:
 Finished Basement Unfinished Basement
 Craw space Slab on Grade
 No. of Bedrooms _____
 Height: _____
 Multi-family dwellings:
 No. of efficiency units: _____
 No. of 1 BR units: _____
 No. of 2 BR units: _____
 No. of 3 BR units: _____
 Other Structure: DECK
 Dimensions: 14x36
 Footings: _____
 Roof Height: _____
 _____ State Certified Modular
 _____ Manufactured Home

Utilities
 Water Supply:
 _____ Public
 Private
 Sewage Disposal:
 _____ Public
 Private
 Electric Yes No
 Gas Yes No
 Heating System:
 Electric Oil
 Natural Gas
 Propane Gas
 Sprinkler system: N/A
 _____ NFPA #13D
 _____ NFPA #13R
 _____ Other:

THE UNDERSIGNED HEREBY CERTIFIES AND AGREES AS FOLLOWS: (1) THAT HE/SHE IS AUTHORIZED TO MAKE THIS APPLICATION, (2) THAT THE INFORMATION IS CORRECT, (3) THAT HE/SHE WILL COMPLY WITH ALL REGULATIONS OF HOWARD COUNTY WHICH ARE APPLICABLE THERETO, (4) THAT HE/SHE WILL PERFORM NO WORK ON THE ABOVE REFERENCED PROPERTY NOT SPECIFICALLY DESCRIBED IN THIS APPLICATION, (5) THAT HE/SHE GRANTS COUNTY OFFICIALS THE RIGHT TO ENTER ONTO THIS PROPERTY FOR THE PURPOSE OF INSPECTING THE WORK PERMITTED AND POSTING NOTICES.

Michael Gruentzel
 Applicant's Signature
PRESIDENT/THE APEX GROUP,
 Title/Company


MICHAEL GRUENTZEL
 Print Name
7/8/09
 Date

Checks payable to: DIRECTOR OF FINANCE OF HOWARD COUNTY
 ** PLEASE WRITE NEATLY AND LEGIBLY. **

FOR OFFICE USE ONLY

AGENCY	DATE	SIGNATURE APPROVAL	DPZ SETBACK INFORMATION	PROPERTY ID#
Land Development DPZ			Front: _____	Filing fee \$ _____
State Highways			Rear: _____	Permit fee \$ _____
Building Official			Side: _____	Excise tax \$ _____
Dev. Engineering DPZ			Side St. _____	Add'l per. fee \$ _____
Health	<u>7/8/09</u>	<u>[Signature]</u>	All minimum setbacks met?	TOTAL FEES \$ _____
Fire Protection			YES <input type="checkbox"/> NO <input type="checkbox"/>	Sub-total paid \$ _____
Is Sediment Control approval required prior to issuance?			Is Entrance Permit required?	Balance due \$ _____
YES <input type="checkbox"/> NO <input type="checkbox"/>			YES <input type="checkbox"/> NO <input type="checkbox"/>	Check # _____
			Historic District?	Validation # _____
			YES <input type="checkbox"/> NO <input type="checkbox"/>	
CONTINGENCY CONSTRUCTION START: <input type="checkbox"/>			Lot Coverage for New Town Zone _____	
ONE STOP SHOP: <input type="checkbox"/>			SDP/Red-line approval date _____	Accepted by _____
Distribution of Copies: _____	White: Building Official	Green: LDD, DPZ	Yellow: DED, DPZ	Pink: Health
Gold: SHA				

N 76°19'00" E
125.00

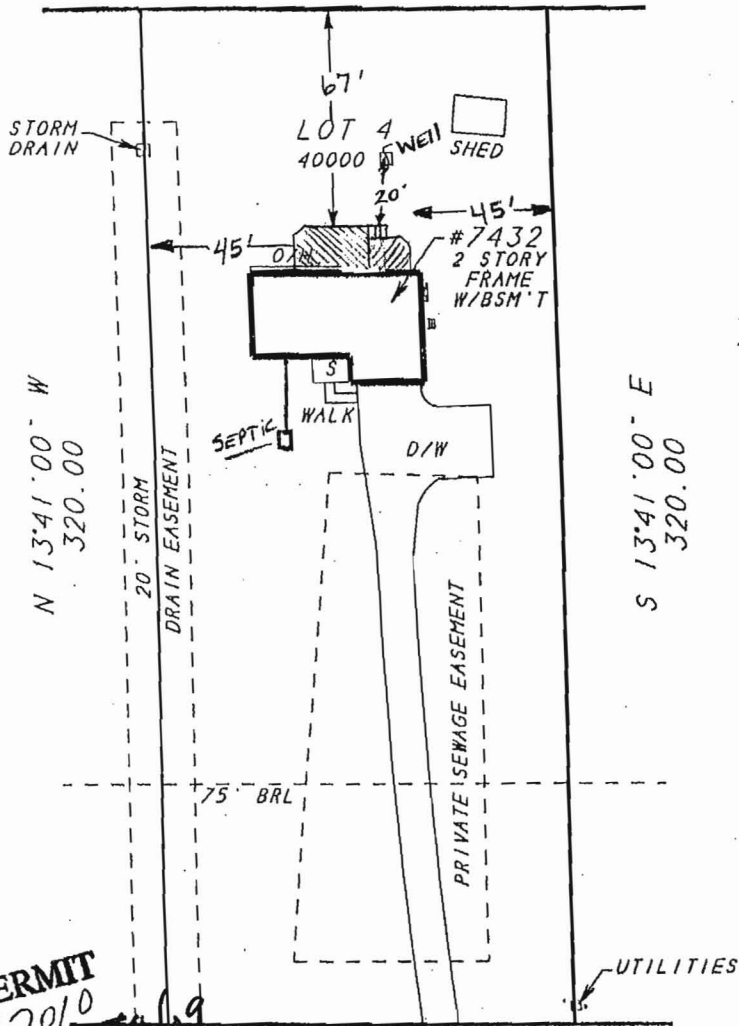

APPROVED
WALK-THRU BUILDING PERMIT
 APP. SAN SS
 DESC. OF WORK: 14 X 36' irregular shaped deck
 A# 22010
 DATE: 7/8/09

N 76°19'00" W
125.00
FLAMEWOOD DRIVE

FOR SURVEY ORDER/APPROVAL FORMS, PRICES & MORE VISIT US AT WWW.DULEY.BIZ

LOCATION DRAWING OF:
#7432 FLAMEWOOD DRIVE
 LOT 4
 BLOCK A
FLAMEWOOD
 PLAT NO. 3610
 HOWARD COUNTY, MD
 SCALE: 1"=60' DATE: 1-9-07

A LAND SURVEYING COMPANY

DULEY AND ASSOCIATES, INC.
 SERVING D.C. & M.D.

14604 ELM STREET
 UPPER MARLBORO, MD. 20772

PHONE: 301-888-1111 FAX: 301-888-1114
 PHONE: 1-888-88-DULEY FAX: 1-888-55-DULEY

CASE # 07-07-0003Y
 FELTON
 FILE # 070053-018
 DRAWN BY: B.G.

SURVEYOR'S CERTIFICATE
 I HEREBY STATE THAT THE EXISTING VISIBLE IMPROVEMENTS ON THE ABOVE DESCRIBED PROPERTY HAS BEEN CAREFULLY ESTABLISHED BY ACCEPTED METHODS AND THAT THE IMPROVEMENTS APPEAR TO LIE WITHIN FLOOD ZONE C. A FLOOD CERTIFICATION IS RECOMMENDED TO DETERMINE THE EXACT FLOOD ELEVATION AND FLOOD ZONE. THIS SURVEY IS NOT TO BE USED OR RELIED UPON FOR THE ESTABLISHMENT OF ANY FENCE, BUILDING, OR OTHER IMPROVEMENTS. THIS PLAT DOES NOT PROVIDE FOR THE ACCURATE IDENTIFICATION OF PROPERTY BOUNDARY LINES, BUT SUCH IDENTIFICATION MAY NOT BE REQUIRED FOR THE TRANSFER OF TITLE OR SECURING FINANCING OR REFIN-