

# APPLICATION

A 24504

## SEWAGE DISPOSAL TESTING

P \_\_\_\_\_

STATE OF MARYLAND - DEPARTMENT OF HEALTH AND MENTAL HYGIENE

HOWARD COUNTY HEALTH DEPARTMENT  
ENVIRONMENTAL HEALTH SERVICES  
P. O. BOX 476, ELLICOTT CITY, MARYLAND 21043  
TELEPHONE: 465-5000, EXT. 356

DISTRICT 5

DATE 3-15-76

~~max depth of system to be installed~~

BLDG. PERMIT SIGNED  
AND RETURNED 3/6/81  
Serial #45758

TO: THE COUNTY HEALTH OFFICER  
ELLICOTT CITY, MARYLAND

I, HEREBY, APPLY FOR THE NECESSARY TEST IN ORDER TO CONSTRUCT (OR RECONSTRUCT) A SEWAGE DISPOSAL SYSTEM.

PROPERTY OWNER Henry Dryfoos, III F. G. Markin Co Inc

ADDRESS 4701 Sangamore Road, Washington, D. C. 20016 PHONE 229-5052

Lanham, Md 21081

PROPERTY LOCATION:

SUBDIVISION Flamewood LOT NO. NEW LOT 1-C  
3, Block 6

ROAD AND DESCRIPTION 7501 Flamewood Drive Includes old 1-C, 2-C, 3-C

SIZE OF LOT 56,100 TYPE BLDG. 4 bedrooms  
NUMBER OF BEDROOMS

IF NOT SINGLE RESIDENCE DESCRIBE \_\_\_\_\_

THE SYSTEM INSTALLED UNDER THIS APPLICATION IS ACCEPTABLE ONLY UNTIL PUBLIC FACILITIES BECOME AVAILABLE.

SIGNATURE OF APPLICANT Henry Dryfoos III

APPROVED BY \_\_\_\_\_ FOR \_\_\_\_\_ DATE \_\_\_\_\_  
(KIND OF SYSTEM)

REJECTED BY \_\_\_\_\_ FOR \_\_\_\_\_ DATE \_\_\_\_\_  
(KIND OF SYSTEM)


HOLD PENDING FURTHER TESTS \_\_\_\_\_ DATE \_\_\_\_\_

REASONS FOR REJECTION OR HOLDING \_\_\_\_\_

# THIS IS NOT A PERMIT

Lot 3C

0  
5  
13  
CLAY loam  
Sandy mica

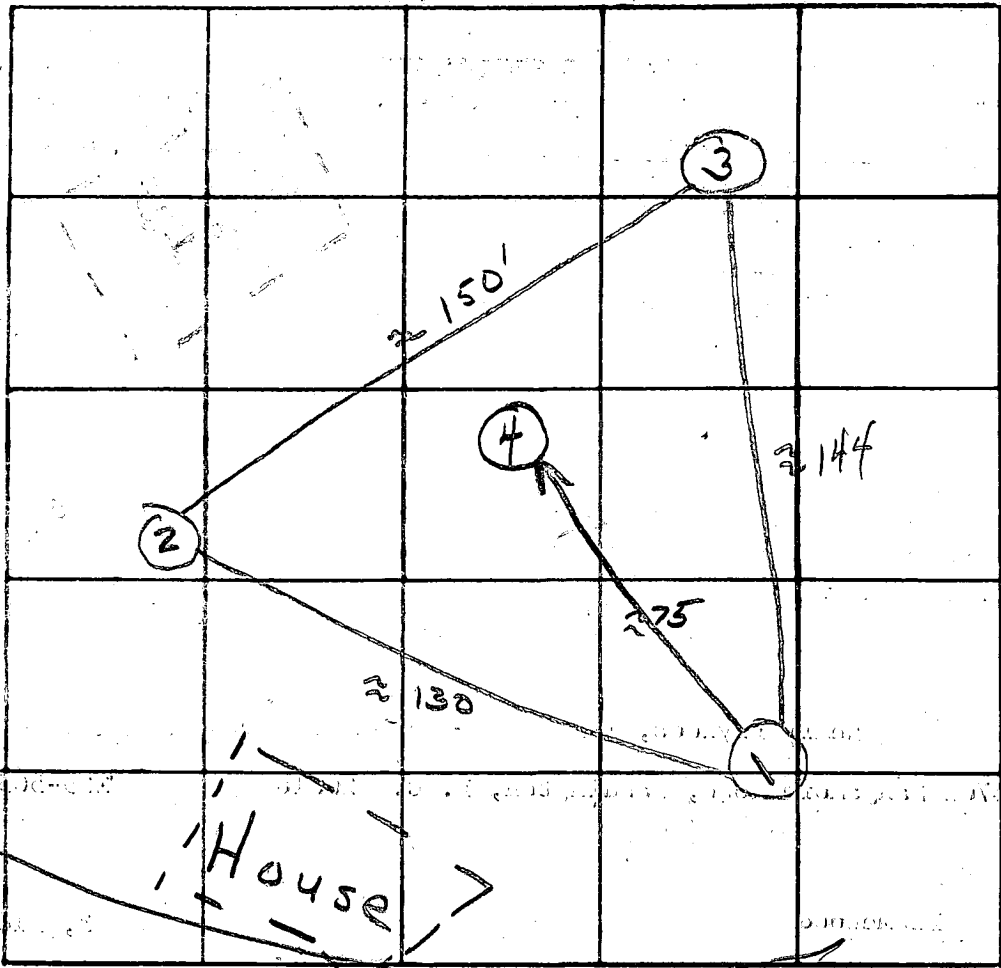

INDICATE NORTH NAME ADJOINING ROADWAY AS BASE LINE  
UNNAMED ROAD

ELEVATION

	DATE	TEST NO.	DEPTH	PRE-WET START	PRE-WET STOP	TEST - 1" DROP START	TEST - 1" DROP STOP	TIME
High EST	4-23	1S	6.5	1:53	1:56	1:56	2:00	4
	"	1D	13	1:53	1:57	1:57	2:01	4
NEXT HIGHEST	"	2V	12' SIMILAR soil - dry - clay					AT 5'
	"	3S	6.5	2:00	2:03	2:03	2:05	2
Low EST	"	3D	12	2:00	2:04	2:04	2:09	5
NEXT LOWEST	"	4S	6.5	1:57	2:05	2:05	2:22	17
		4D	13	1:57	2:01	2:01	2:07	6
	4/12/77	Hole #3 opened to 13'; dry						

REMARKS shallow system see plat for additional info

TYPE OF SOIL SANDY mica

TESTED BY Hal Jensen & RH ALSO PRESENT: Fyock & Barnes

# APPLICATION

A 24506

SEWAGE DISPOSAL TESTING

P \_\_\_\_\_

STATE OF MARYLAND - DEPARTMENT OF HEALTH AND MENTAL HYGIENE

HOWARD COUNTY HEALTH DEPARTMENT  
ENVIRONMENTAL HEALTH SERVICES

DISTRICT 5

P. O. BOX 476, ELLICOTT CITY, MARYLAND 21043  
TELEPHONE: 465-5000, EXT. 356

DATE 3-15-76

TO: THE COUNTY HEALTH OFFICER  
ELLICOTT CITY, MARYLAND

I, HEREBY, APPLY FOR THE NECESSARY TEST IN ORDER TO CONSTRUCT (OR RECONSTRUCT) A SEWAGE DISPOSAL SYSTEM.

PROPERTY OWNER Henry Dryfoos, III

ADDRESS 4701 Sangamore Road, Washington, D. C. 20016 PHONE 229-5052

PROPERTY LOCATION:

SUBDIVISION Flamewood LOT NO. 2, Block C

ROAD AND DESCRIPTION \_\_\_\_\_

SIZE OF LOT 40,000 TYPE BLDG. 4  
NUMBER OF BEDROOMS

IF NOT SINGLE RESIDENCE DESCRIBE \_\_\_\_\_

THE SYSTEM INSTALLED UNDER THIS APPLICATION IS ACCEPTABLE ONLY UNTIL PUBLIC FACILITIES BECOME AVAILABLE.

SIGNATURE OF APPLICANT Henry Dryfoos III

APPROVED BY \_\_\_\_\_ FOR \_\_\_\_\_ DATE \_\_\_\_\_  
(KIND OF SYSTEM)

REJECTED BY \_\_\_\_\_ FOR \_\_\_\_\_ DATE \_\_\_\_\_  
(KIND OF SYSTEM)

HOLD PENDING FURTHER TESTS \_\_\_\_\_ DATE \_\_\_\_\_

REASONS FOR REJECTION OR HOLDING \_\_\_\_\_

# THIS IS NOT A PERMIT

