

1/12/78

before ~~stamps~~ placed

Approved
1/12/78
7.50

P 27404
A 11006

PERMIT

SEWAGE DISPOSAL SYSTEM

MARYLAND STATE DEPARTMENT OF HEALTH*

HOWARD COUNTY

INDEXED

ELLICOTT CITY

DISTRICT 10

DATE 1/5/78

Jack Fynck IS PERMITTED TO INSTALL ALTER

ADDRESS _____ PHONE _____

DIVISION Maple Hill ROAD 12975 Byefield Drive LOT 22

PROPERTY OWNER Richard Caruso

ADDRESS 1012 Hollywood Ave. Silver Spring

REQUIREMENTS

SEPTIC TANK CAPACITY 1000 GALLONS

DRAIN FIELD _____ DEPTH _____ FEET, BOTTOM AREA _____ SQ. FT.

DEEP TRENCH _____ DEPTH _____ FEET, BOTTOM AREA _____ SQ. FT.

SEEPAGE PITS _____ ABSORBENT SIDE-WALL AREA 360 SQ. FT. Total sidewall area

INLET PIPE 4 FT. BELOW ORIGINAL GRADE. MAXIMUM DEPTH 11 FT. BELOW ORIGINAL GRADE

EFFECTIVE DEPTH AT _____ FT. BELOW ORIGINAL GRADE.

LOCATE DISPOSAL AREA 75 FT. FROM front LOT LINE AND 50 FT. FROM left LOT LINE AS SHOWN WHEN FACING LOT FROM Byefield Drive

PERMIT APPROVED BY Raymond Hodges DATE 10/14/68

NEVER DO WORK UNTIL INSPECTED AND APPROVED.

NEITHER THE HOWARD COUNTY COUNCIL NOR THE HEALTH DEPARTMENT IS RESPONSIBLE FOR THE SUCCESSFUL OPERATION OF ANY SYSTEM.

NOTE: IF TRENCH IS USED CALL FOR INSPECTION BEFORE PLACING GRAVEL IN TRENCH.

NOTE: NO DRY WELL SHALL EXCEED 16 FOOT IN DIAMETER.

NOTE: ALL PIPE FROM HOUSE TO DISPOSAL AREA MUST BE CAST IRON.


PERMIT VOID AFTER THREE YEARS.

NOTE: INSTALL STAND PIPE ON SEPTIC TANK AND DRY WELL. STAND PIPES MUST BE 6 INCHES IN DIAMETER. CAST IRON, CONCRETE OR TERRAZZO ACCEPTED.

*INSTALLER IS RESPONSIBLE FOR OBTAINING FINAL APPROVAL ON THIS PERMIT.

BUDG. PERMIT SIGNED
AND RETURNED 10/14/68
Serial # 30316 -
addition

11006

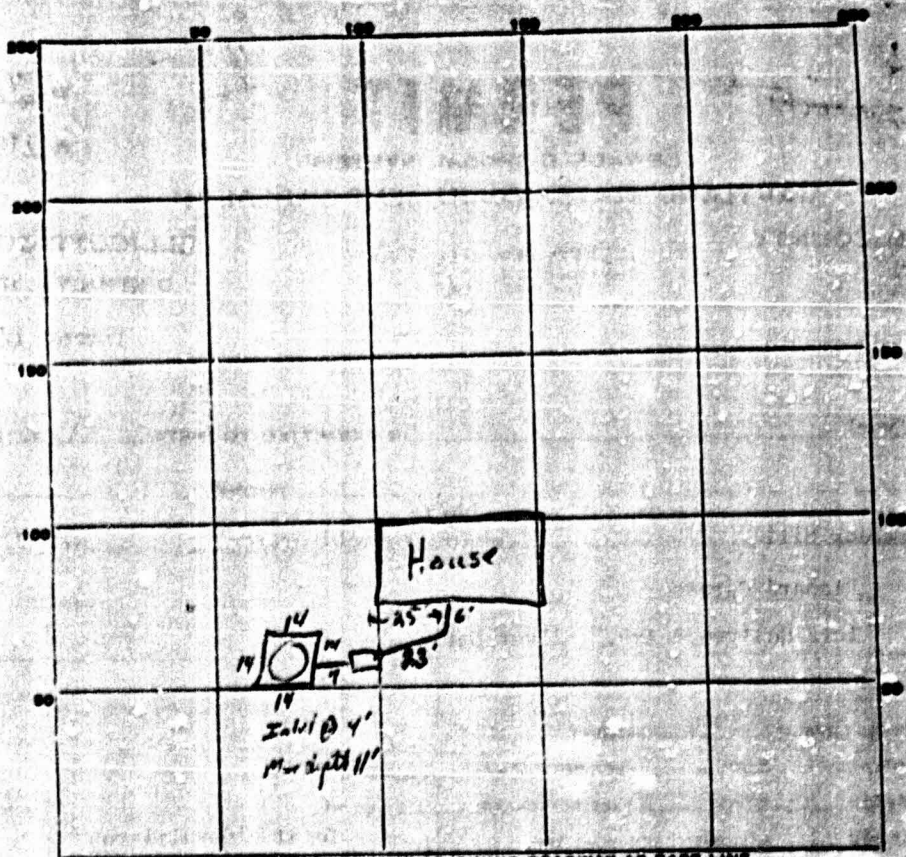

INDICATE NORTH - NAME ADJOINING ROADWAY AS BASE LINE.

Byefield

PERMIT CARD

SEPTIC TANK, LEVEL

CLEANOUTS *ST, DW*

DISTRIBUTION BOX, LEVEL _____

TILE FIELD, DEPTH _____ FT. TRENCH WIDTH _____ FT.

GRAVEL DEPTH _____ IN. TOTAL LENGTH _____ FT.

NUMBER OF TRENCHES _____ TOTAL BOTTOM AREA _____

SEEPAGE PITS, INSIDE DIAMETER 56 FT. DEPTH BELOW INLET 7 FT.

ABSORBENT AREA 392 SQ. FT.

REMARKS _____

DATE SYSTEM APPROVED 1/12/78 INSPECTOR T.S. Oyle