

APPLICATION

SEWAGE DISPOSAL TESTING

STATE OF MARYLAND - DEPARTMENT OF HEALTH AND MENTAL HYGIENE

A 34956
P _____

HOWARD COUNTY HEALTH DEPARTMENT
ENVIRONMENTAL HEALTH SERVICES

P. O. BOX 476 ELLICOTT CITY, MARYLAND 21043
TELEPHONE: 992-2330

DISTRICT _____

DATE 2/11/85

TO: THE COUNTY HEALTH OFFICER
ELLICOTT CITY, MARYLAND

I, HEREBY, APPLY FOR THE NECESSARY TEST IN ORDER TO CONSTRUCT (OR RECONSTRUCT) A SEWAGE DISPOSAL SYSTEM.

PROPERTY OWNER Dick Myers

ADDRESS _____ PHONE Don Reuwer - 531-6455

PROPERTY LOCATION:

SUBDIVISION Warfield Property LOT NO. 6

ROAD AND DESCRIPTION Ten Oaks Road

SIZE OF LOT 20 Acres TYPE BLDG. 3 or 4 Bedrooms
(NUMBER OF BEDROOMS)

THE SYSTEM INSTALLED UNDER THIS APPLICATION IS ACCEPTABLE ONLY UNTIL PUBLIC FACILITIES BECOME AVAILABLE. I FULLY UNDERSTAND THE FEE CONNECTED WITH THE FILING OF THIS PERC TEST APPLICATION IS NON-REFUNDABLE UNDER ANY CIRCUMSTANCES. I ALSO AGREE TO COMPLY WITH ALL M.O.S.H.A. REQUIREMENTS IN TESTING THIS LOT. /s/ Don Reuwer

(SIGNATURE OF APPLICANT)

APPROVED BY _____ FOR _____ DATE _____

REJECTED BY _____ FOR _____ DATE _____

HOLD PENDING FURTHER TESTS _____ DATE _____

REASONS FOR REJECTION OR HOLDING _____

THIS IS NOT A PERMIT

APPLICATION

3/11/85
2:50
3/7/85
9:30 AM

SEWAGE DISPOSAL TESTING

A 34956

STATE OF MARYLAND - DEPARTMENT OF HEALTH AND MENTAL HYGIENE

P _____

HOWARD COUNTY HEALTH DEPARTMENT
ENVIRONMENTAL HEALTH SERVICES

DISTRICT _____

P. O. BOX 476 ELLICOTT CITY, MARYLAND 21043
TELEPHONE: 992-2330

DATE 2/11/85

TO: THE COUNTY HEALTH OFFICER
ELLICOTT CITY, MARYLAND

I, HEREBY, APPLY FOR THE NECESSARY TEST IN ORDER TO CONSTRUCT (OR RECONSTRUCT) A SEWAGE DISPOSAL SYSTEM.

PROPERTY OWNER Dick Myers

ADDRESS 7919 DOGWOOD RD PHONE Don Reuwer - 531-6455
BALTO MD 21207 944 1701

PROPERTY LOCATION:
SUBDIVISION Kennard Warfield Property Lot already on Record LOT NO. 6

ROAD AND DESCRIPTION 4260 Ten Oaks Road Go to Ten Oaks Rd & Dayton 21036

SIZE OF LOT 20 Acres TYPE BLDG. 3 or 4 Bedrooms
(NUMBER OF BEDROOMS)

THE SYSTEM INSTALLED UNDER THIS APPLICATION IS ACCEPTABLE ONLY UNTIL PUBLIC FACILITIES BECOME AVAILABLE. I FULLY UNDERSTAND THE FEE CONNECTED WITH THE FILING OF THIS PERC TEST APPLICATION IS NON-REFUNDABLE UNDER ANY CIRCUMSTANCES. I ALSO AGREE TO COMPLY WITH ALL M.O.S.H.A. REQUIREMENTS IN TESTING THIS LOT. /s/ Don Reuwer
(SIGNATURE OF APPLICANT)

APPROVED BY C. Will FOR TRENCHES DATE 4/16/85



REJECTED BY _____ FOR _____ DATE 4/16/85 - SFD

HOLD PENDING FURTHER TESTS _____ DATE _____


REASONS FOR REJECTION OR HOLDING 3/7/85 PERC OK. HOLD FOR CERTIFIED HOLE PLAN
MUST WRITE LETTER TO OWNER R11

THIS IS NOT A PERMIT

WORK

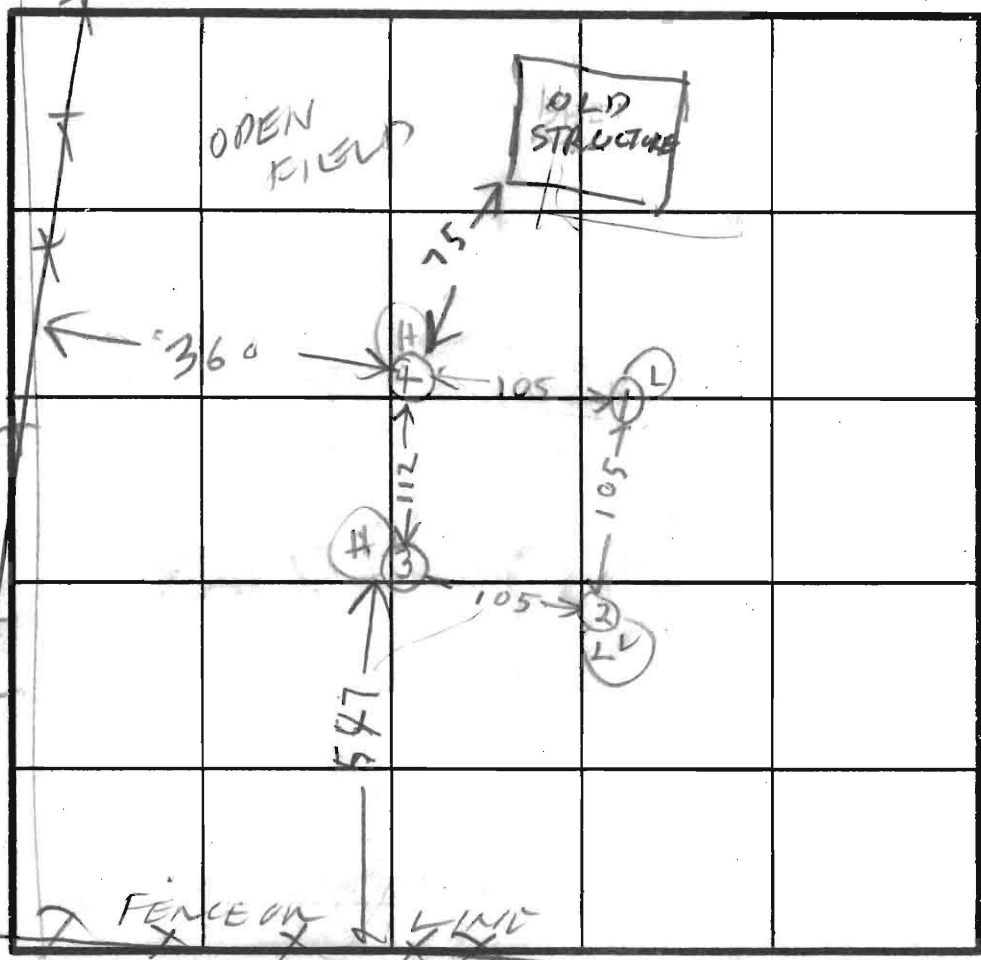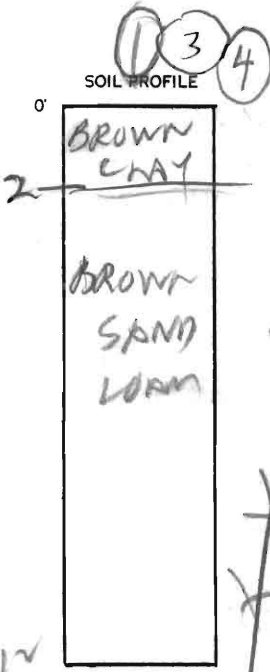

INDICATE NORTH - NAME ADJOINING ROADWAY AS BASE LINE.

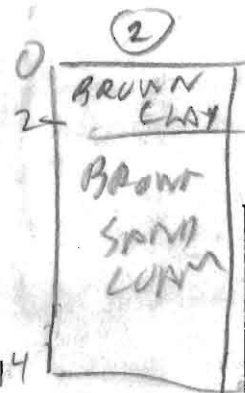

DATE	TEST NO.	DEPTH	PRE-WET		TEST - 1" DROP		TIME
			START	STOP	START	STOP	
3/7/85	1 S	4	1018	1025	1025	1033	8
	1 V	12 1/2	LOOKS	OK			
	2 S	4	1020	1022	1022	1025	3
	2 V	14	LOOKS	OK			
	3 S	4	1028	1032	1032	1037	5
	3 V	12	LOOKS	OK			
	4 S	3 1/2	LOOKS	OK			
	4 V	12 1/2					

REMARKS ACCESS FROM LINTHICUM RD

TYPE OF SOIL _____

TESTED BY RAY HODGES

ALSO PRESENT D. MYERS
POP KETTERMAN