

PUBLIC SEWER STATUS VERIFIED \_\_\_\_\_

ISSUE DATE: 5-10-12

# PERMIT

P 537299

APPROVAL DATE: 6/13/2012

A REPAIR

## Minor Septic Repair ON-SITE SEWAGE DISPOSAL SYSTEM HOWARD COUNTY HEALTH DEPARTMENT BUREAU OF ENVIRONMENTAL HEALTH

Do It P&H IS PERMITTED TO INSTALL  ALTER

ADDRESS: \_\_\_\_\_ PHONE NUMBER: \_\_\_\_\_

SUBDIVISION: Carroll Mill LOT NUMBER: 2

ADDRESS: 12270 Carroll Mill Rd PROPERTY OWNER: Richard Urian

SEPTIC TANK CAPACITY (GALLONS): Ex.

PUMP CHAMBER CAPACITY (GALLONS): N/A

NUMBER OF BEDROOMS: 0

SQUARE FEET OF HOUSE: ~1,250

LINEAR FEET OF TRENCH REQUIRED: N/A


LOCATION:	Tie in plumbing for ex. "carriage house" into ex. septic tank.
PURPOSE:	The existing septic tank and drywell must be exposed and evaluated at the time of inspection. Further repairs or upgrades may be necessary based on the condition of the ex. system. A soil profile near the ex. drywell may also be required by the sanitarian.

PLANS APPROVED: HS/JW DATE: 5/10/2012

- NOTE: PERMIT VOID AFTER 2 YEARS
- NOTE: CONTRACTOR RESPONSIBLE FOR SCHEDULING A PRE-CONSTRUCTION INSPECTION FOR ALL INSTALLATIONS
- NOTE: WATERTIGHT SEPTIC TANKS REQUIRED
- NOTE: ALL PARTS OF SEPTIC SYSTEM SHALL BE 100 FEET FROM ANY WATER WELL
- NOTE: MANHOLE RISERS REQUIRED ON ALL SEPTIC TANKS AND PUMP CHAMBERS
- NOTE: AN ELECTRICAL PERMIT IS REQUIRED FOR INSTALLATION OF ANY ELECTRICAL COMPONENTS OF THE SYSTEM

**NEITHER THE HOWARD COUNTY COUNCIL OR THE HEALTH DEPARTMENT IS RESPONSIBLE FOR THE SUCCESSFUL OPERATION OF ANY SYSTEM PERMITTEE RESPONSIBLE FOR OBTAINING FINAL APPROVAL ON THIS PERMIT CALL 410-313-1771 FOR INSPECTION OF SEPTIC SYSTEM**

NOT TO SCALE

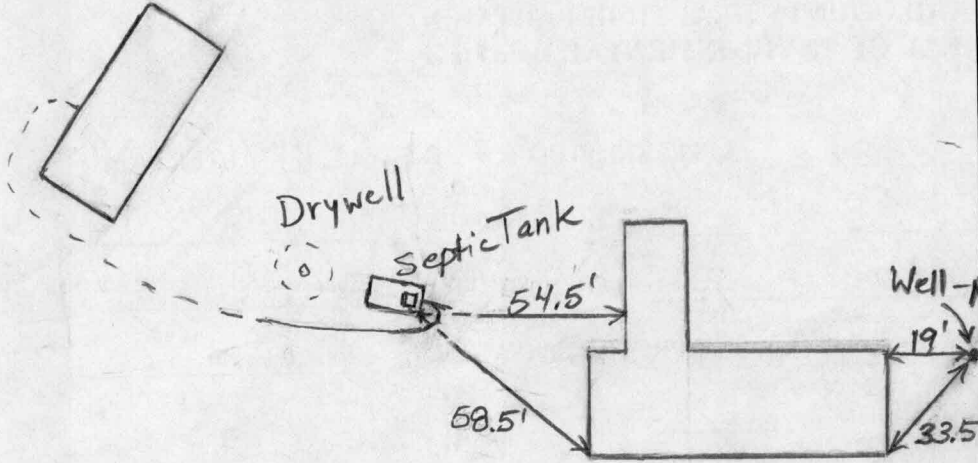

ROAD NAME

**TRENCH/DRAINFIELD DATA**

WIDTH \_\_\_\_\_ INLET \_\_\_\_\_ BOTTOM \_\_\_\_\_

NUMBER OF TRENCHES \_\_\_\_\_

TOTAL LENGTH \_\_\_\_\_

ABSORPTION AREA \_\_\_\_\_

DISTRIBUTION BOX LEVEL \_\_\_\_\_

DISTRIBUTION BOX BAFFLE \_\_\_\_\_

DISTRIBUTION BOX PORT \_\_\_\_\_

**SEPTIC TANK DATA**

**SEPTIC TANK 1 LEVEL** \_\_\_\_\_

MANUFACTURER \_\_\_\_\_

CAPACITY \_\_\_\_\_ GAL

SEAM LOC \_\_\_\_\_

TANK LID DEPTH \_\_\_\_\_

BAFFLES \_\_\_\_\_

BAFFLE FILTER \_\_\_\_\_

MANHOLE LOC \_\_\_\_\_

6" PORT LOC \_\_\_\_\_

WATERTIGHT TEST \_\_\_\_\_

SLOTTED \_\_\_\_\_

DATE ON LID \_\_\_\_\_

**PUMP/SEPTIC TANK LEVEL** \_\_\_\_\_

MANUFACTURER \_\_\_\_\_

CAPACITY \_\_\_\_\_ GAL

SEAM LOC \_\_\_\_\_

TANK LID DEPTH \_\_\_\_\_

BAFFLES \_\_\_\_\_

BAFFLE FILTER \_\_\_\_\_

MANHOLE LOC \_\_\_\_\_

6" PORT LOC \_\_\_\_\_

WATERTIGHT TEST \_\_\_\_\_

SLOTTED \_\_\_\_\_

DATE ON LID \_\_\_\_\_

PRE-CONSTRUCTION:

\_\_\_\_\_

\_\_\_\_\_

\_\_\_\_\_

\_\_\_\_\_

INSTALLATION: 6/1/2012 Pump line for accessory structure is connected to existing septic system. (BB)


\_\_\_\_\_

\_\_\_\_\_

\_\_\_\_\_

\_\_\_\_\_

FINAL INSPECTOR B. Baber DATE OF APPROVAL 6/1/2012

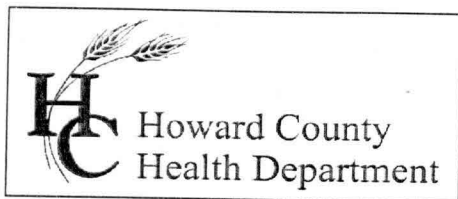

Bureau of Environmental Health  
7178 Columbia Gateway Drive, Columbia, MD 21046-2147  
(410) 313-2640 Fax (410) 313-2648  
TDD (410) 313-2323 Toll Free 1-866-313-6300  
website: www.hchealth.org

---

Peter L. Beilenson, M.D., M.P.H., Health Officer

DATE: May 3, 2012

TO: Richard And Dawn Urian, owners  
12270 Carroll Mill Road, Ellicott City, MD 21042


RE: Health Department requirements related to improvements in accessory structure

Please be advised the Health Department has requested that inspections in relation to recently permitted activities be halted at 12270 Carroll Mill Road. Investigation by the Health Department has found that plumbing, electrical and mechanical permits have been issued, apparently for improvements to an auxiliary, or accessory, building. The auxiliary building was described as a 'shed' in a year 2000 document in the Health Department file, when a Mr. Lubis owned the property. The current mechanical permit shows divisions, such as walls. Also there has not been an application for a permit associated with the wastewater discharge from the auxiliary structure even though plumbing permit has been issued by Howard County. Recent permits for porch coverings and decks indicate 'renovations' being conducted in an "existing accessory structure", i.e. the 'shed'. All active permits for your property are affected by this 'Hold on inspections', as follows: B12000719; B12000198; M12000077; P12000231; E12000051; B11001749.

The Health Department requires at this time that you submit a floor plan showing walls and fixtures that are in the existing structure at this time (May 3, 2012) and any that are planned. Also, you will need a permit from the Health Department to alter your septic system in any way, including connection of a discharge pipe from the accessory structure. Either you as the owner, or your contractor as your representative, may obtain this permit at the Health Department. A review of the proposed improvements will be conducted by the Health Department prior to release of a permit to alter the septic system.

If you have questions regarding the Health Department investigation, you may contact me at the Bureau of Environmental Health, 410-313-1771.

Respectfully,

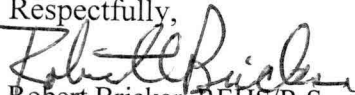  
Robert Bricker, REHS/R.S.  
Environmental Sanitarian  
Well and Septic Program

RB  
Copy: file