

# APPLICATION

A 24507

SEWAGE DISPOSAL TESTING

P \_\_\_\_\_

STATE OF MARYLAND - DEPARTMENT OF HEALTH AND MENTAL HYGIENE

HOWARD COUNTY HEALTH DEPARTMENT  
ENVIRONMENTAL HEALTH SERVICES

DISTRICT 5

P. O. BOX 476, ELLICOTT CITY, MARYLAND 21043  
TELEPHONE: 465-5000, EXT. 356

DATE 3-15-76

BLDG. PERMIT SIGNED  
AND RETURNED 3/20/81  
*Serial # 45759*

TO: THE COUNTY HEALTH OFFICER  
ELLICOTT CITY, MARYLAND

I, HEREBY, APPLY FOR THE NECESSARY TEST IN ORDER TO CONSTRUCT (OR RECONSTRUCT) A SEWAGE DISPOSAL SYSTEM.

PROPERTY OWNER Henry Dryfoos, III F. G. Marker Co. Inc

ADDRESS 4701 Sangamore Road, Washington, D. C. 20016 PHONE 229-5052 459-5386  
Lanham, Md 21081

PROPERTY LOCATION:

SUBDIVISION 7519 Flamewood Dr LOT NO. NEW LOT 2-C  
4, Block C

ROAD AND DESCRIPTION \_\_\_\_\_

SIZE OF LOT 49,025 TYPE BLDG. 4 bedrooms  
NUMBER OF BEDROOMS

IF NOT SINGLE RESIDENCE DESCRIBE \_\_\_\_\_

THE SYSTEM INSTALLED UNDER THIS APPLICATION IS ACCEPTABLE ONLY UNTIL PUBLIC FACILITIES BECOME AVAILABLE.

SIGNATURE OF APPLICANT Henry Dryfoos III



APPROVED BY William W. Jepp FOR DW E trench DATE 1/10/78  
(KIND OF SYSTEM)

REJECTED BY \_\_\_\_\_ FOR \_\_\_\_\_ DATE \_\_\_\_\_  
(KIND OF SYSTEM)

HOLD PENDING FURTHER TESTS \_\_\_\_\_ DATE \_\_\_\_\_

REASONS FOR REJECTION OR HOLDING \_\_\_\_\_

# THIS IS NOT A PERMIT

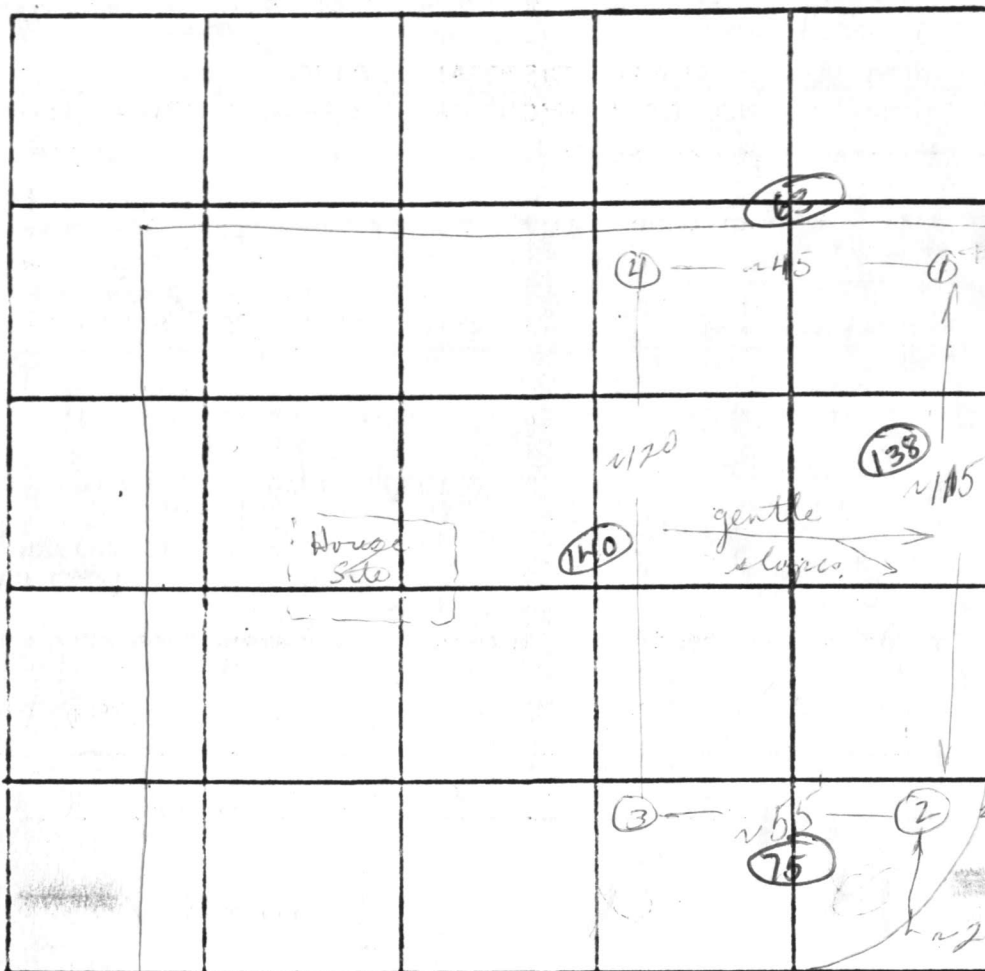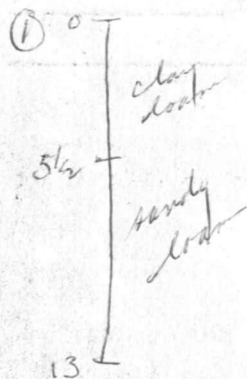

Lot 4C

INDICATE NORTH - NAME ADJOINING ROADWAY AS BASE LINE.

UNNAMED RD

DATE	TEST NO.	DEPTH	PRE-WET		TEST - 1" DROP		TIME	
			START	STOP	START	STOP		
5/5/76	1	7'	11:55	11:58	11:58	12:05	7	
	1-A	13'	11:55	12:11	12:11	12:40	29	
	2	Visual hole; good for 4'						
low	2-A	12'	12:05	12:07	12:07	12:11	4	
	3-A	6 1/2'	12:03	12:13	12:13	12:32	19	
	3-A	12 1/2'	12:03	12:06	12:06	12:15	9	
	4	6'	11:58	12:00	12:00	12:03	3	
	4-A	12'	11:58	12:05	12:05	12:21	16	

good for 5 1/2'

REMARKS

TYPE OF SOIL.

Red sandy loam

TESTED BY

WWE + AB

ALSO PRESENT:

Fyock & Co

