

APPLICATION

PERCOLATION TESTING

A 59276
P _____

HOWARD COUNTY HEALTH DEPARTMENT
BUREAU OF ENVIRONMENTAL HEALTH
PO BOX 476 ELLICOTT CITY, MARYLAND 21043
TELEPHONE 461-9933

DISTRICT _____
DATE 12/19/97

TO: THE COUNTY HEALTH OFFICER
ELLICOTT CITY, MARYLAND

I, HEREBY, APPLY FOR THE NECESSARY TEST IN ORDER TO CONSTRUCT (OR RECONSTRUCT) A SEWAGE DISPOSAL SYSTEM.

PROPERTY OWNER Bruce A. Manger

ADDRESS 2719 St. Paul Street, Baltimore, MD 21218 PHONE 410-467-9700

PROSPECTIVE BUYER Heritage Land Development

ADDRESS 3243 Bethany Lane, Ellicott City, MD 21042 PHONE 410-313-8808

PROPERTY LOCATION:

SUBDIVISION Peacefields LOT NO 10

ROAD AND DESCRIPTION MD Route 97

TAX MAP 21 PARCEL # 63

SIZE OF LOT 1 Acre ± TYPE BLDG S. F. D.
(SINGLE FAMILY DWELLING OR COMMERCIAL)

THE SYSTEM INSTALLED UNDER THIS APPLICATION IS ACCEPTABLE ONLY UNTIL PUBLIC FACILITIES BECOME AVAILABLE. I FULLY UNDERSTAND THE FEE CONNECTED WITH THE FILING OF THIS PERC TEST APPLICATION IS NON-REFUNDABLE UNDER ANY CIRCUMSTANCES. I ALSO AGREE TO COMPLY WITH ALL M.O.S.H.A. REQUIREMENTS IN TESTING THIS LOT.

[Signature]
(SIGNATURE OF APPLICANT)

APPROVED BY _____ FOR _____ DATE _____

REJECTED BY _____ FOR _____ DATE _____

HOLD PENDING FURTHER TESTS _____ DATE _____

REASONS FOR REJECTION OR HOLDING _____

HD-216

THIS IS NOT A PERMIT

COUNTY #

SOIL PROFILE

334

0' dull orange brown CILM
 3.0 lgt or tan powdery SiSalm 50% Rx

332

0' brn CILM
 3.0 lgt orange tan SiLm

331

no distinct clay layer
 lgt pink SiSalm

>50% pockets of rock


SOIL PROFILE

333 335

0' orange brown SiCILM
 3.0 pink SaSalm 15% rock

336

0' dark red brn SiCILM
 3.0 or tan Salm friable sub & blocky dry <50% Rx

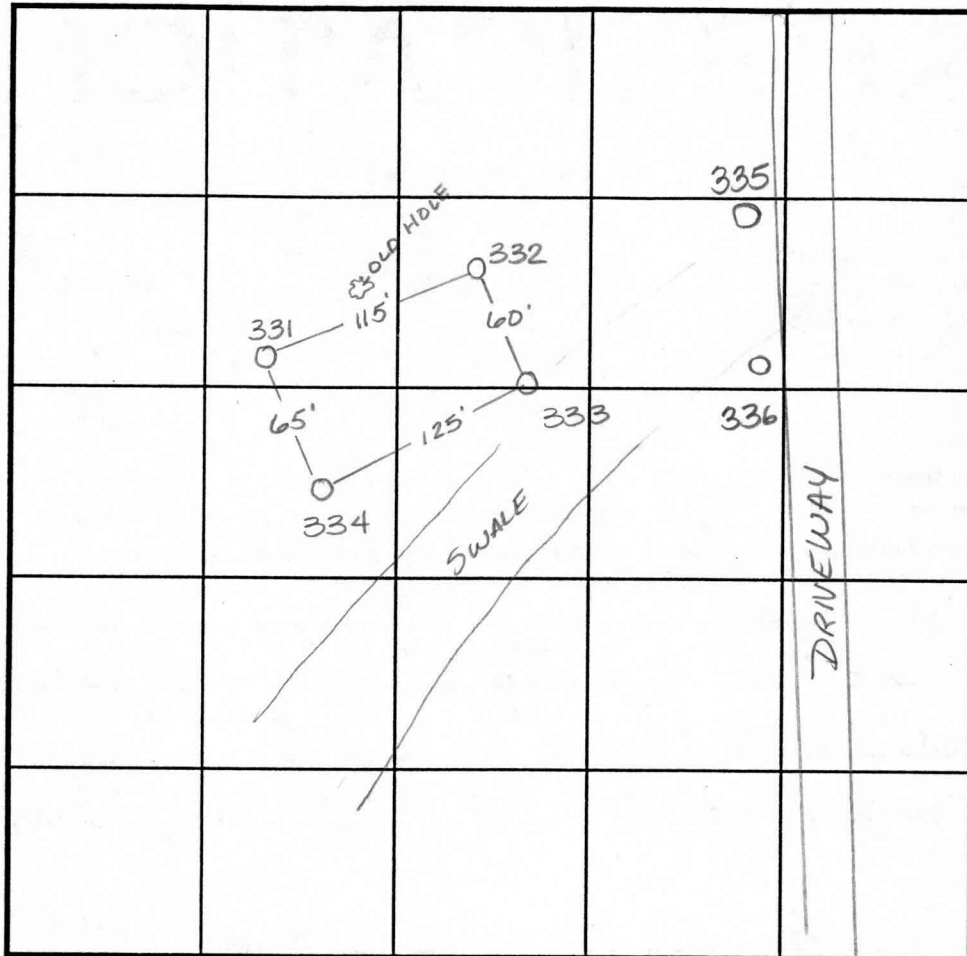

INDICATE NORTH - NAME ADJOINING ROADWAY AS BASE LINE.

DATE	TEST NO.	DEPTH	PRE-WET		TEST - 1" DROP		TIME
			START	STOP	START	STOP	
1-7-98	334	Visual	to 12.0	see profile	—	OK	
	332	3.5' / 12.0	10:45	10:46	10:46	10:47	1min
	331	Visual	to 10.0	(collapsed @ 10.0)	—	OK	
	333	3.0' / 12.0	10:56	10:57	10:57	10:59	2min
1-9-98	335	Visual	to 12.0	- see profile	—	OK	
	336	3.5' / 11.0	12:42	12:48	12:48	12:54	6min

REMARKS old hole looks rocky

TYPE OF SOIL _____

TESTED BY Amy McMillen

ALSO PRESENT Tim Feaga

TRENCH DESIGN DATA: AVERAGE PERCOLATION TIME 2 min


TRENCH WIDTH 3.0


INLET DEPTH 2.5

MAXIMUM BOTTOM DEPTH 4.5

SQ. FT./BEDROOM 180

Signed Perc Cert
11-6-98

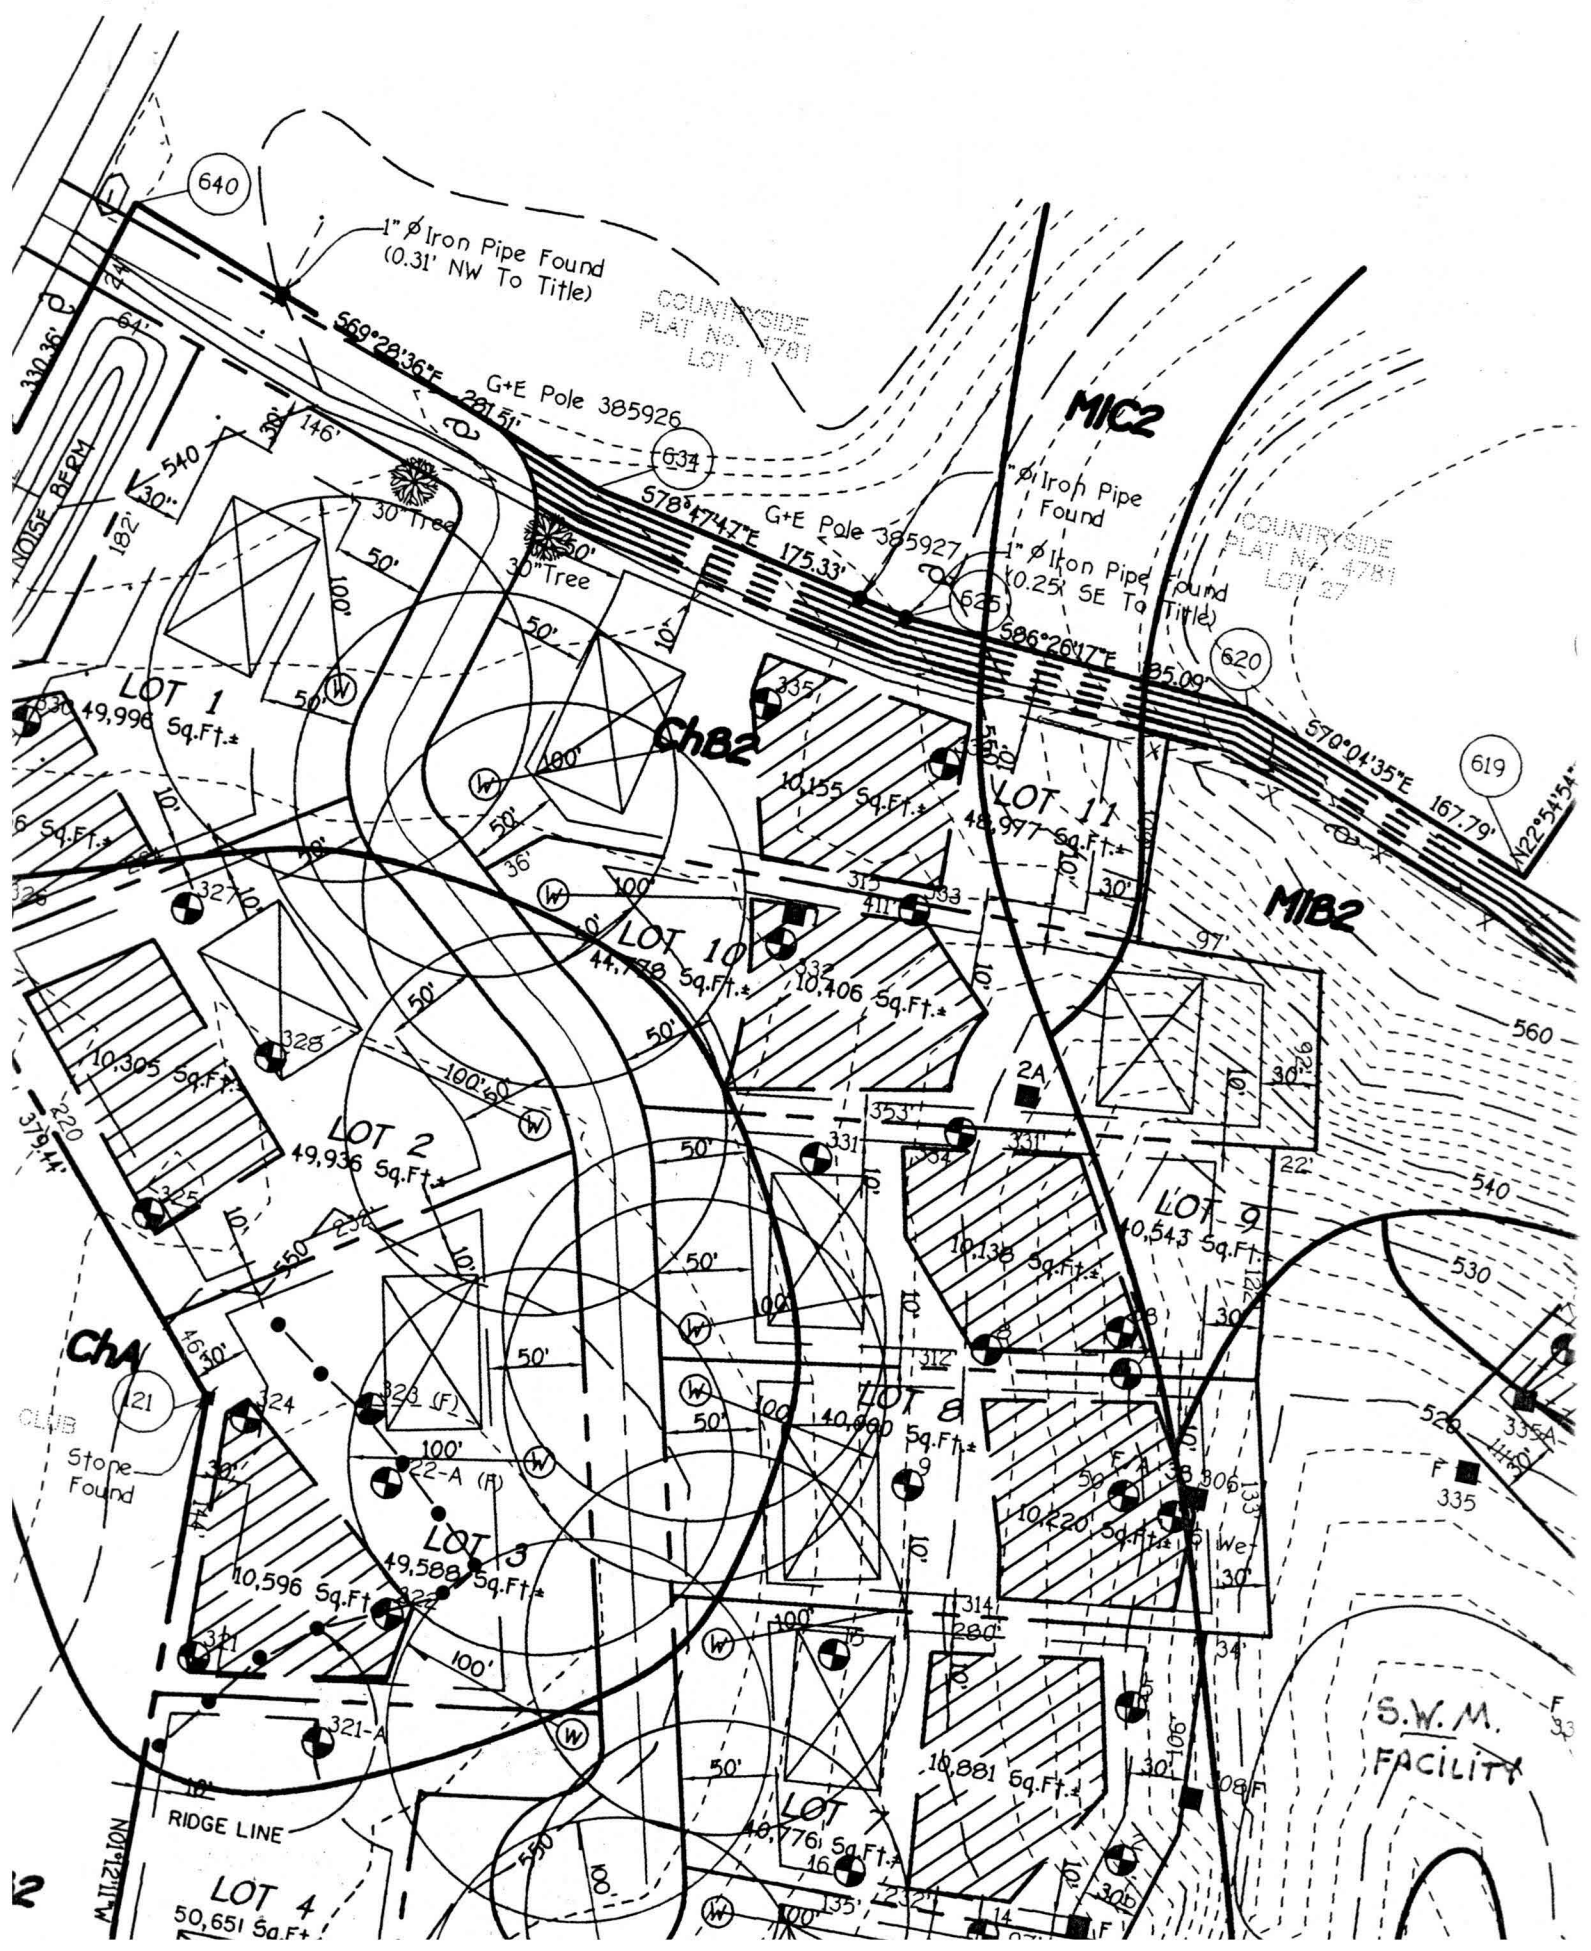

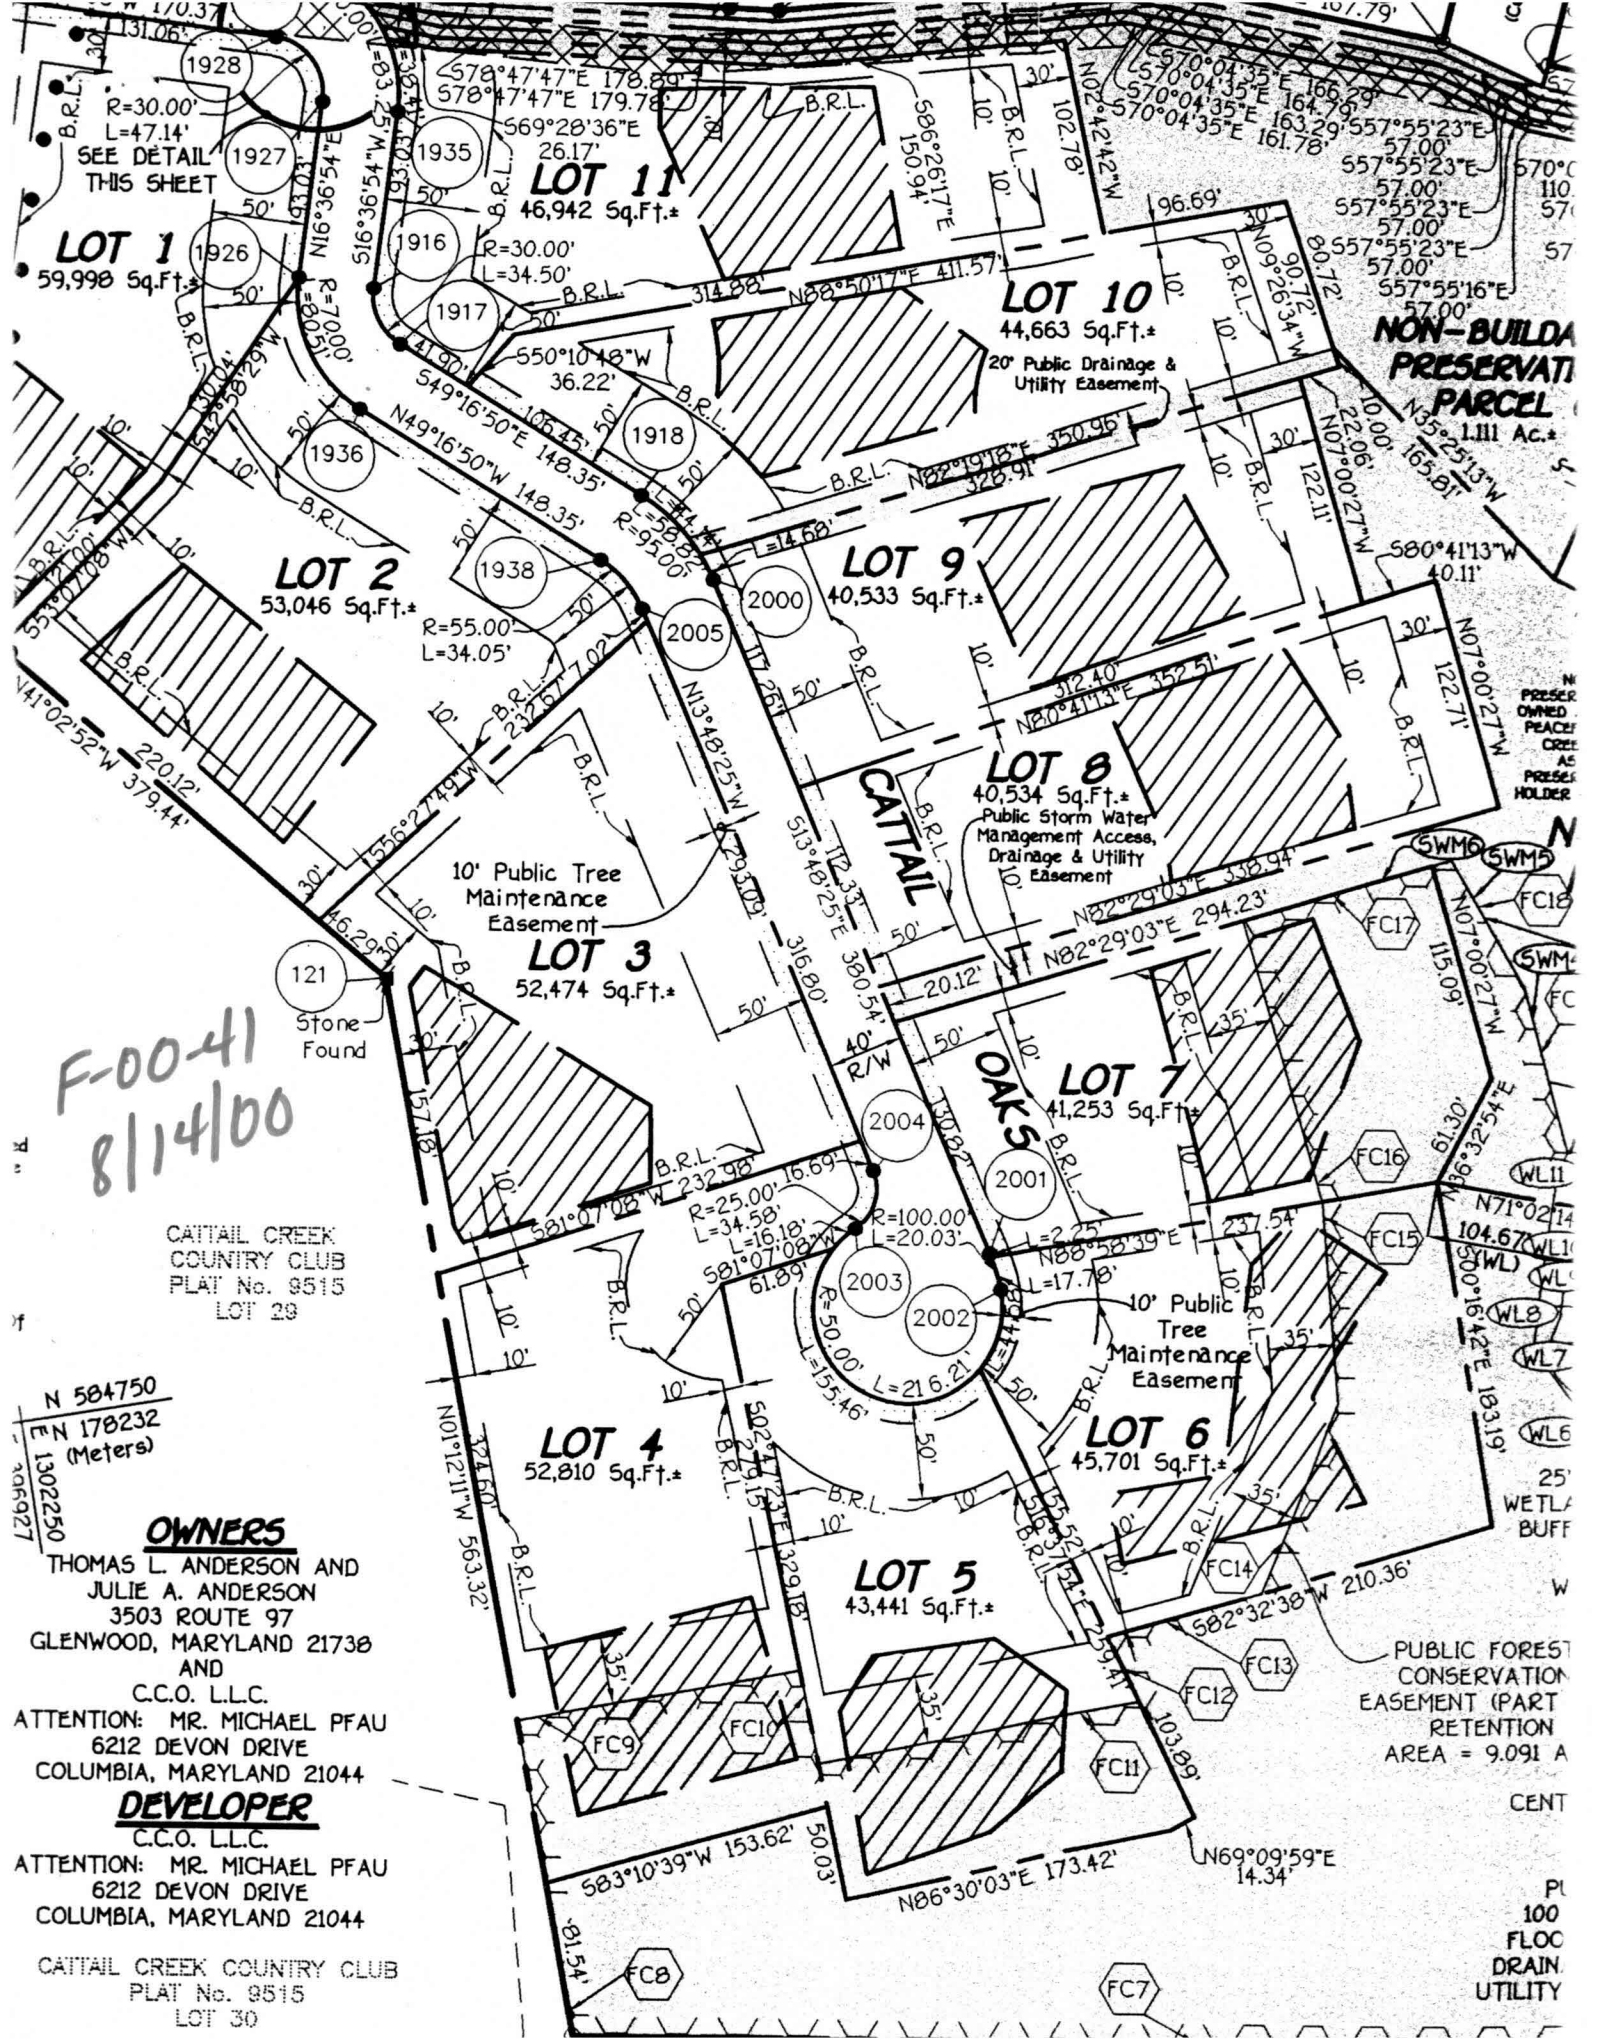

NON-BUILDABLE PRESERVATION PARCEL
1.11 Ac.*

IN
PRESER
OWNED
PEACE
ORRE
AS
PRESER
HOLDER

SWMS SWMS

FC18

SWM

FC

FC17

FC16

FC15

FC14

FC13

FC12

FC11

FC10

FC9

FC8

FC7

FC6

FC5

FC4

FC3

FC2

FC1

FC0

FC-1

FC-2

FC-3

FC-253