



CLARK • FINEROCK • & SACKETT, INC.

ENGINEERS • PLANNERS • SURVEYORS

7135 MINSTREL WAY • COLUMBIA, MD 21045 • (410) 381-7500 BALT. • (301) 621-8100 WASH.


Agriculture

11. Top must m

i. silt loan used if approved topsoil & subsoils cinders, roots, & diamete

ii. as Berry ivy, this

iii. compose the rate (feet) pr distribut the soil in the f

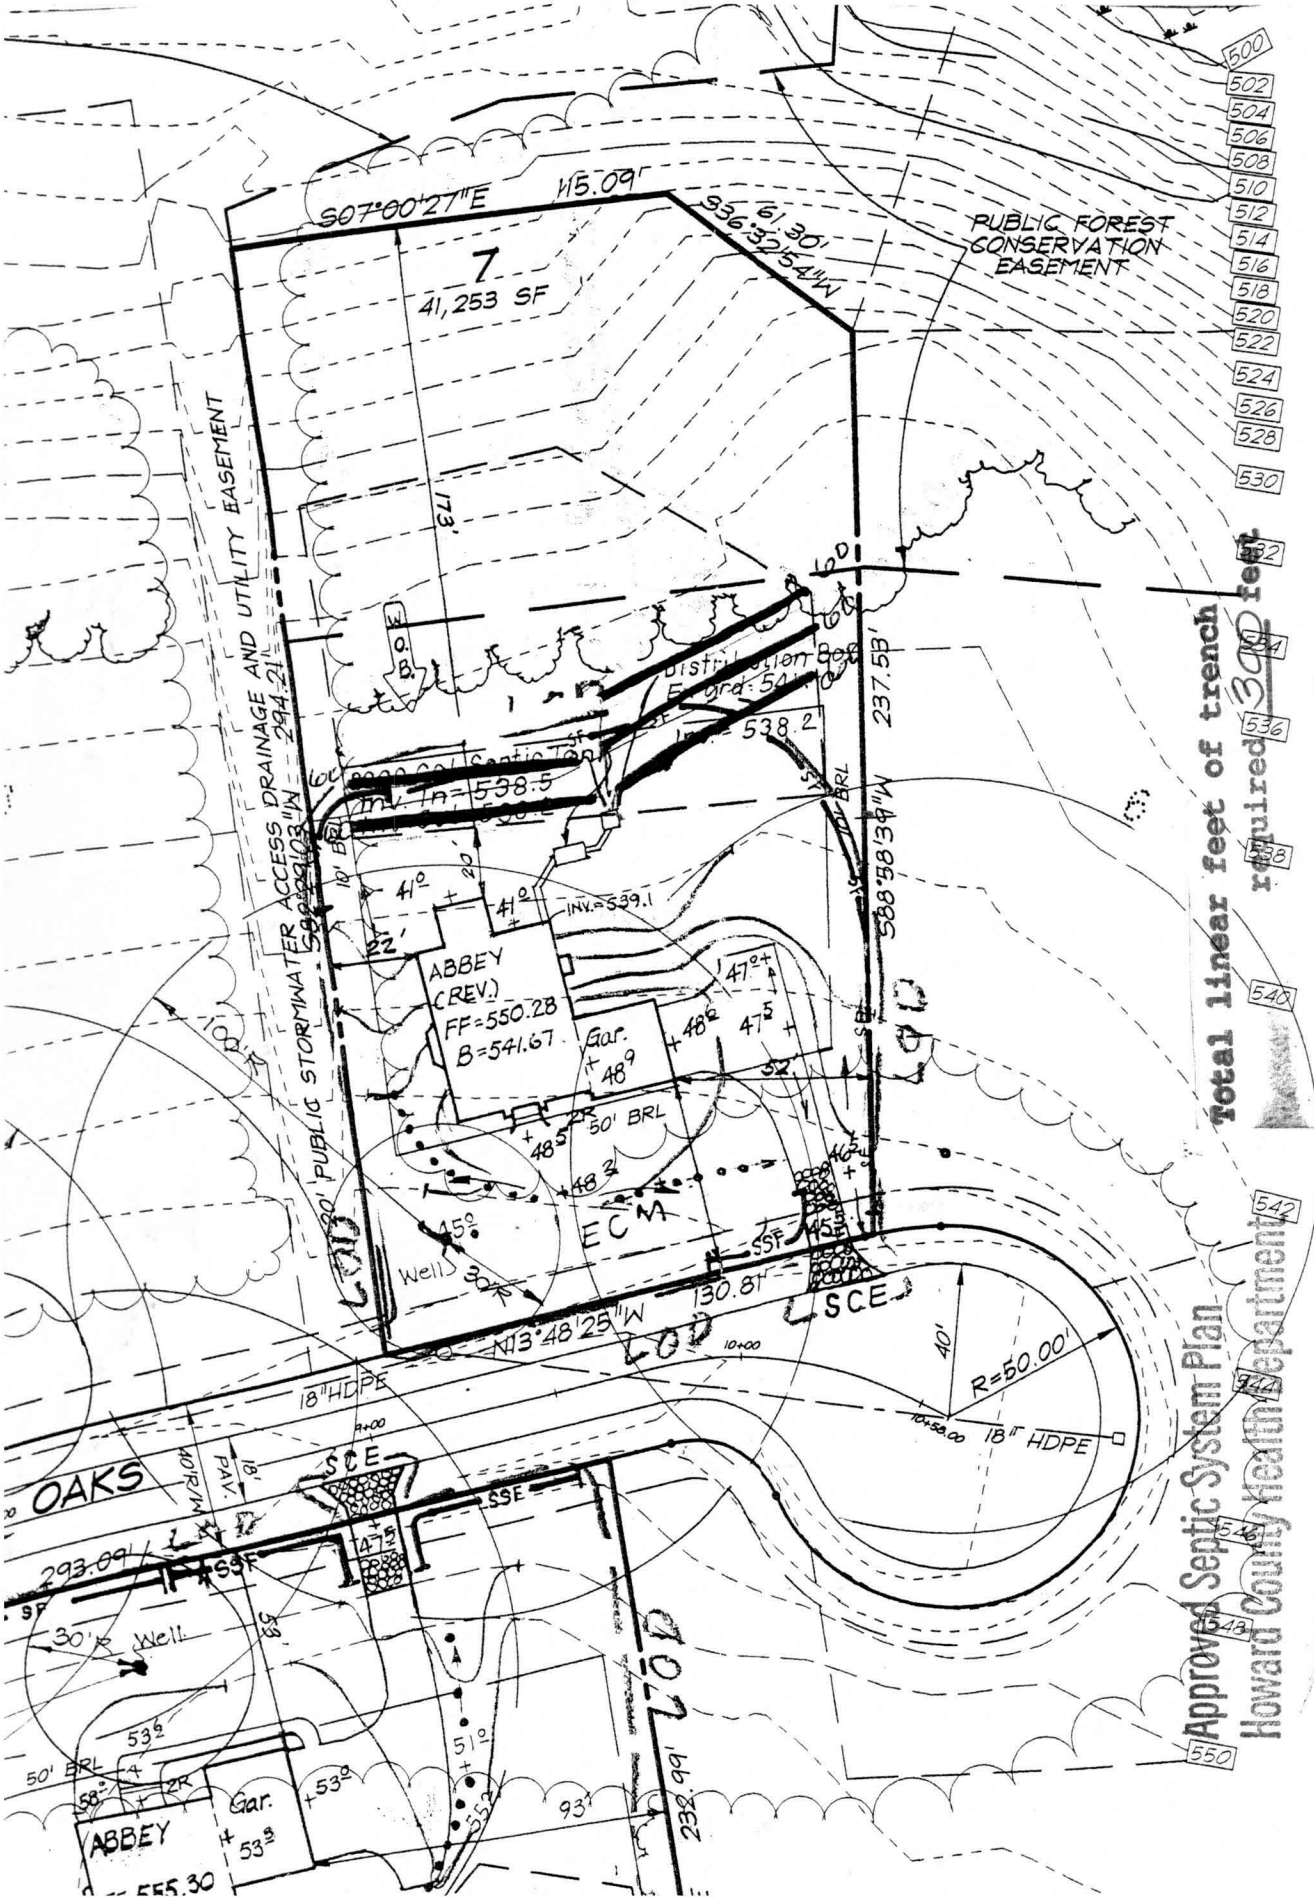

Total linear feet of trench required 390 feet

Width of trench(es) 3.0 feet

Depth of trench(es) 5.0 feet

Depth of stone required below distribution pipe 2.0 feet

Approved Septic System Plan
Howard County Health Department

[Signature]
Date 1/27/01

Signature