

PERMIT

P 515050-D

SEWAGE DISPOSAL SYSTEM HOWARD COUNTY HEALTH DEPARTMENT BUREAU OF ENVIRONMENTAL HEALTH 410-313-2640

A 59276-H

ISSUE DATE 4/17/01

APPROVAL DATE 5/14/01

5/14/01
Final
12-1

04-365135 INDEXED

SK Backhoe IS PERMITTED TO INSTALL ALTER

410 775-0562

ADDRESS 1220 Francis Scott Key Hwy, Keymar, MD 21757 PHONE ~~301-898-0955~~

SUBDIVISION Peacefields @ Cattail Creek LOT NUMBER 7 ADDRESS 15537 Cattail Oaks

PROPERTY OWNER Trinity Builders PROPERTY OWNER'S ADDRESS 7320 Grace Drive

SEPTIC TANK CAPACITY 1250 GALLONS

PUMP CHAMBER CAPACITY N/A GALLONS

NUMBER OF BEDROOMS 4

SQUARE FEET PER BEDROOM 210

LINEAR FEET OF TRENCH REQUIRED 300 (See Specification Worksheet)

TRENCHES: Trenches to be 3 feet wide. Inlet 3 feet below original grade. Bottom maximum depth 5 feet below original grade. 2 feet of stone below distribution box pipe.

LOCATION: Begin trenches 110 feet down the right lot line and 65 feet off that same lot line as seen when facing the lot from Cattail Oaks Drive. Run trenches on contour in both directions. (Install 5, 60' trenches.) 1/22/01 SK (BB)

~~ALL PERMITS MUST BE~~
~~FOR RECORD~~
B00134057 FINISH BASEMENT

PLANS APPROVED Amy McMillen, R.S. DATE 1/19/2001

PERMIT VOID AFTER 2 YEARS

NOTE: CONTRACTOR RESPONSIBLE FOR SCHEDULING A PRE-CONSTRUCTION INSPECTION FOR ALL INSTALLATIONS

NOTE: TOP OF SEPTIC TANKS ARE TO BE NO DEEPER THAN 3.0 FEET BELOW FINISH GRADE

NOTE: WATERTIGHT SEPTIC TANKS REQUIRED

NOTE: CLEANOUT REQUIRED EVERY 70 FEET OF SEWER LINE AND/OR AT 90° SWEEPS IN LINES FROM HOUSE TO DRAIN FIELDS, 90° ELBOWS ARE NOT ACCEPTABLE

NOTE: ALL PARTS OF SEPTIC SYSTEMS (I.E. TANK, DISTRIBUTION BOX, DRAINFIELDS) TO BE 100 FEET FROM ANY WATER WELL UNLESS OTHERWISE SPECIFICALLY AUTHORIZED

NOTE: NO ABSORPTION TRENCH TO EXCEED 100 FEET IN LENGTH UNLESS SPECIFICALLY AUTHORIZED

NOTE: ALL PIPE FROM HOUSE TO SEPTIC TANK MUST BE CAST IRON OR SCHEDULE 35/40 PVC OR ABS

NOTE: MANHOLE RISERS REQUIRED ON ALL SEPTIC TANKS AND PUMP CHAMBERS


NOTE: DISTRIBUTION BOXES MUST HAVE BAFFLES

NOTE: IF PUMPED SEPTIC SYSTEM REQUIRED, (1) SEPTIC PUMP DETAIL TO BE PROVIDED BY INSTALLER PRIOR TO ISSUANCE OF SEPTIC PERMIT (2) PUMP PERFORMANCE TEST IS NECESSARY PRIOR TO HEALTH DEPARTMENT APPROVAL OF SEPTIC PERMIT

NEITHER THE HOWARD COUNTY COUNCIL NOR THE HEALTH DEPARTMENT IS RESPONSIBLE FOR THE SUCCESSFUL OPERATION OF ANY SYSTEM
PERMITTEE RESPONSIBLE FOR OBTAINING FINAL APPROVAL ON THIS PERMIT
CALL 410-313-2640 FOR INSPECTION OF SEPTIC SYSTEM

P515050-D

NOT TO SCALE

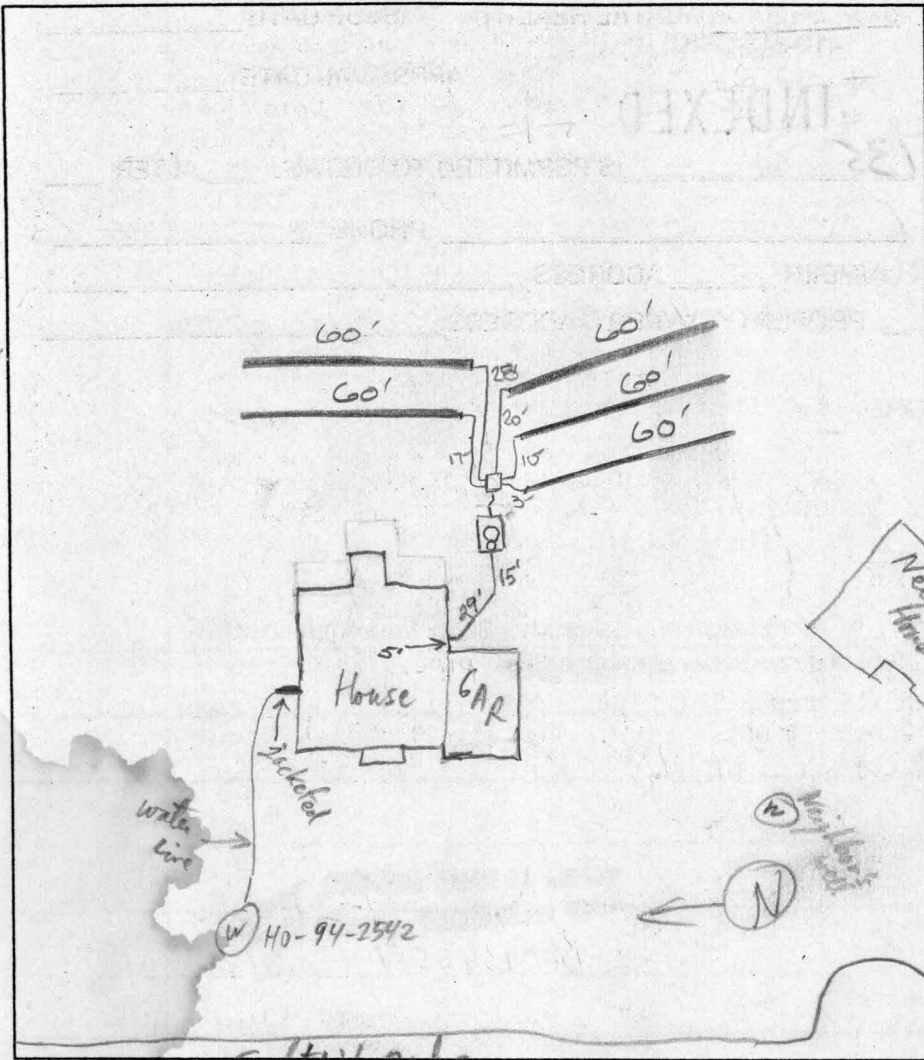

TRENCH DATA	
TRENCH WIDTH	3
TRENCH INLET DEPTH	3
TRENCH BOTTOM DEPTH	5
DEPTH OF STONE	2
NUMBER OF TRENCHES	5
TOTAL TRENCH LENGTH	300
ABSORBENT AREA	900
DISTRIBUTION BOX LEVEL	<input checked="" type="checkbox"/>
BAFFLE IN DISTRIBUTION BOX	<input checked="" type="checkbox"/>

SEPTIC TANK DATA	
SEPTIC TANK	1250 TS GALLONS
MANHOLE RISER	Yes
6 INCH INSPECTION PORT	Yes
PUMP CHAMBER DATA	
PUMP CHAMBER GALLONS	N/A
MANHOLE RISER	
ALARM	
PUMP PERFORMANCE TEST	

PRE-CONSTRUCTION INSPECTION: 5/11/01 Contractor will install as per B.P. plan, But he said he will try to keep trenches up higher to conserve area

INSPECTION COMMENTS: 5/14/01 FINAL INSP - OK to cover all work. Need cap on 6" cleardout on septic tank. DKO

INSPECTOR Donna K. [Signature] DATE SYSTEM APPROVED 5/14/01