




APPROVED

WALK-THRU BUILDING PERMIT

BP# *B0015179.2* A# *59276-G*

APP. SAN *Kaci Neenan* DATE: *1/6/05*

DESC. OF WORK: *first basement*

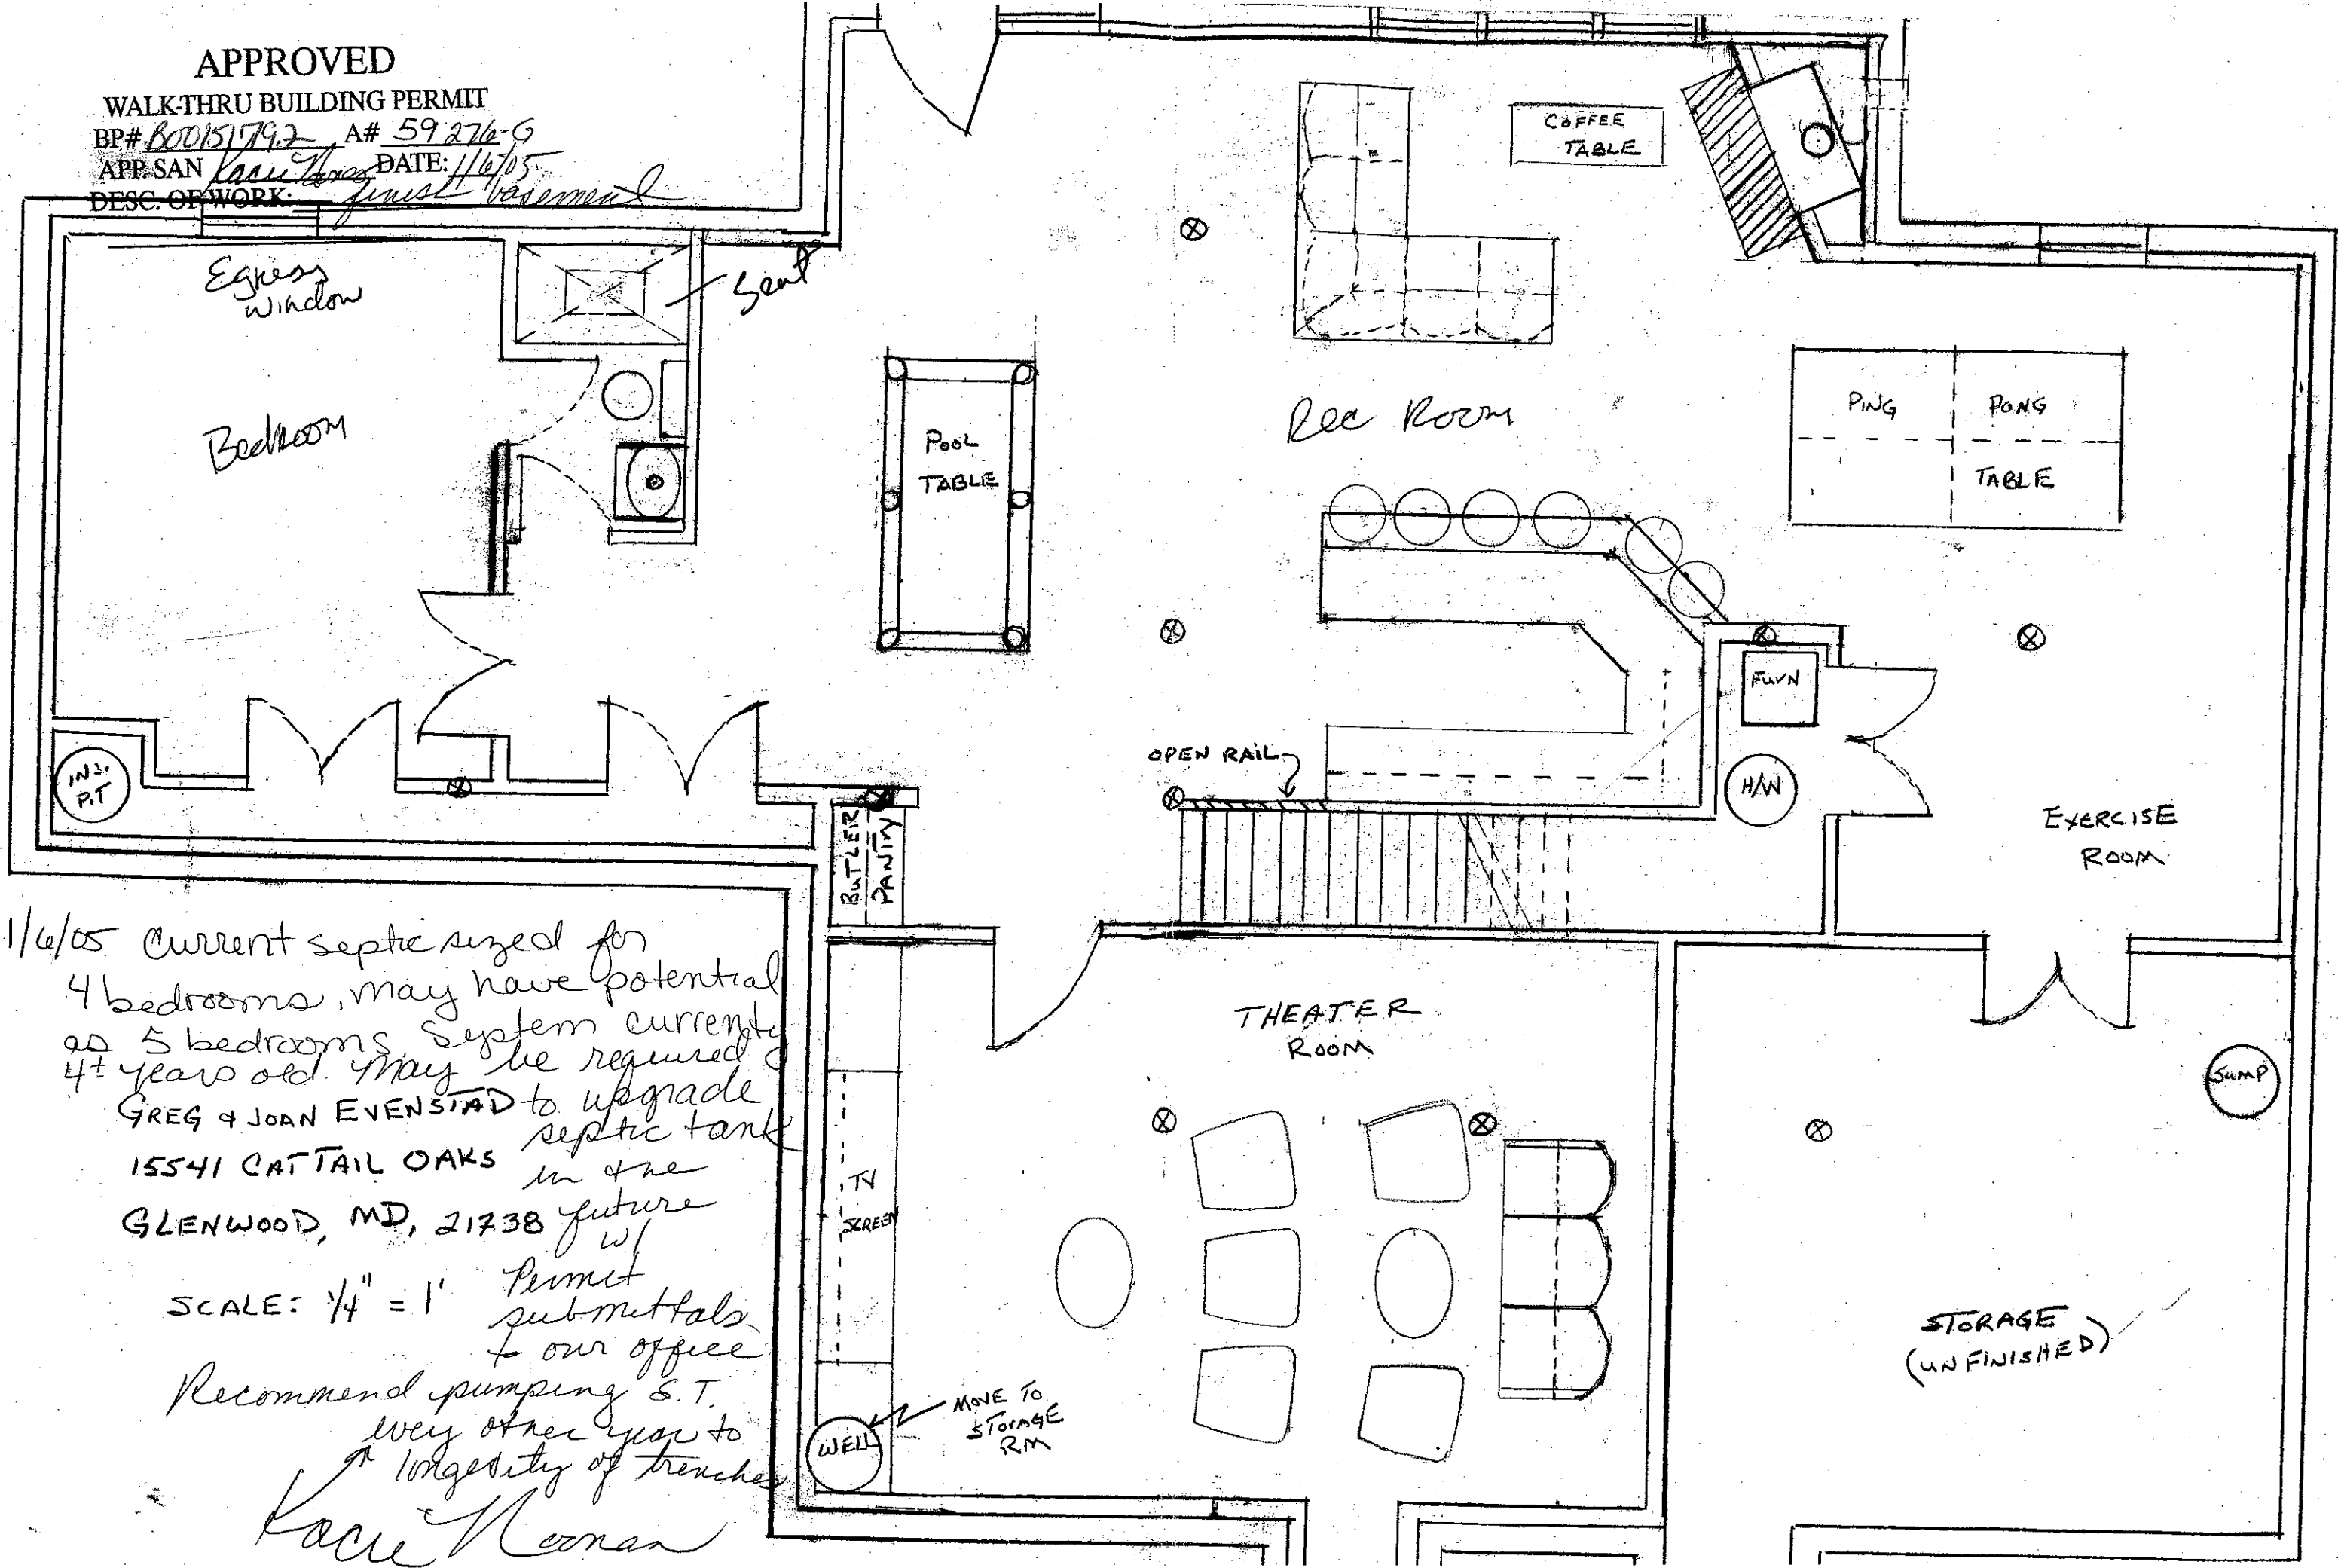

1/6/05 Current septic sized for 4 bedrooms, may have potential as 5 bedrooms. System currently 4+ year old. May be required GREG & JOAN EVENSTAD to upgrade septic tank 15541 CATTAIL OAKS in the GLENWOOD, MD, 21738 future w/

SCALE: 1/4" = 1' Permit submittals to our office

Recommend pumping S.T. every other year to longevity of trenches

*Kaci Neenan*

