

LAYOUT 9/25/09 INSP 4 10/2/09
INSP 2 9/29/09 INSP 5 10/6/09
INSP 3 10/1/09 INSP 6 _____

ISSUE DATE: 9/14/09

PERMIT

P 531853

APPROVAL DATE: 12/9/09

A 59207

**SANDMOUND SYSTEM
ON-SITE SEWAGE DISPOSAL SYSTEM
HOWARD COUNTY HEALTH DEPARTMENT
BUREAU OF ENVIRONMENTAL HEALTH
Tax ID # 04-371399**

Trinity Quality Homes IS PERMITTED TO INSTALL ALTER

ADDRESS: 3675 Park Avenue Suite 301 Ellicott City PHONE NUMBER: 410-480-0023

SUBDIVISION: The Chase @ Stoney Brooke LOT NUMBER: 15

ADDRESS: 16326 Cattail River Drive PROPERTY OWNER: Trinity Quality Homes

SEPTIC TANK CAPACITY (GALLONS): 2000 OUTLET BAFFLE FILTER REQUIRED

PUMP CHAMBER CAPACITY (GALLONS): 1000 COMPARTMENTED TANK REQUIRED

NUMBER OF BEDROOMS: 4

SIZE 600 GPD Gravel bed 9 ft by 66.7 ft

LOCATION:	Sand mound to be installed, see approved plan for location, elevations and system design details.
NOTES:	Sand mound must be staked and surrounded by a protective barrier. Keep heavy equipment off location. Layout inspection required prior to installation.


PLANS APPROVED: Sara Sappington DATE: 9/10/09

NOTES: PERMIT VOID AFTER 2 YEARS
CONTRACTOR IS RESPONSIBLE FOR SCHEDULING A PRE-CONSTRUCTION INSPECTION FOR ALL INSTALLATIONS
WATERTIGHT SEPTIC TANKS REQUIRED
ALL PARTS OF SEPTIC SYSTEM SHALL BE 100 FEET FROM ANY WATER WELL UNLESS SPECIFICALLY AUTHORIZED
MANHOLE RISERS REQUIRED ON ALL SEPTIC TANKS AND PUMP CHAMBERS UNLESS SPECIFICALLY AUTHORIZED
CONTRACTOR RESPONSIBLE FOR COMPLIANCE WITH APPLICABLE REGULATIONS, GUIDELINES AND THE TERMS OF THIS PERMIT

**NEITHER THE HOWARD COUNTY COUNCIL NOR THE HEALTH DEPARTMENT IS
RESPONSIBLE FOR THE SUCCESSFUL OPERATION OF ANY SYSTEM
PERMITTEE RESPONSIBLE FOR OBTAINING FINAL APPROVAL ON THIS PERMIT
CALL 410-313-1771 FOR INSPECTION OF SEPTIC SYSTEM**

10-95-0127

NOT TO SCALE

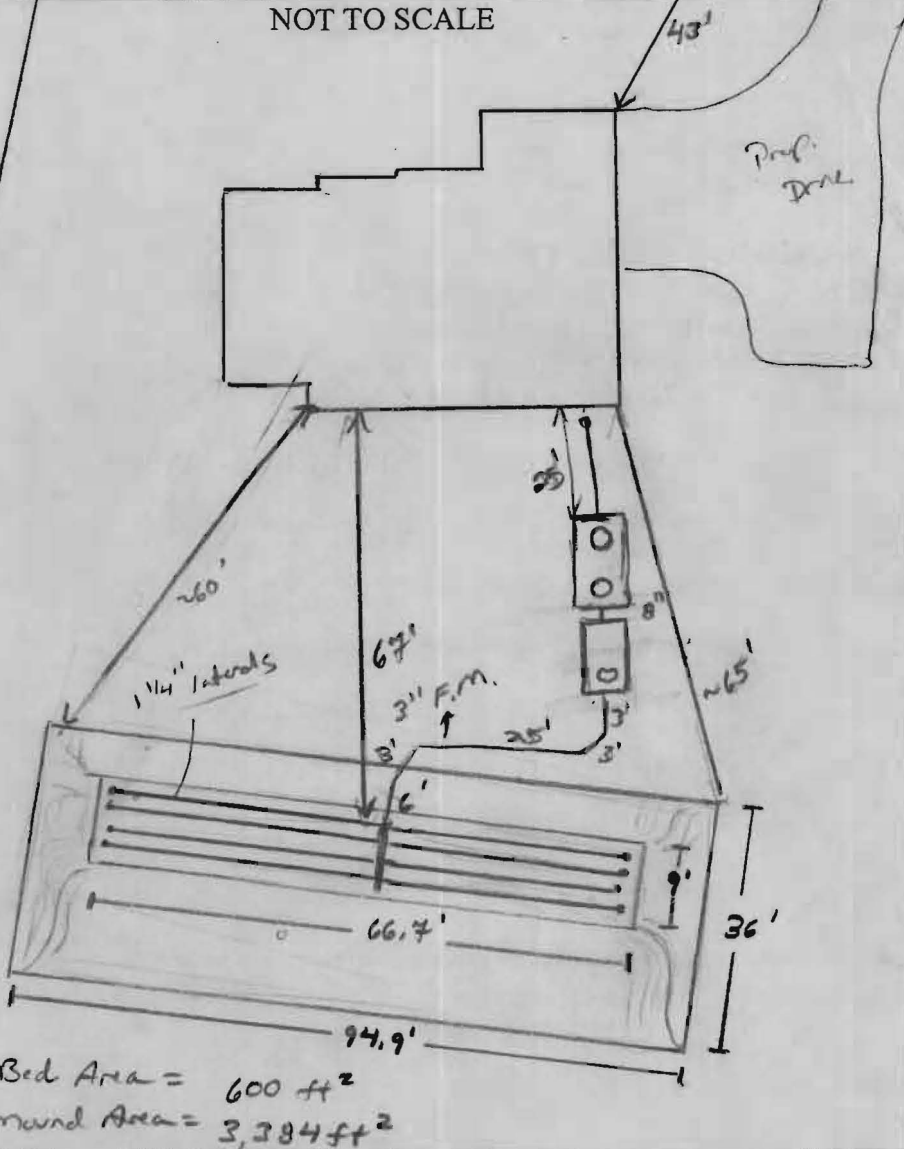

Bed Area = 600 ft²
 mound Area = 3,384 ft²

ROAD NAME

TRENCH/DRAINFIELD DATA

WIDTH	INLET	BOTTOM
_____	_____	_____
NUMBER OF TRENCHES _____		
TOTAL LENGTH _____		
ABSORPTION AREA _____		
DISTRIBUTION BOX LEVEL _____		
DISTRIBUTION BOX BAFFLE _____		
DISTRIBUTION BOX PORT _____		

SEPTIC TANK DATA

SEPTIC TANK 1 LEVEL	Yes
MANUFACTURER	Babylon
CAPACITY	2000 GAL
SEAM LOC	Top
TANK LID DEPTH	_____
BAFFLES	Yes
BAFFLE FILTER	_____
MANHOLE LOC	Front/Rear
6" PORT LOC	none
WATERTIGHT TEST	_____
SLOTTED	Yes
DATE ON LID	_____

PUMP/SEPTIC TANK LEVEL Yes

MANUFACTURER	Babylon
CAPACITY	1000 GAL
SEAM LOC	Top
TANK LID DEPTH	_____
BAFFLES	Front
BAFFLE FILTER	_____
MANHOLE LOC	Rear
6" PORT LOC	none
WATERTIGHT TEST	_____
SLOTTED	no
DATE ON LID	no

PRE-CONSTRUCTION:

9/25/09 Spoke w/ contractor on phone (Freedom Style) OK to set tanks per plan. Sand approved. 9/29/09 Layout of mound and bed given. Top of mound dead level. was off by 4". Told contractor still too wet to plan. Soil 'wires' in 5 diff spots of mound. Both tanks set. slightly off of grade plan. Told contractor to let engineer know of these changes (Kw) 10/1/09 (Kw) Had Brian (HCHD) stop out @

INSTALLATION:

side to check moisture content of soil. He said it was OK. but could wait till next week. Called contractor and told him he could plow ~10" but to cut grass first and let sit open (plowed) for a couple hours to dry out. before putting sand on (Kw) 10/2/09 mound shaped. Bed being cut. OK to continue (Kw) 10/6/09 Tanks set gravel in bed (~6") level, manifold and laterals set, pump test ran. Everything looks good. OK to cover bed w/ gravel, fabric and caps. (Kw) Need final P/A test @ 11/17/09 Attempted P/A test Alarm working. Pump not. (Kw)

FINAL INSPECTOR John Wall DATE OF APPROVAL 12/9/09
 12/9/09 Pump in pump tank pushed 1" per m.p. to get 2' discharge head. mound design calculations wrong. P/A test good. Sys complete


MARYLAND STATE GRID MERIDIAN (NAD83/91)

P/O BUILDABLE
PRESERVATION
PARCEL "A"

LOT 16

LOT 15
48,853 S.F.

LOT 14

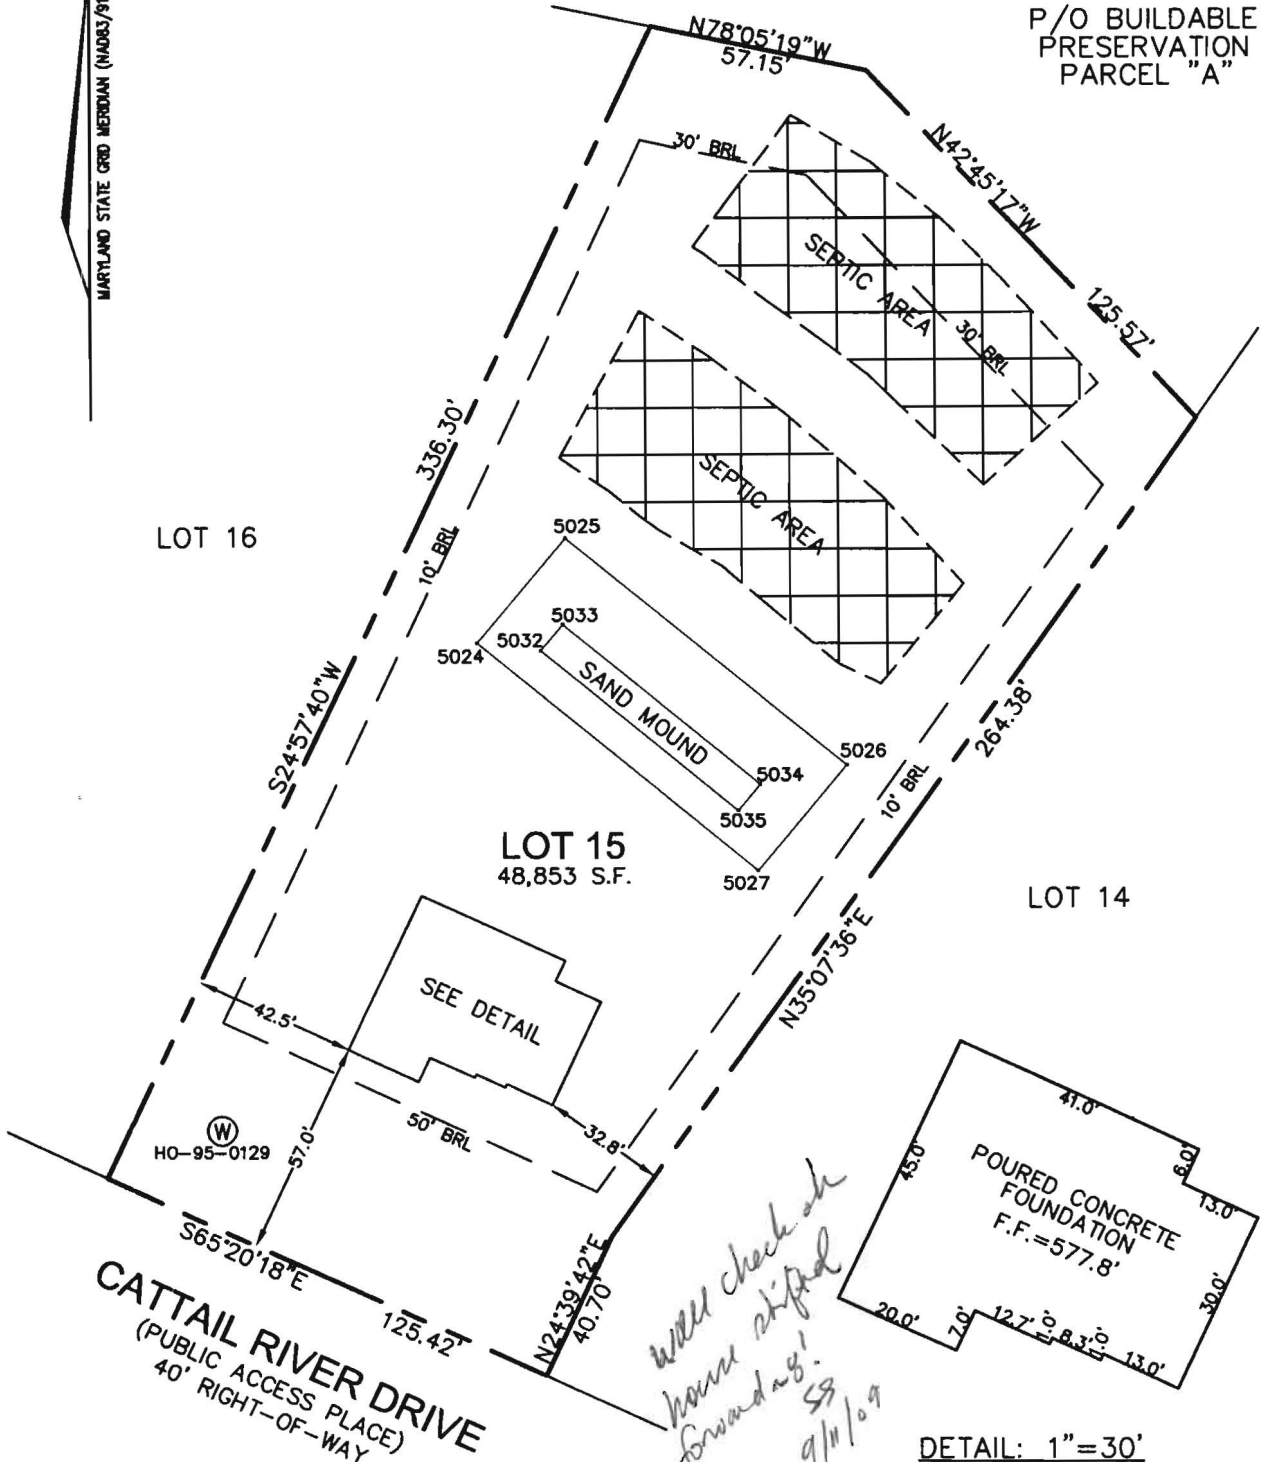

*will check sh
house digital
forward as!
9/11/09*


CATTAIL RIVER DRIVE
(PUBLIC ACCESS PLACE)
40' RIGHT-OF-WAY

DETAIL: 1" = 30'



I HEREBY CERTIFY TO THE BEST OF MY KNOWLEDGE,
INFORMATION AND BELIEF THAT THE IMPROVEMENTS ARE
LOCATED AS SHOWN AND THERE ARE NO ENCROACHMENTS

11/2009 11:10:00 RWI: cogie

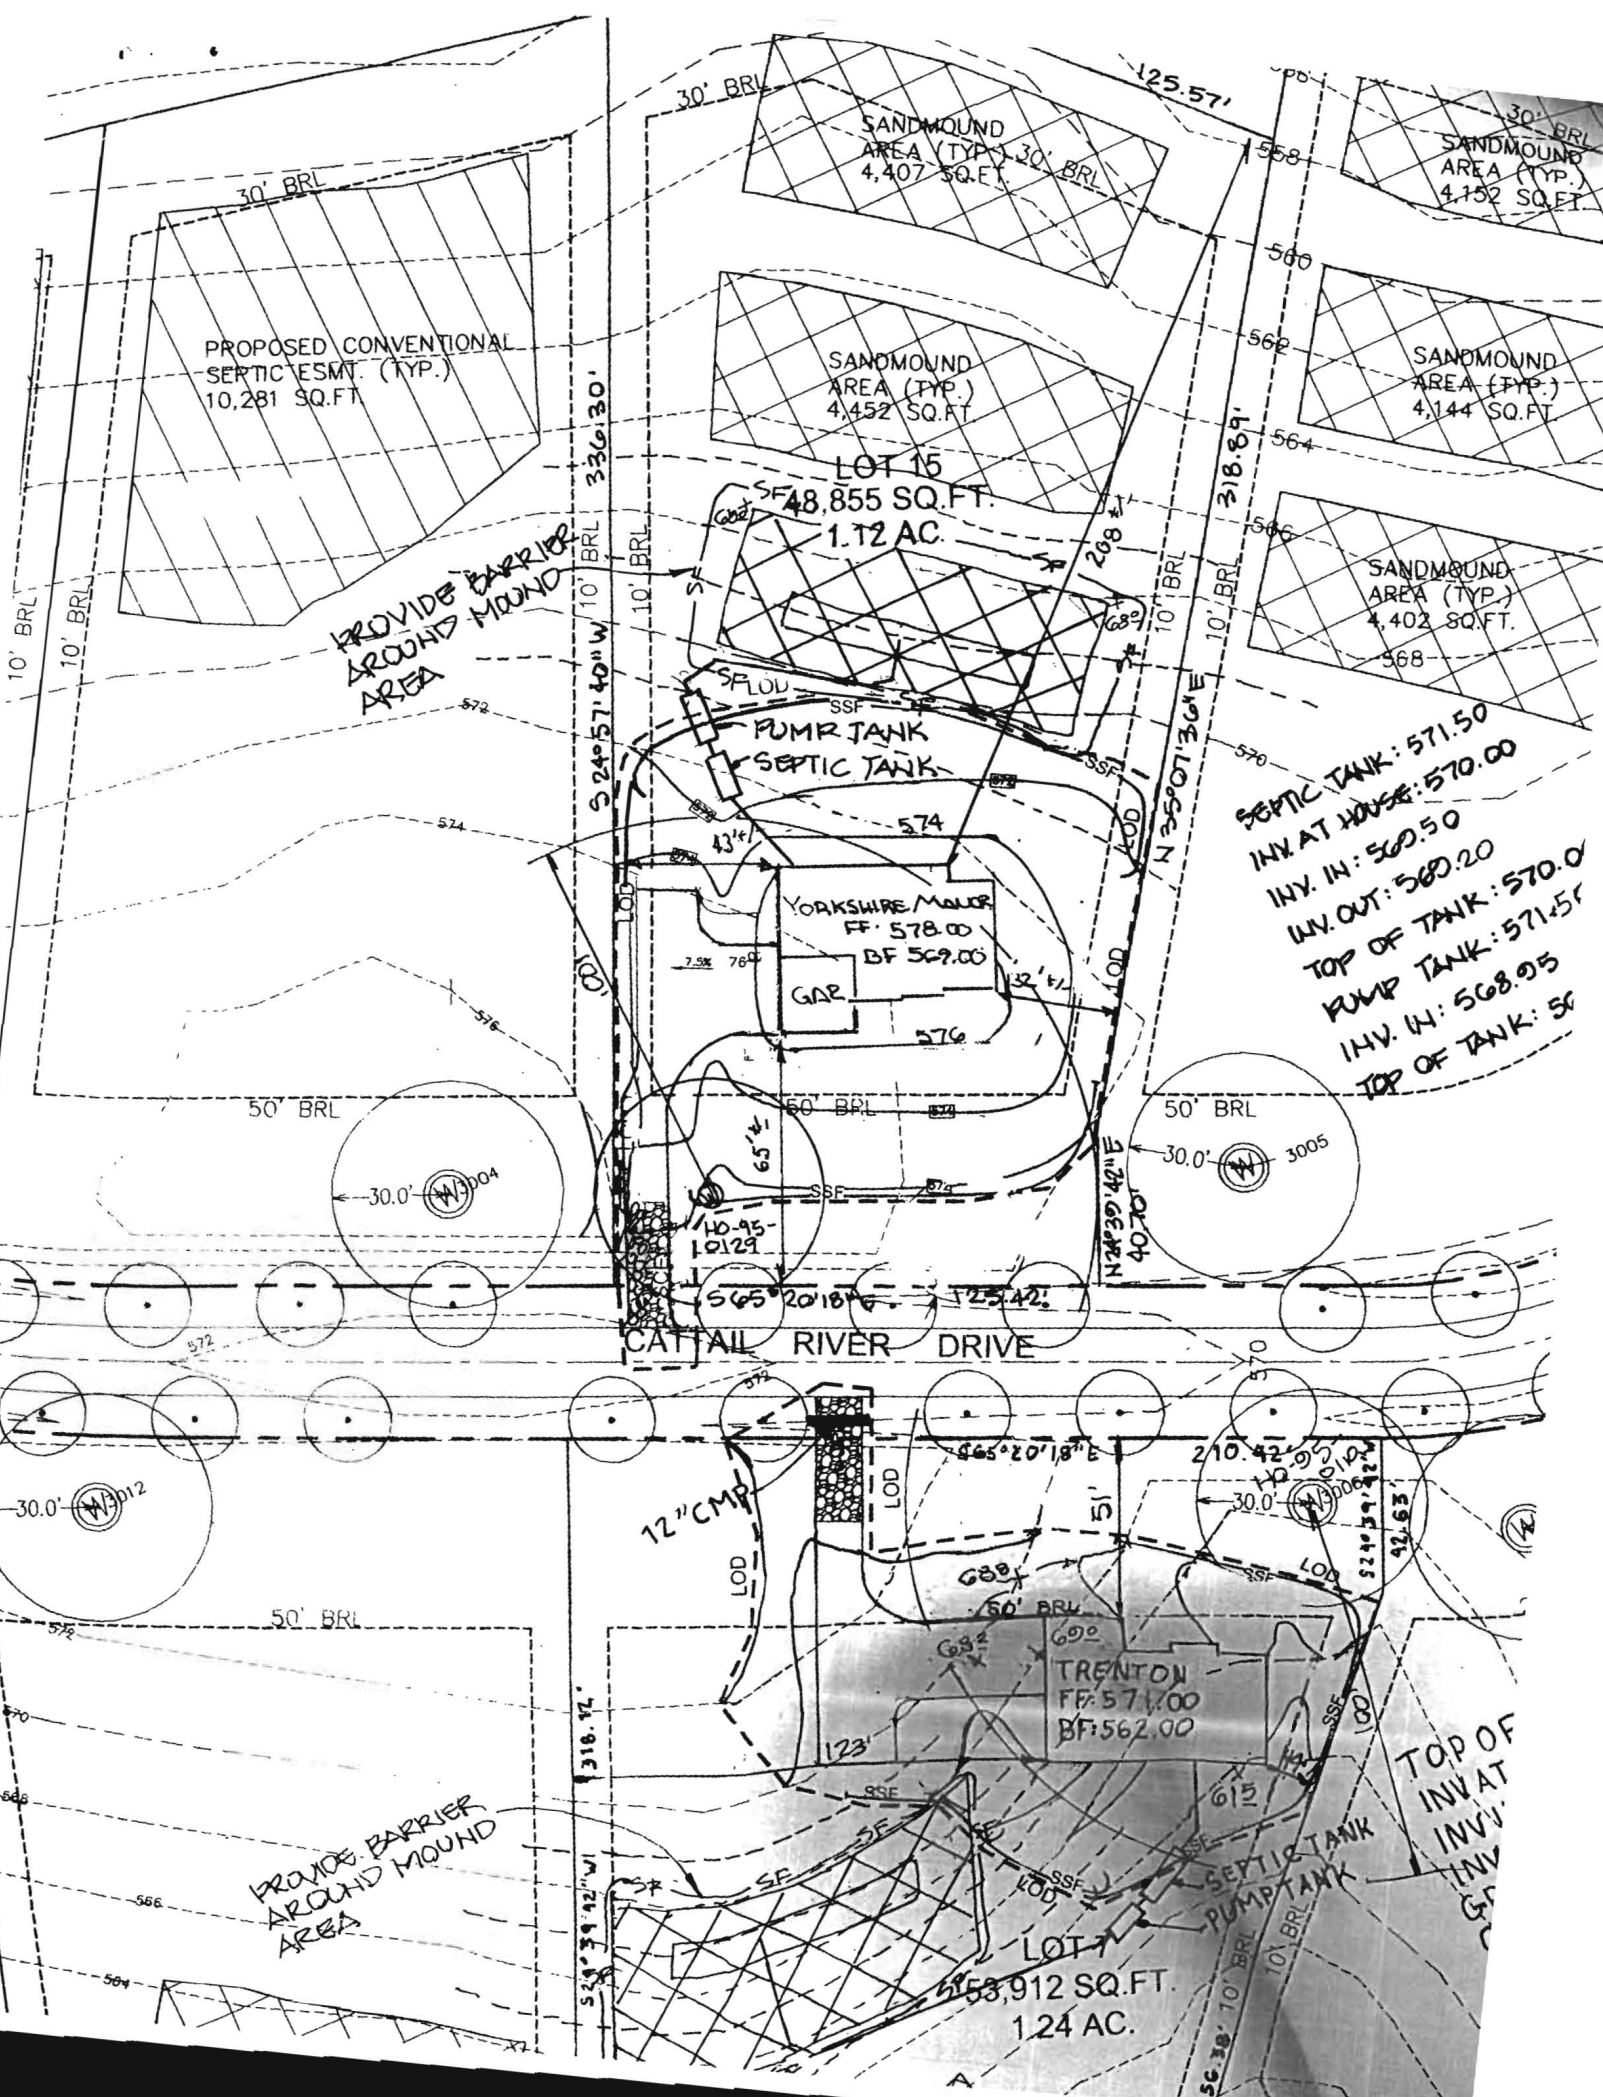

PROPOSED CONVENTIONAL
SEPTIC ESMT. (TYP.)
10,281 SQ.FT.

SANDMOUND
AREA (TYP.) 30' BRL
4,407 SQ.FT.

SANDMOUND
AREA (TYP.)
4,452 SQ.FT.

SANDMOUND
AREA (TYP.)
4,152 SQ.FT.

SANDMOUND
AREA (TYP.)
4,144 SQ.FT.

LOT 15
48,855 SQ.FT.
1.12 AC.

SANDMOUND
AREA (TYP.)
4,402 SQ.FT.

PUMP TANK
SEPTIC TANK

YORKSHIRE MAJOR
FF: 578.00
BF: 569.00

SEPTIC TANK: 571.50
INV. AT HOUSE: 570.00
INV. IN: 569.50
INV. OUT: 569.20
TOP OF TANK: 570.0
PUMP TANK: 571.5
INV. IN: 568.95
TOP OF TANK: 571.5

CATTAIL RIVER DRIVE

TRENTON
FF: 571.00
BF: 562.00

LOT 7
653,912 SQ.FT.
1.24 AC.

SEPTIC TANK
PUMP TANK

TOP OF
INV. AT
INV. IN
INV. OUT

PROVIDE BARRIER
AROUND MOUND
AREA

PROVIDE BARRIER
AROUND MOUND
AREA

4	Number of Bedrooms
600	gpd Design Flow
1	Design Infiltration Rate
600	Minimum Absorption Bed SF

Department of the Environment
 Water Management Administration
 On-Site Systems Division
 June 2003 (4th Edition)

Remember a minimum 25' wide area downslope of the mound should be designated to be protected from compaction and free of structures (driveways, buildings, etc.)

AxB=	600.3	Absorption Bed SF	
B=	66.70	Bed Length (feet)	
A=	9.00	Bed width (feet)	
D=	24	Upland sand fill depth (inches)	
E=	32.64	Downslope sand fill depth (inches)	2.72 feet
F=	10	Bed depth (inches)	
G=	12	Cap + topsoil at bed edge (inches)	
H=	18	Cap + topsoil at bed center (inches)	
I=	216.3744	Downslope setback (inches)	18.03 feet
J=	110.4	Upslope setback (inches)	9.20 feet
K=	168.96	Sideslope setback (inches)	14.08 feet
L=	1138.32	Total length of mound (inches)	94.90 feet
S=	0.08	Slope of the site	
W=	434.7744	Total width of mound (inches)	36.23 feet
Z=	24	Depth to water table (inches)	

LOADING RATE AND BASAL AREA CALCULATIONS


Linear Loading Rate: Design Flow/Bed Length	9
Soil infiltration rate based on percolation rate	0.76
Basal area required: Design Flow/soil infiltration rate	800
Basal area provided with preliminary width	1802.08

Basal Area Requirement = Passed

Central Manifold Distribution Network


10	Perforations per Lateral
31.7'	Lateral Length in feet
4	Laterals @ 2.25' Apart
1.25	Minimum Lateral Diameter (Inches) for Plastic Pipe with 3.33' Perforation Spacing and 5/16" Perforation Diameter
75	3" Force Main and Manifold Length (feet)
100.00	Minimum Dose with PVC Sch. 40 Rigid Pipe (gallons)
700.00	Minimum Capacity Pumping Chamber (gallons)
16.62	Lateral Discharge Rate (gallons per minute)
130.40	Total Discharge Rate (gallons per minute)
4	3" 45 Degree Bend Total (4 Typically)
1	3" Tee Total (1 Typically)
27	Pipe Fitting Friction Loss (linear feet)
103	Total Equivalent Length of Pipe
0.83	Friction Head (feet) → should be 11 ft ±
6	Static Head (distance between highest point - pump off switch elev. in feet)
2	Distal Head (feet)
8.83	Design Head (feet)
0.73	Horsepower Required OFF

Manifold, F.M. → 3" sch 40
1 1/4" → Laterals
5x Volume of laterals + volume of Force main & manifold.
10.6 gpf for 1 1/4"
253.6 total feet

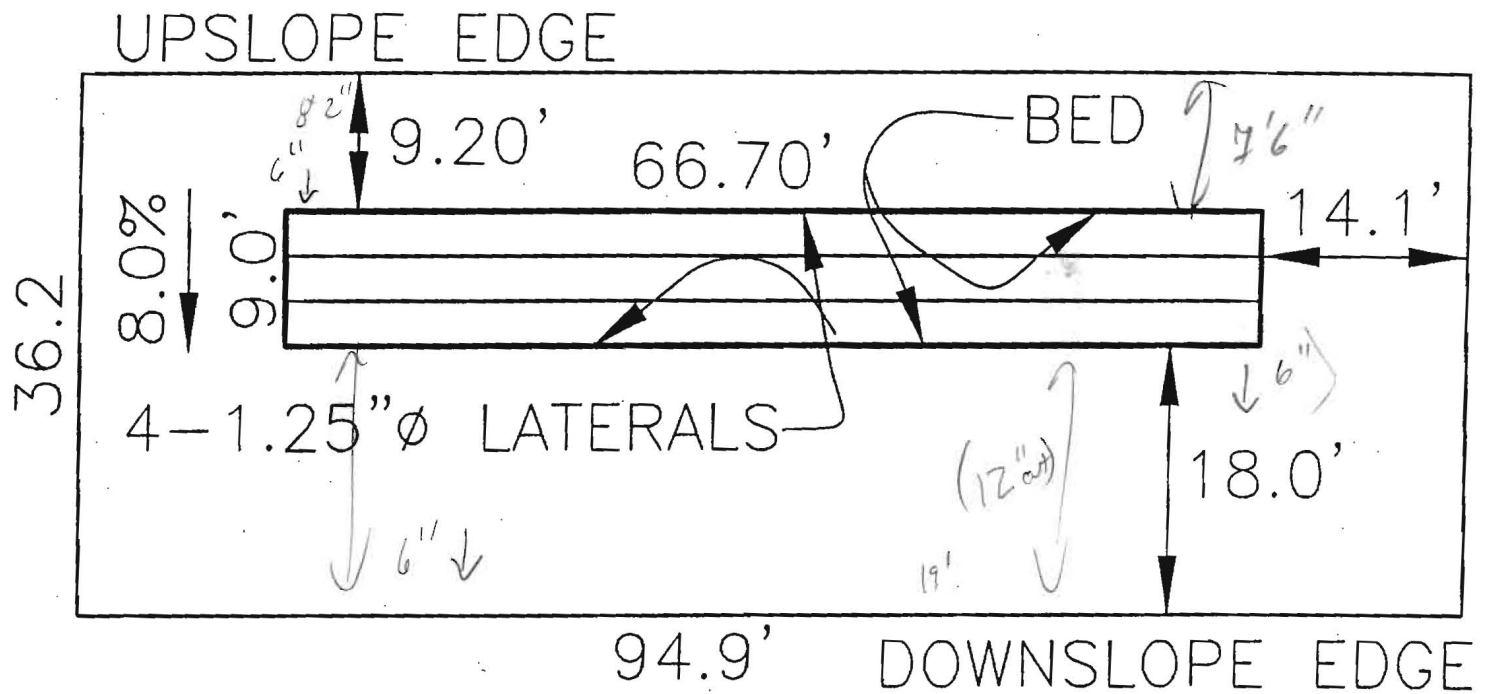



BED LAYOUT SCHEMATIC

1" = 20'

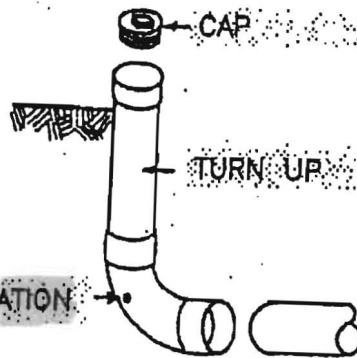

Turn-Up Placement
Recommended for Use
in All Band Hound
1/4"

END PERFORATIONS AND TURN UP DETAIL
FOR LATERALS
NOT TO SCALE

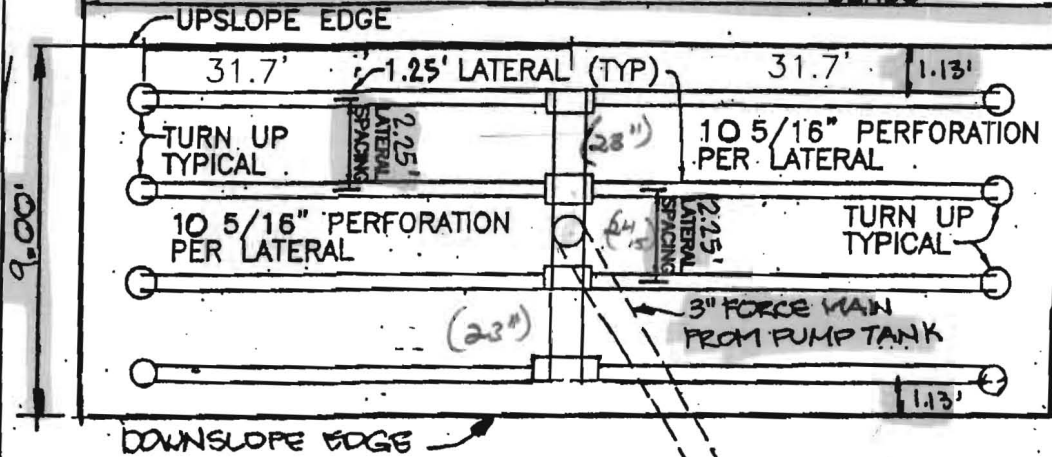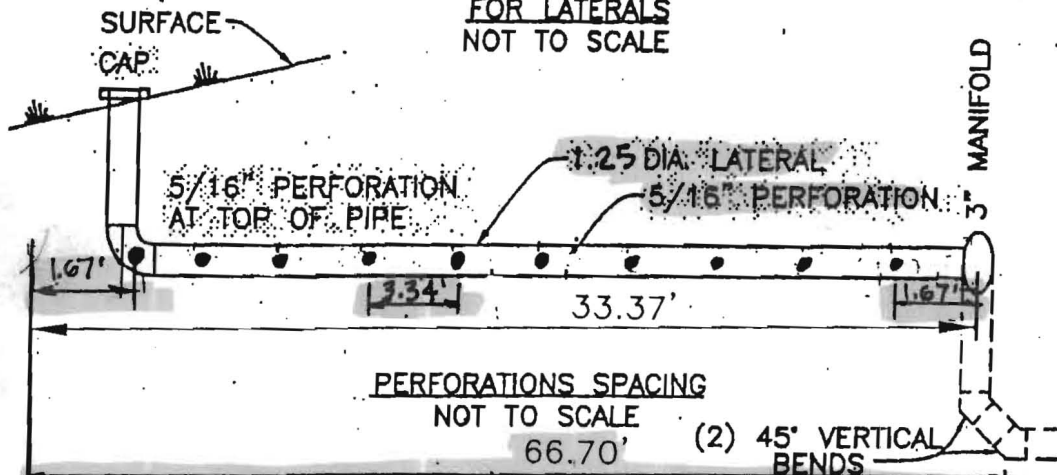

LATERAL LAYOUT
N.T.S.



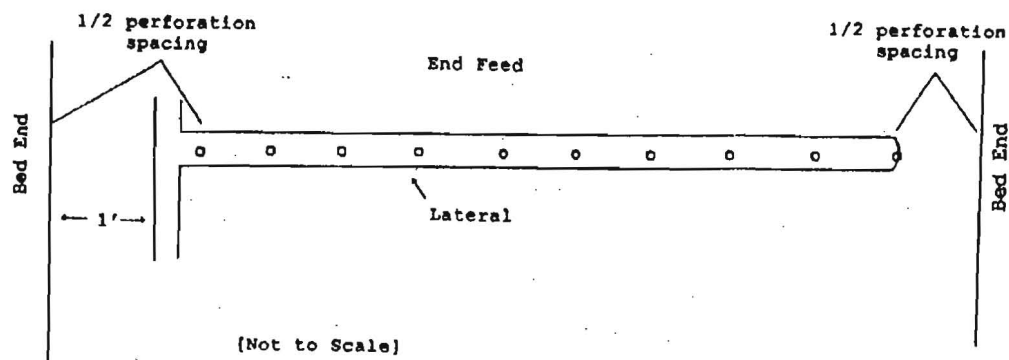


FIGURE 4.3 - PERFORATION SPACING AND LATERAL LENGTH DIAGRAMS

Blank - for Analysis

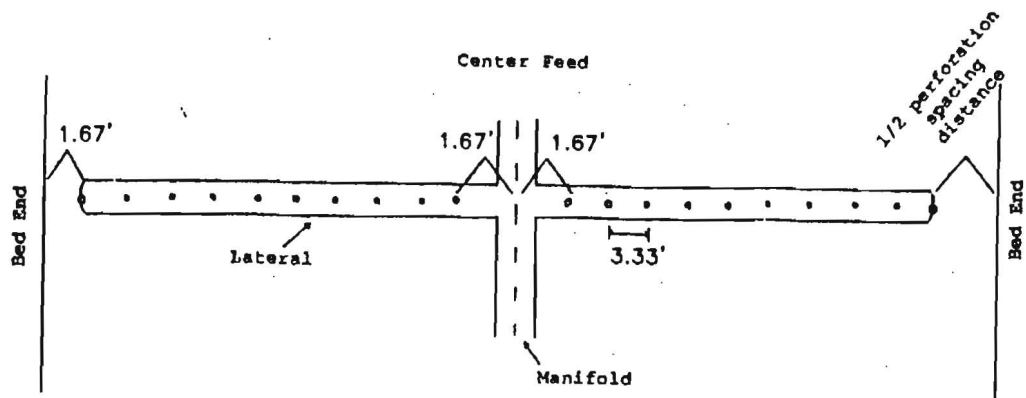

D₁₀ = effective size = 0.185

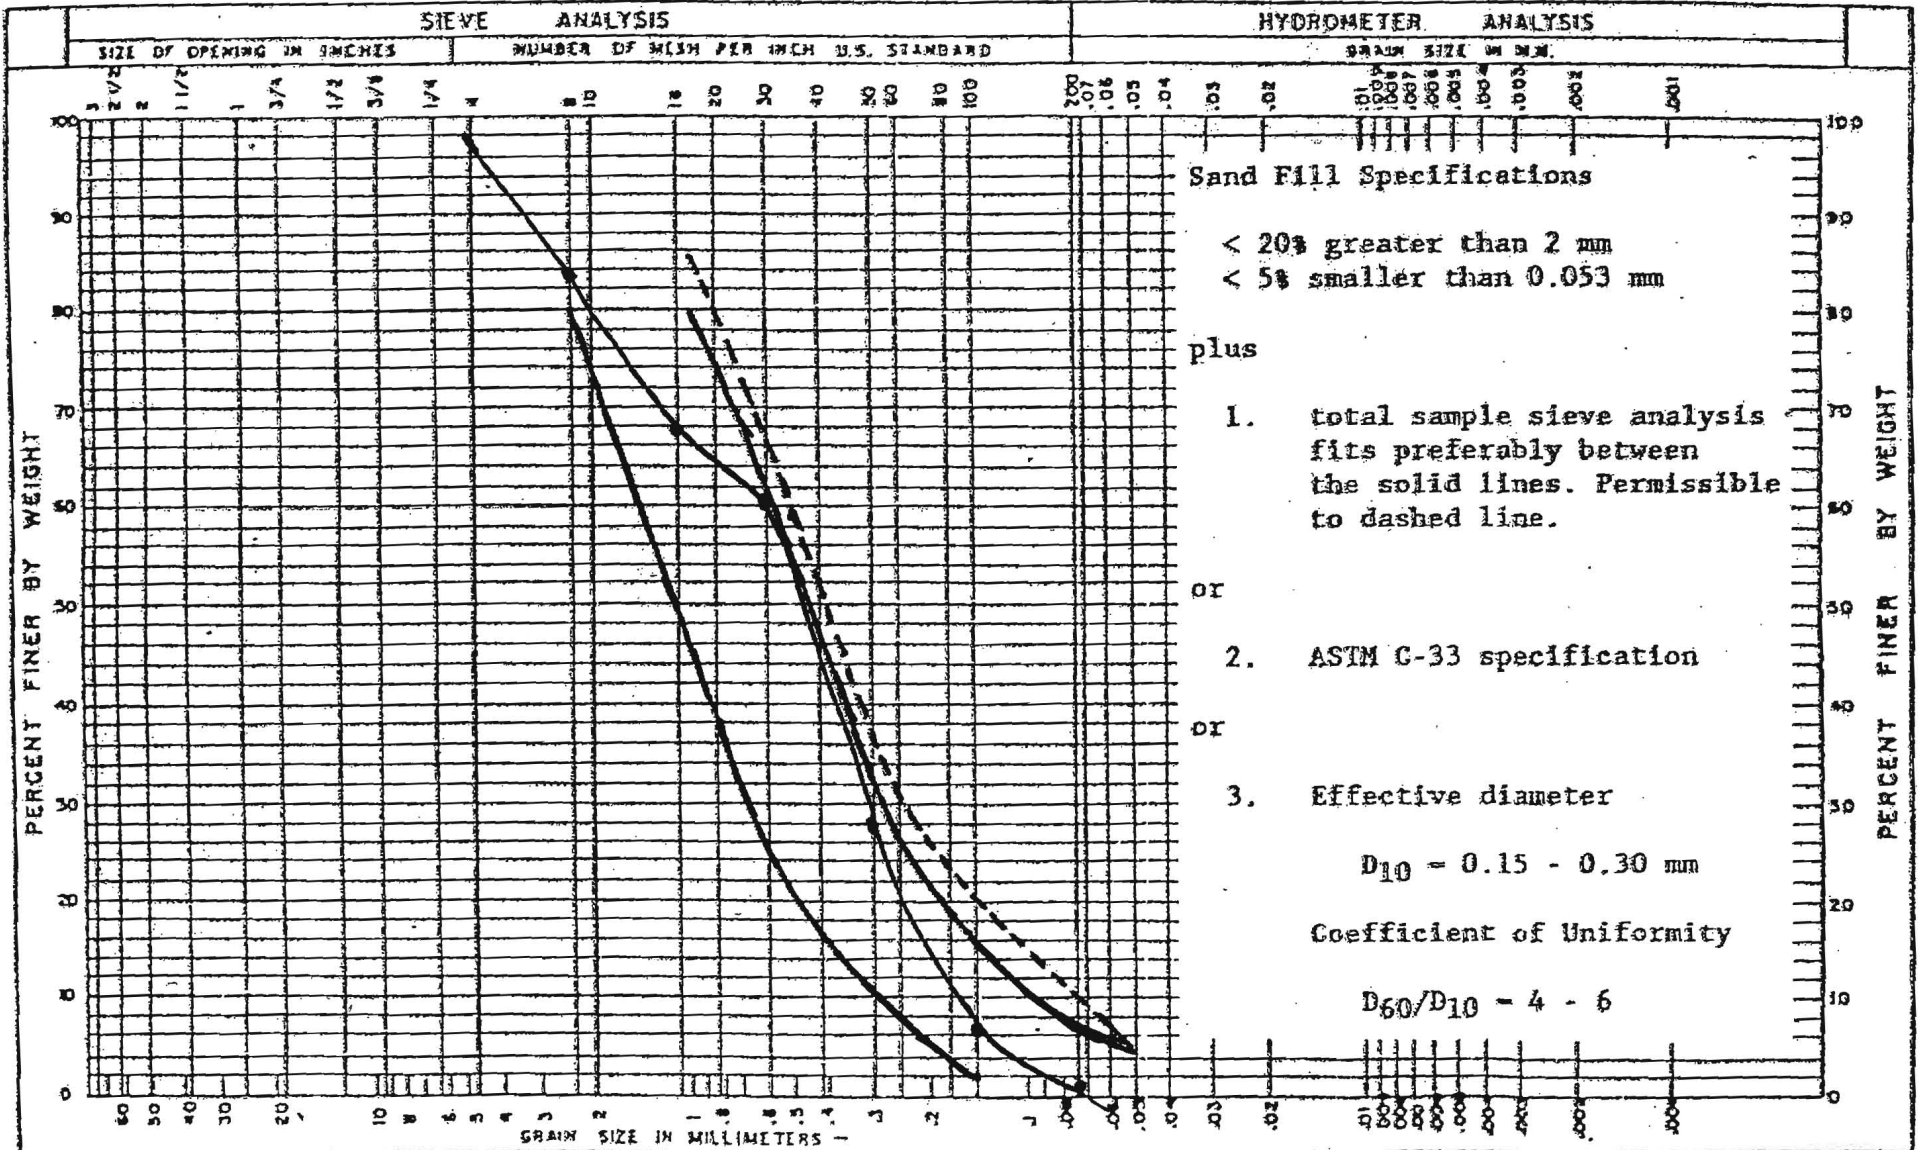

APPROX LOCATION /
SPLIT PROPOSED
TANK.

SEPTIC TANK: 571.50
 TOP OF TANK AT HOUSE: 570.00
 PROPERTY IN: 569.30
 WITHOUT: 569.05
 TOP OF TANK: 570.00
 PUMP TANK: 571.00
 INV. IN: 568.95
 TOP OF TANK: 569.87

* JOE
 * JAMES
 * ERIC
 * FRANK/CSI

6326 CATTAIL RIVER DR

Approved Septic System Plan
 Howard County Health Department

Jim Wolf 10/14/09
 Signature Date

1309000790

* Site visit confirmed on 10/2/09
 Proposed location for LP tank OK,
 Minimum 150' from all wells!
 Tank will be moved if not 100'