

10/4/01
Layout
11 A.M.

10/5/01
Final
Noon

ISSUE DATE: 8/29/2001

APPROVAL DATE: 10/5/01

PERMIT

INDEXED

P 516007-A

A 50211-J

ON-SITE SEWAGE DISPOSAL SYSTEM HOWARD COUNTY HEALTH DEPARTMENT BUREAU OF ENVIRONMENTAL HEALTH

05-422787

Hatfield's Equipment IS PERMITTED TO INSTALL ALTER

ADDRESS: 13785 Burntwoods Road, Glenelg, MD PHONE NUMBER: 301-854-6172

SUBDIVISION: Chapel Woods III LOT NUMBER: 35

ADDRESS: 11754 Chapel Estates Drive PROPERTY OWNER: Williamsburg Group

SEPTIC TANK CAPACITY (GALLONS): 2000

PUMP CHAMBER CAPACITY (GALLONS): N/A

NUMBER OF BEDROOMS: 6

SQUARE FEET PER BEDROOM: 180

LINEAR FEET OF TRENCH REQUIRED: 360


TRENCHES:	Trench to be 3.0 feet wide. Inlet 2.0 feet below original grade. Bottom maximum depth 3.5 feet below original grade. Effective area begins at 2.0 feet below original grade. 1.5 feet of stone below distribution pipe.
LOCATION:	Begin trenches 110 feet off the right lot line and 70 feet off the rear (312.97') lot line as seen when facing the lot from the use-in-common driveway. Run trenches on contour toward the right lot line.
NOTES:	<i>Trenches to Be Spaced 7' apart, 10' centers.</i>

PLANS APPROVED: Amy McMillen 5/11/01 OK **(BA)** DATE: 4/6/01

- NOTE: PERMIT VOID AFTER 2 YEARS
- NOTE: CONTRACTOR RESPONSIBLE FOR SCHEDULING A PRE-CONSTRUCTION INSPECTION FOR ALL INSTALLATIONS
- NOTE: WATERTIGHT SEPTIC TANKS REQUIRED
- NOTE: ALL PARTS OF SEPTIC SYSTEM SHALL BE 100 FEET FROM ANY WATER WELL
- NOTE: MANHOLE RISERS REQUIRED ON ALL SEPTIC TANKS AND PUMP CHAMBERS

NEITHER THE HOWARD COUNTY COUNCIL NOR THE HEALTH DEPARTMENT IS RESPONSIBLE FOR THE SUCCESSFUL OPERATION OF ANY SYSTEM PERMITTEE RESPONSIBLE FOR OBTAINING FINAL APPROVAL ON THIS PERMIT CALL 410-313-2640 FOR INSPECTION OF SEPTIC SYSTEM

P 516007-A

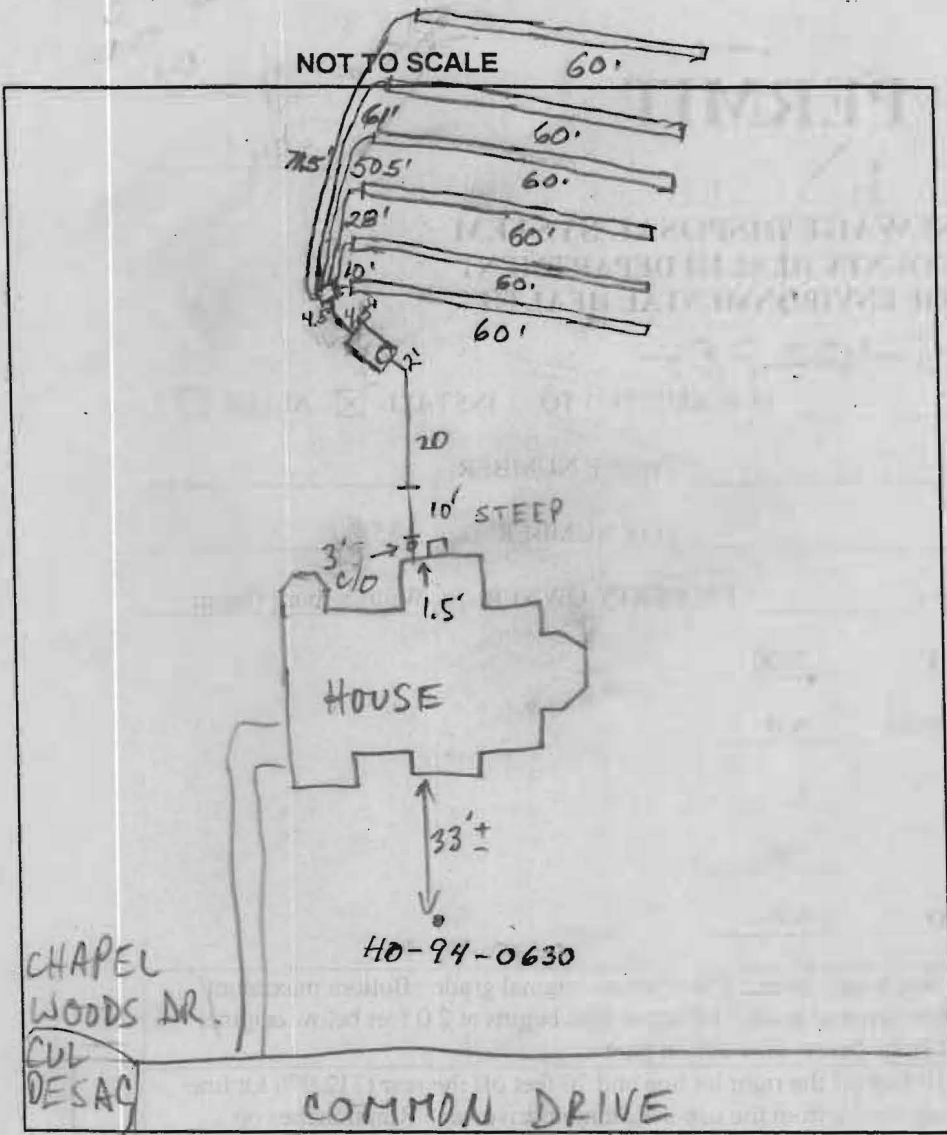

TRENCH DATA	
TRENCH WIDTH	<u>3'</u>
TRENCH INLET DEPTH	<u>2'</u>
TRENCH BOTTOM DEPTH	<u>3.5'</u>
DEPTH OF STONE	<u>1.5'</u>
NUMBER OF TRENCHES	<u>6</u>
TOTAL TRENCH LENGTH	<u>360'</u>
ABSORBENT AREA	<u>1,080 sq ft</u>
DISTRIBUTION BOX LEVEL	<u>Yes</u>
BAFFLE IN DISTRIBUTION BOX	<u>Yes</u>

SEPTIC TANK DATA	
SEPTIC TANK	<u>2000 TS GALLONS</u>
MANHOLE RISER	<u>Yes</u>
6 INCH INSPECTION PORT	<u>Yes</u>
PUMP CHAMBER DATA	
PUMP CHAMBER GALLONS	<u>N/A</u>
MANHOLE RISER	<u>N/A</u>
ALARM	<u>N/A</u>
PUMP PERFORMANCE TEST	<u>N/A</u>



PRE-CONSTRUCTION INSPECTION: 10/4/01 AM OK TO START (6) 60' TRENCHES

INSPECTION COMMENTS: 10/5/01 O.K. to cover. (BB)

INSPECTOR B. Baker DATE SYSTEM APPROVED 10/5/01

NOTE: This lot appears to lie in an area classified as Zone C, area of minimal flooding, as shown on FIRM MAP of Howard County, Maryland, Community Panel Number 2400440027B, Panel 27 of 45, dated December 4, 1986.

Wall Check: 6-8-01
Top of Wall Elev.: 1379.7

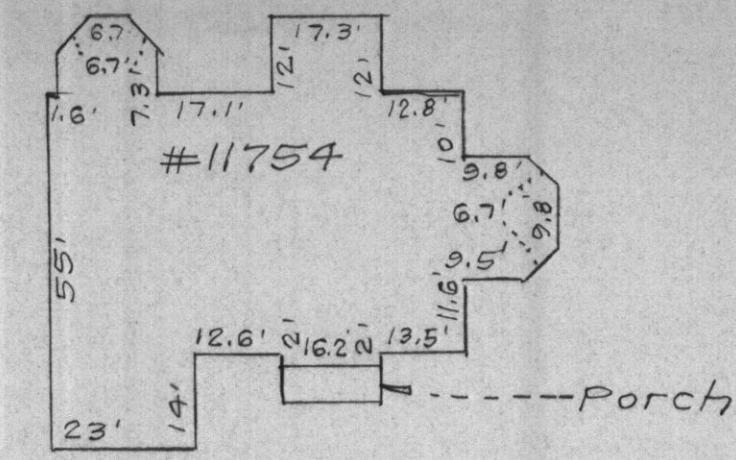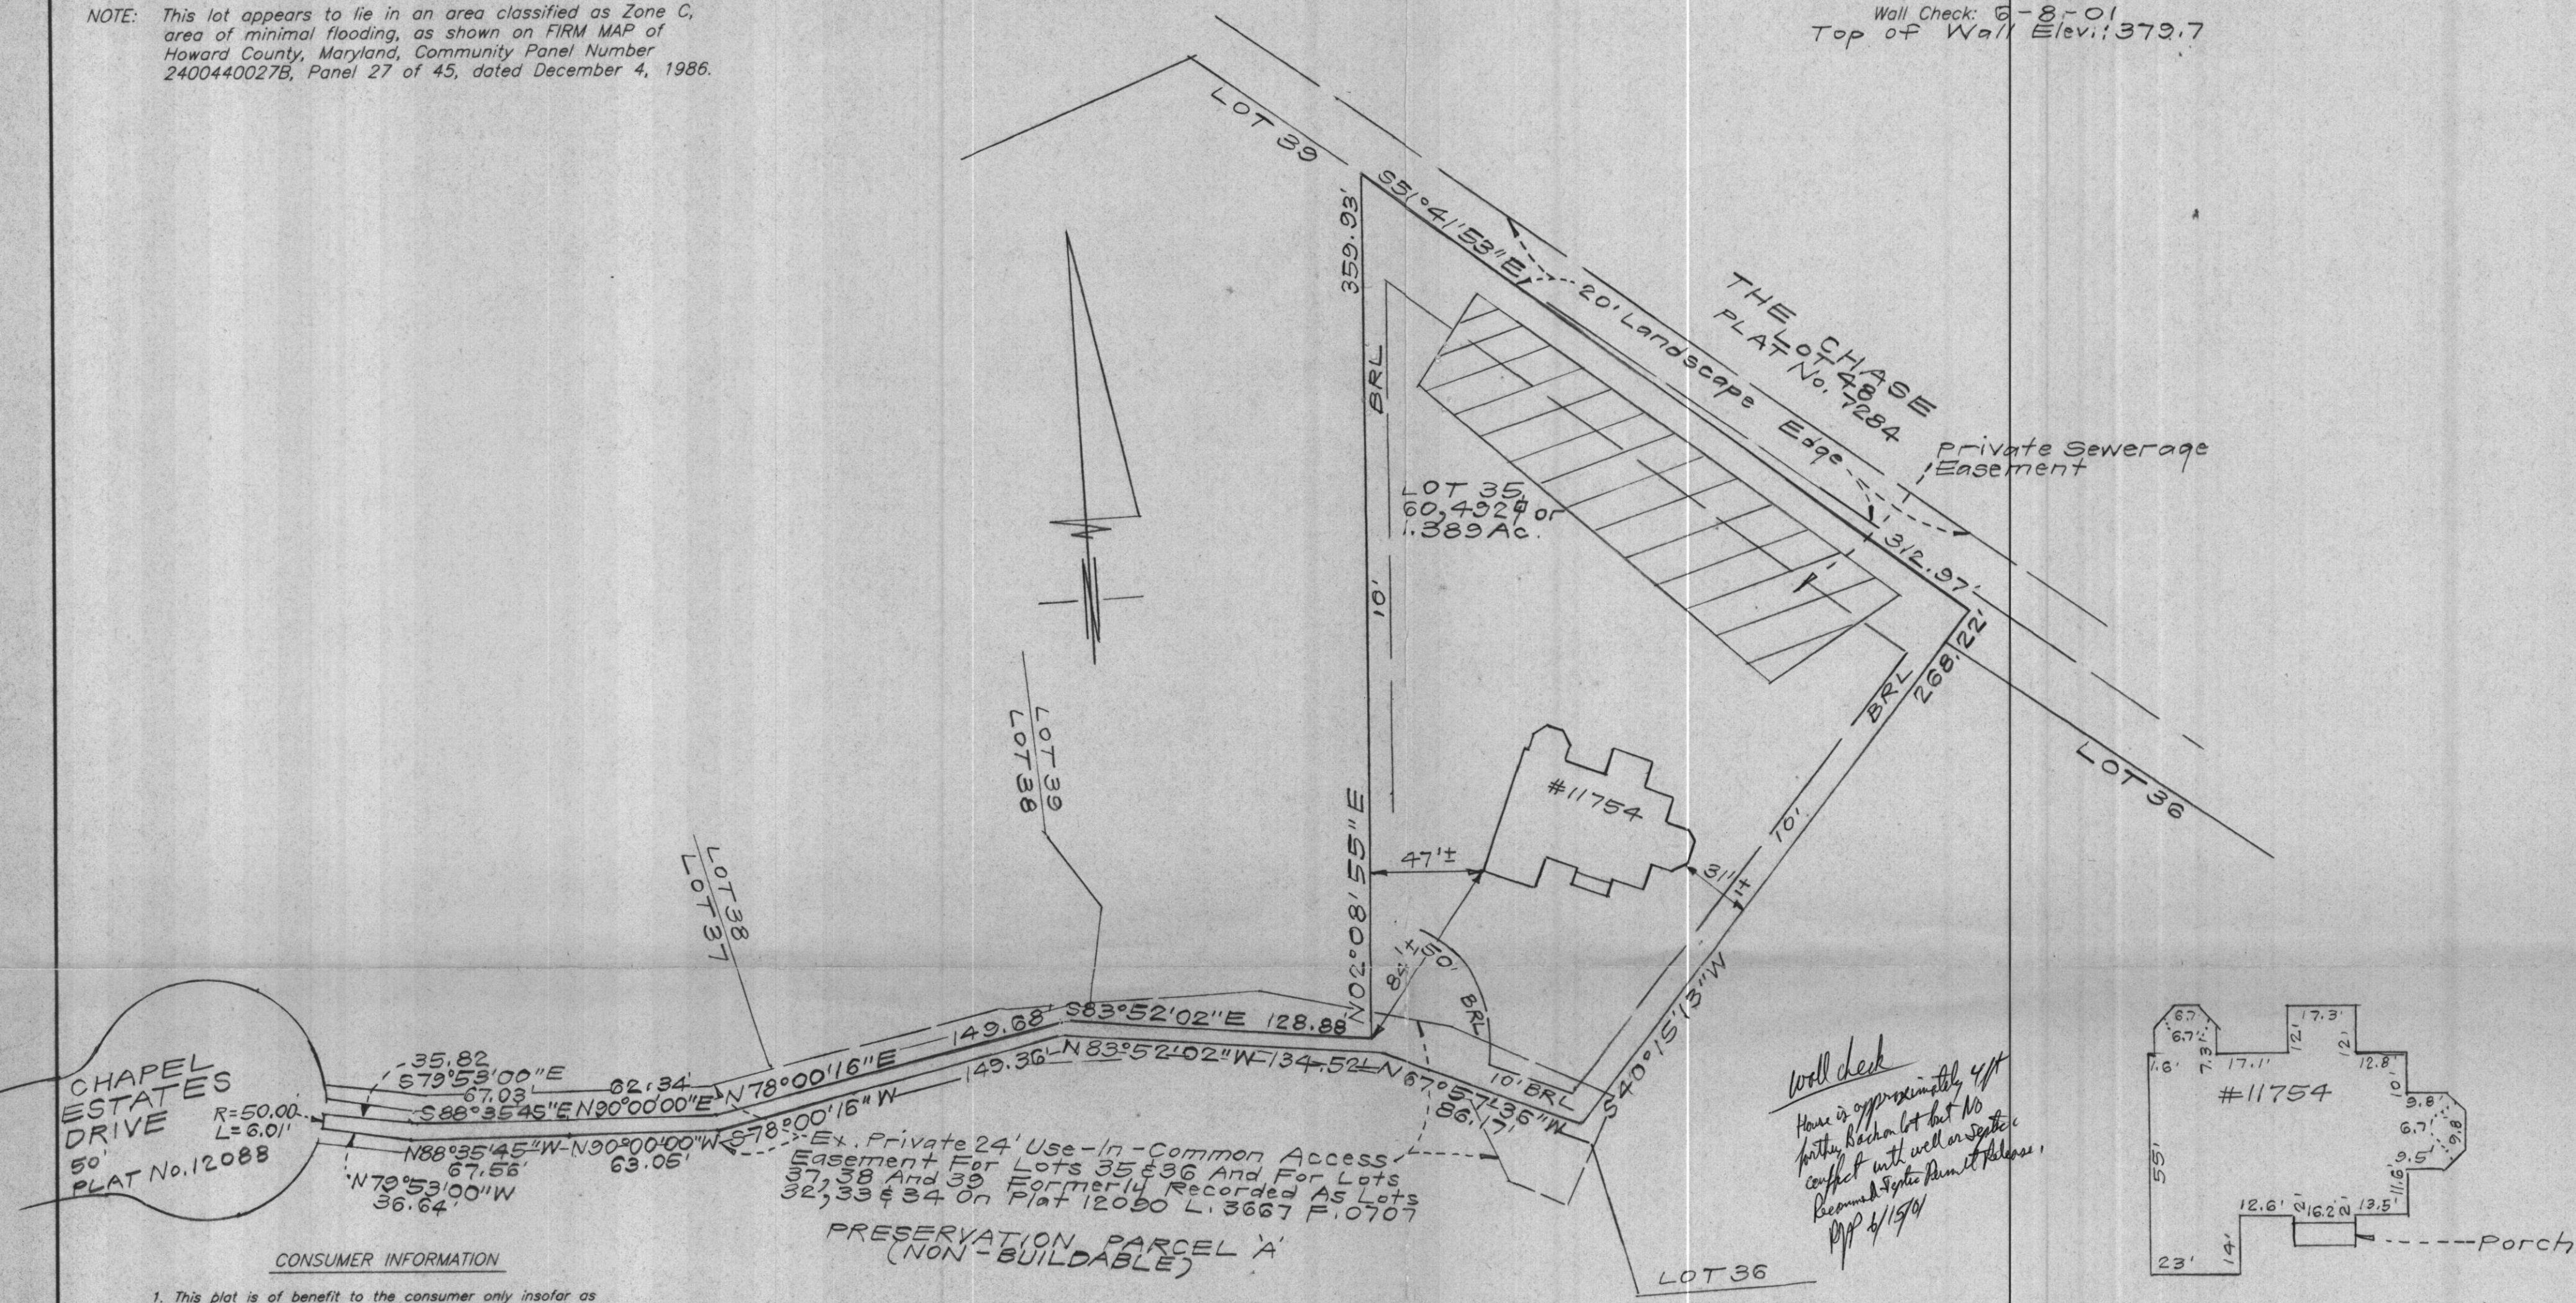

SCALE: 1"=30'

WALL CHECK
BP# B00129179
Williamsburg Group LLC

Plat Reference: 14275

		CLARK • FINEFROCK & SACKETT, INC. ENGINEERS • PLANNERS • SURVEYORS 7135 MINSTREL WAY • COLUMBIA, MD 21045 • (410) 381-7500 BALT. • (301) 621-8100 WASH.	
		DESIGNED DRAWN CHECKED DATE	LOCATION DRAWING 11754 CHAPEL ESTATES DRIVE LOT 35 CHAPEL WOODS III LOTS 30, 31, 35, 36, 37, 38 AND 39 AND CHAPEL WOODS II LOT 8A (A RESUBDIVISION OF LOTS 28 AND 29 AND LOTS 32, 33 AND 34 AS SHOWN ON PREVIOUSLY RECORDED "CHAPEL WOODS III LOTS 28 THRU 36" AND PARCEL A RECORDED AS PLAT No. S 12087 THRU 12090) 5TH ELECTION DISTRICT HOWARD COUNTY, MARYLAND
6-12-01 DATE		KWC PAS	00-090-0

CONSUMER INFORMATION

1. This plat is of benefit to the consumer only insofar as it is required by a lender of a title insurance company or its agent in connection with contemplated transfer, financing or refinancing purposes;
2. This plat is not to be relied upon for the establishment or location of fences, garages, buildings or other existing or future structures;
3. This plat does not provide for the accurate identification of property boundary lines, but such identification may not be required for the transfer of title or for securing financing or refinancing.

SURVEYOR'S CERTIFICATE

I hereby certify that a field survey of this property has been made under my supervision for the purpose of locating the improvements shown hereon, and that they are located as shown.

6-12-01
DATE



NOTES:
1. The ± setback distance accuracy = 1'.