

Check Approved 8/6/68 JCS

8/5/68  
Ready for  
trick

# PERMIT

P 13501

A 05953

SEWAGE DISPOSAL SYSTEM

MARYLAND STATE DEPARTMENT OF HEALTH

HOWARD COUNTY

## INDEXED

ELLICOTT CITY

DISTRICT 5

DATE 5/10/68

Allen Van Sant IS PERMITTED TO INSTALL  ALTER

ADDRESS West Friendship, Maryland PHONE HD 9-4195

A SEWAGE DISPOSAL SYSTEM LOCATED AT \_\_\_\_\_

SUBDIVISION Woodcroft ROAD Cherry Tree Drive LOT 12, Sec. 4

PROPERTY OWNER Clade D. Krubs (Near Omega Mr. and Mrs. John Sauer)

ADDRESS \_\_\_\_\_

SPECIFICATIONS - 3 bedrooms

DRAIN FIELD \_\_\_\_\_ DEPTH \_\_\_\_\_ FEET, BOTTOM AREA \_\_\_\_\_ SQ. FT.

SEEPAGE PITS \_\_\_\_\_ ABSORBENT SIDE-WALL AREA \_\_\_\_\_ SQ. FT.

SEPTIC TANK CAPACITY 750 GALLONS

FOR GARBAGE GRINDER, INCREASE DISPOSAL AREA 22% & TANK CAPACITY 50%

OTHER Dry well - 300 sq. ft. absorbent sidewall area below inlet pipe.

Inlet to be no deeper than 4 ft. below original grade. Locate dry well 27 ft.

from front lot line and 60 ft. from left side line as lot is seen when facing it

from Cherry Tree Drive.

Maximum depth permitted 12' below original grade.

PERMIT VOID AFTER THREE YEARS.


PLANS APPROVED BY R. Fletcher DATE 11/9/65

FILL SEPTIC TANK AND DISTRIBUTION BOX WITH WATER BEFORE CALLING FOR AN INSPECTION. COVER NO WORK UNTIL INSPECTED AND APPROVED.

NEITHER THE HOWARD COUNTY COMMISSIONERS NOR THE HEALTH DEPARTMENT IS RESPONSIBLE FOR THE SUCCESSFUL OPERATION OF ANY SYSTEM.

A 09953

13  
5 2/3  
4/16

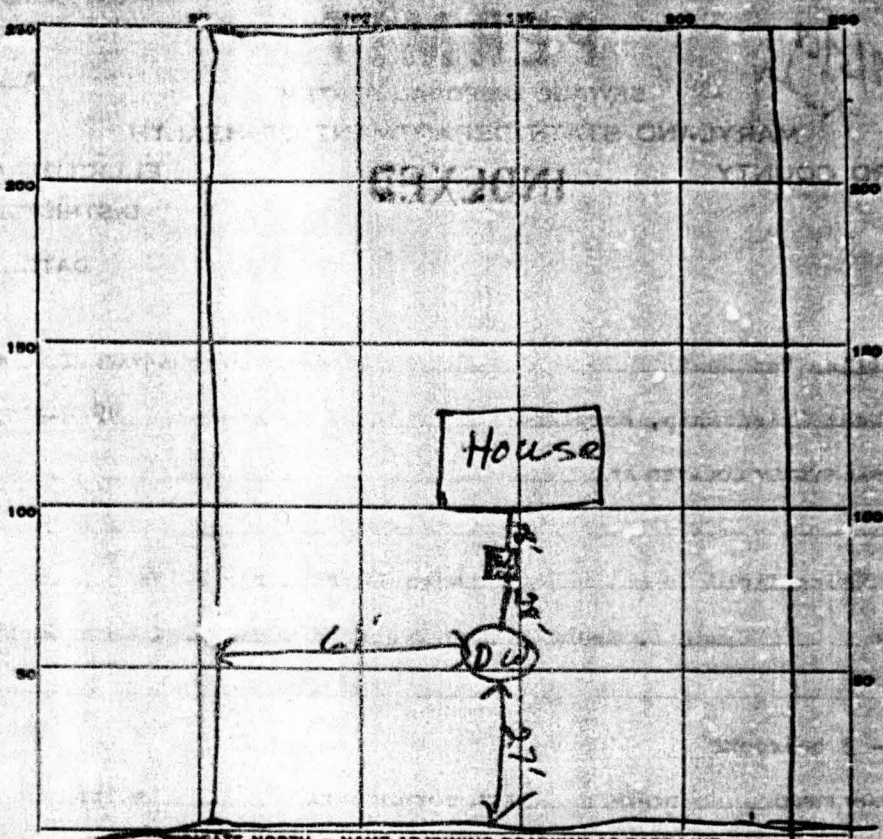

INDICATE NORTH - NAME ADJOINING ROADWAY AS BASE LINE.

PERMIT CARD OK Cherry Tree Drive

SEPTIC TANK, LEVEL OK - 756 cement CLEANOUTS OK

DISTRIBUTION BOX, LEVEL \_\_\_\_\_

TILE FIELD, DEPTH \_\_\_\_\_ FT. TRENCH WIDTH \_\_\_\_\_ FT.

GRAVEL DEPTH \_\_\_\_\_ IN. TOTAL LENGTH \_\_\_\_\_ FT.

NUMBER OF TRENCHES \_\_\_\_\_ TOTAL BOTTOM AREA \_\_\_\_\_

SEEPAGE PITS, INSIDE DIAMETER 13 x 13 whole with gravel 870 FT. DEPTH BELOW INLET 8 FT.

ABSORBENT AREA 4/16 SQ. FT.

REMARKS \_\_\_\_\_  
\_\_\_\_\_  
\_\_\_\_\_  
\_\_\_\_\_  
\_\_\_\_\_

DATE SYSTEM APPROVED 8/6/68 INSPECTOR James T. Wright