

Depth 87'

STATE OF MARYLAND DEPARTMENT OF NATURAL RESOURCES
 STATE OFFICE BLDG. 1000 MARYLAND AVE. BALTIMORE, MD. 21201

THIS REPORT MUST BE SUBMITTED WITHIN 30 DAYS AFTER COMPLETION OF THE WELL

FILL IN THIS FORM COMPLETELY

SEQUENCE NO. (FOR USE ONLY) **5165**

DATE RECEIVED (FOR USE ONLY) **November 4, 1969**

DATE WELL COMPLETED **11-4-69**

PERMIT NO. FROM PERMIT TO DRILL WELL **AD-70-0003**

DRILLER'S IDENTIFICATION NO. **163**

OWNER **Sasser** LAST NAME

STREET OR RFD _____

POST OFFICE **Fulton Maryland**

WELL LOG

STATE THE KIND OF FORMATIONS PENETRATED, COLOR, DEPTH, THICKNESS AND IF WATER BEARING

DESCRIPTION (USE ADDITIONAL SHEETS IF NECESSARY)	FEET	
	FROM	TO
M. Sand	0	3
Sand	3	17
1 stream sand	17	66
2 stream	66	87
Depth of well	87	

11-6-69
3 days

GROUTING RECORD

WELL HAS BEEN GROUTED (CIRCLE APPROPRIATE BOX) Y N

DEPTH OF GROUT SEAL (TO NEAREST FOOT)

FROM **0** FT. TO **17** FT.

CASING RECORD

CASING TYPES (INSERT APPROPRIATE CODE BELOW)

STEEL ST CO PL OT

CONCRETE PLASTIC OTHER

MAIN CASING TYPE ST

INSIDE DIAMETER TOP (MAIN) CASING (NEAREST INCH) **6**

TOTAL DEPTH OF MAIN CASING (NEAREST FOOT) **65**

OTHER CASING (IF USED)

DIAMETER (INCH)	DEPTH (FEET)

SCREEN RECORD

SCREEN TYPE (CIRCLE APPROPRIATE CODE BELOW)

STEEL ST BR HO PL OT

BRASS OR BRONZE OPEN HOLE PLASTIC OTHER

DEPTH (NEAREST WHOLE FOOT)

FROM	TO
0	10
10	20
20	30
30	40
40	50
50	60
60	70
70	80
80	90

PUMPING TEST

HOURS PUMPED (TO NEAREST HOUR) _____

PUMPING RATE (GALLONS PER MINUTE TO NEAREST GALLON) **6**

METHOD USED TO MEASURE PUMPING RATE **Baikr**

WATER LEVEL (DISTANCE FROM LAND SURFACE)

DEPTH PUMPING **20** FEET

WHEN PUMPING **65** FEET

TYPE OF PUMP USED (CIRCLE APPROPRIATE BOX)

AIR PISTON TURBINE CENTRIFUGAL ROTARY OTHER (DESCRIBE BELOW) **Baikr**

PUMP INSTALLED


TYPE OF PUMP (WRITE APPROPRIATE LETTER IN BOX - SEE ABOVE: A, C, J, P, R, S, T, U)

CAPACITY: _____ GALLONS PER MINUTE (TO NEAREST GALLON)

CASING HEIGHT (CIRCLE APPROPRIATE SIGN AND ENTER CASING HEIGHT)

+ ABOVE LAND SURFACE

- BELOW LAND SURFACE

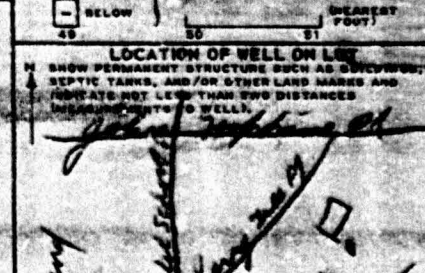

CIRCLE APPROPRIATE BOXES

A WELL WAS ABANDONED AND SEALED WHEN THIS WELL WAS COMPLETED

E ELECTRIC LOG OBTAINED

C COPY OF ELECTRIC LOG ATTACHED

I HEREBY CERTIFY THAT I HAVE COMPLIED WITH ALL CONDITIONS STATED ON THE ABOVE-CAPTIONED "PERMIT TO DRILL WELL", AND THAT INFORMATION CONTAINED IN THIS REPORT IS TRUE, ACCURATE, AND COMPLETE TO THE BEST OF MY KNOWLEDGE, INFORMATION AND BELIEF.

DRILLER'S NAME **Dewey Brown**

(PLEASE PRINT) **Dewey Brown**

SIGNATURE **Dewey Brown**

IF WELL DRILLED WAS A FLOWING WELL, CIRCLE BOX F

DWR USE ONLY (NOT TO BE FILLED IN BY DRILLER)

T TELESCOPE CASING LOG INDICATOR

OTHER DATA AVAILABLE

WR-2
4-68

STATE OF MARYLAND

State Office Building
ANNAPOLIS, MARYLAND 21401

DEPARTMENT OF
WATER RESOURCES

23 3:58

THIS REPORT
MUST BE SUBMITTED
WITHIN 30 DAYS
AFTER COMPLETION
OF THE WELL

WELL COMPLETION REPORT **DA09953**

SUGAR WELL DESCRIPTION **Lot 12**

Permit Number None
Owner John Brown
Address 11111
Subdivision None
Section 7 Lot 12

WELL LOG
State the kind of formations penetrated, their color, their depth, their thickness, and if water-bearing

CASING AND SCREEN RECORD
State the kind and size and position of casing, liner, shoe, screen, and other accessories (if no casing used, give diameter of well).

	FEET from 0 to 5
Top soil	
Sand	5/10
1 Stream case of	50 ft
2 Stream	60 ft
Dept of well	84 ft

PUMPING TEST
Hours Pumped 1
Type of Pump Used Auger
Pumping Rate 5
Gallons per Minute

WATER LEVEL
(Distance from land surface to water)
Before Pumping 50 ft
When Pumping 75 ft


APPEARANCE OF WATER
Clear Good Cloudy
Taste None
Odor None

Height of Casing Above Land
Surface 2 ft

PUMP INSTALLED
Type
Capacity
Gallons per Minute
Gallons per Hour
Pump Column Length ft

28-66-2558
25 June 1968
Brought in for...

LOCATION OF WELL ON LOT
Show permanent structures such as buildings, public tank, and/or other landmarks and indicate not less than 2 distances (measurements) to well.

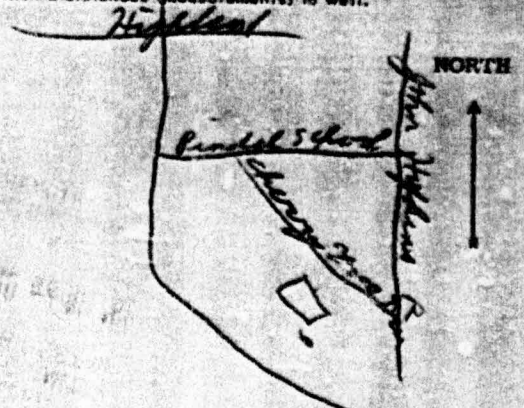

DATE WELL WAS COMPLETED

I hereby affirm that this report contains no willful misrepresentations or falsifications and that information given in this report is true, accurate and complete to the best of my knowledge and belief.

Denny Brown, Well Driller

Well Driller License No.: 113

July 10 1968