



APPLICATION

FOR PERCOLATION TESTING AND SITE EVALUATION

TEST DATE(S) _____ TEST TIME _____ AVP 5/31/77

AGENCY REVIEW: _____ DATE 8/13/09

DO NOT WRITE ABOVE THIS LINE

I HEREBY APPLY FOR THE NECESSARY TESTING/EVALUATION PRIOR TO ISSUANCE OF SEWAGE DISPOSAL SYSTEM PERMIT(S) TO:

CHECK AS NEEDED:

- CONSTRUCT NEW SEPTIC SYSTEM(S)
- REPAIR/ADD TO AN EXISTING SEPTIC SYSTEM
- REPLACE AN EXISTING SEPTIC SYSTEM

CHECK AS NEEDED:

- NEW STRUCTURE(S)
- ADDITION TO AN EXISTING STRUCTURE
- REPLACE AN EXISTING STRUCTURE

CHECK ONE:

- CREATE NEW LOT(S)
- BUILD ON AN EXISTING LOT IN A SUBDIVISION
- BUILD ON AN EXISTING PARCEL OF RECORD

IS THE PROPERTY WITHIN 2500' OF ANY RESERVOIR?

- YES
- NO

THE TYPE OF STRUCTURE IS:

- RESIDENTIAL WITH _____ PROPOSED BEDROOMS IN THE COMPLETED STRUCTURE (NOTE **UNKNOWN** IF APPROPRIATE)
- COMMERCIAL (PROVIDE DETAIL OF NUMBERS AND TYPES OF EMPLOYEES/CUSTOMERS ON ACCOMPANYING PLAN)
- INSTITUTIONAL/GOVERNMENT (PROVIDE DETAIL OF NUMBERS AND TYPES OF EMPLOYEES/USERS ON ACCOMPANYING PLAN)

PROPERTY OWNER(S) Anna Smith

DAYTIME PHONE _____ CELL _____ FAX _____

MAILING ADDRESS 7538 Cherry Tree Dr Fulton Md 20759
STREET CITY/TOWN STATE ZIP

APPLICANT Hatfields Equipment

DAYTIME PHONE 301 854-6172 CELL 410-984-0047 FAX 301 490 5794

MAILING ADDRESS PO Box 519 Annapolis Junction Md 20701
STREET CITY/TOWN STATE ZIP

APPLICANT'S ROLE: DEVELOPER BUILDER BUYER RELATIVE/FRIEND REALTOR CONSULTANT
Septic contractor

PROPERTY LOCATION
SUBDIVISION/PROPERTY NAME Moorcroft LOT NO. 5

PROPERTY ADDRESS 7538 Cherry Tree Dr Fulton
STREET TOWN/POST OFFICE

TAX MAP PAGE(S) _____ GRID _____ PARCEL(S) _____ PROPOSED LOT SIZE _____

AS APPLICANT, I UNDERSTAND THE FOLLOWING: THE SYSTEM INSTALLED SUBSEQUENT TO THIS APPLICATION IS ACCEPTABLE ONLY UNTIL PUBLIC SEWERAGE IS AVAILABLE. THIS APPLICATION IS COMPLETE WHEN ALL APPLICABLE FEES AND A SUITABLE SITE PLAN HAVE BEEN RECEIVED. I ACCEPT THE RESPONSIBILITY FOR COMPLIANCE WITH ALL M.O.S.H.A. AND "MISS UTILITY" REQUIREMENTS. APPROVAL IS BASED UPON SATISFACTORY REVIEW OF A PERC CERTIFICATION PLAN.


TEST RESULTS WILL BE MAILED TO APPLICANT.

SIGNATURE OF APPLICANT

HOWARD COUNTY HEALTH DEPARTMENT, BUREAU OF ENVIRONMENTAL HEALTH, WELL AND SEPTIC PROGRAM
7178 COLUMBIA GATEWAY DRIVE COLUMBIA, MARYLAND 21046 (410) 313-1771 FAX (410) 313-2648
TDD (410) 313-2323 TOLL FREE 1-877-4MD-DHMH

Well - No Tag

RECEIVED
 WOOD COUNTY HEALTH DEPT.
 ENVIRONMENTAL HEALTH
 2009 AU 13 PM 1:51

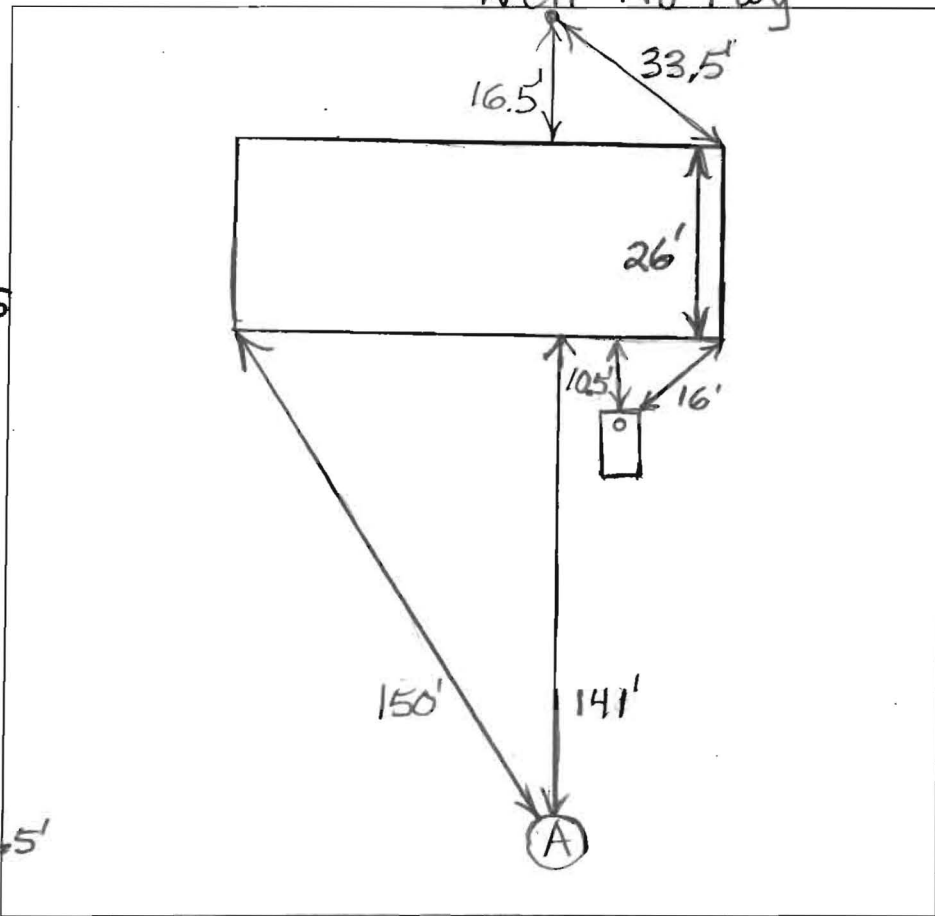

Pindell School Road

- (A)
- Topsoil 0.5'
- Red Sa Cl Loam 3-3.5'
- Light Br Dense Loam
- Perched Water Indicators 5.5'
- Red Br Loamy Sa, up to 25% Rock
- Dry 15'

DATE	TEST #	DEPTH	START	BREAK 1" DROP	STOP 2" DROP	TIME OF 2ND INCH	P/F/H
8/24/09	A	6'/15'	10:48:30	10:49:15	10:50:25	70 sec	
		Repair	10:51:15	10:52:25	10:53:55	1 1/2	
		Repair	11:01:10	11:03:15	11:05:35	2 1/2	

REMARKS Water Poured In Bottom of Hole - Rate Rather Slow
 SANITARIAN B. Baker BACKHOE Hatfields OTHERS _____
 TEST HOLES USED IN SDA A AVG. PERC TIME 2 SQ. FT/BR _____
 TRENCH WIDTH _____ INLET DEPTH _____ MAX. BOT DEPTH _____ EFFECTIVE SW _____