

7/15/65
revised
notes

PERMIT

SEWAGE DISPOSAL SYSTEM

MARYLAND STATE DEPARTMENT OF HEALTH

HOWARD COUNTY

Approved
7/15/65
R.F.

P 1072
A 0926

INDEXED

ELLICOTT CITY

DISTRICT 5

DATE 6/2/65

Elwood Scaggs

IS PERMITTED TO INSTALL ALTER

ADDRESS Murphy Rd., Laurel, Md.

PHONE PA 5-0324

A SEWAGE DISPOSAL SYSTEM LOCATED AT _____

SUBDIVISION Horseshield

ROAD Cherry Tree Drive

LOT 2, Pk. 1
PLOT 1

PROPERTY OWNER McHenry Co.

ADDRESS Clarksville, Md.

SPECIFICATIONS - 3 bedrooms

DRAIN FIELD _____ DEPTH _____ FEET, BOTTOM AREA _____ SQ. FT.

SEEPAGE PITS _____ ABSORBENT SIDE-WALL AREA _____ SQ. FT.

SEPTIC TANK CAPACITY 750 GALLONS

FOR GARBAGE GRINDER, INCREASE DISPOSAL AREA 25% & TANK CAPACITY 50%.

OTHER Dry well - 300 sq. ft. absorbent sidewall area below the inlet pipe.

Inlet pipe to be 5 ft. below original grade. Locate dry well 155 ft. from the front lot line and 80 ft. from the left side line as lot is seen when facing it from Cherry Tree Drive.


PLANS APPROVED BY Ronald Fletcher

DATE 4/2/65

FILL SEPTIC TANK AND DISTRIBUTION BOX WITH WATER BEFORE CALLING FOR AN INSPECTION. COVER NO WORK UNTIL INSPECTED AND APPROVED.

NEITHER THE HOWARD COUNTY COMMISSIONERS NOR THE HEALTH DEPARTMENT IS RESPONSIBLE FOR THE SUCCESSFUL OPERATION OF ANY SYSTEM.

1072

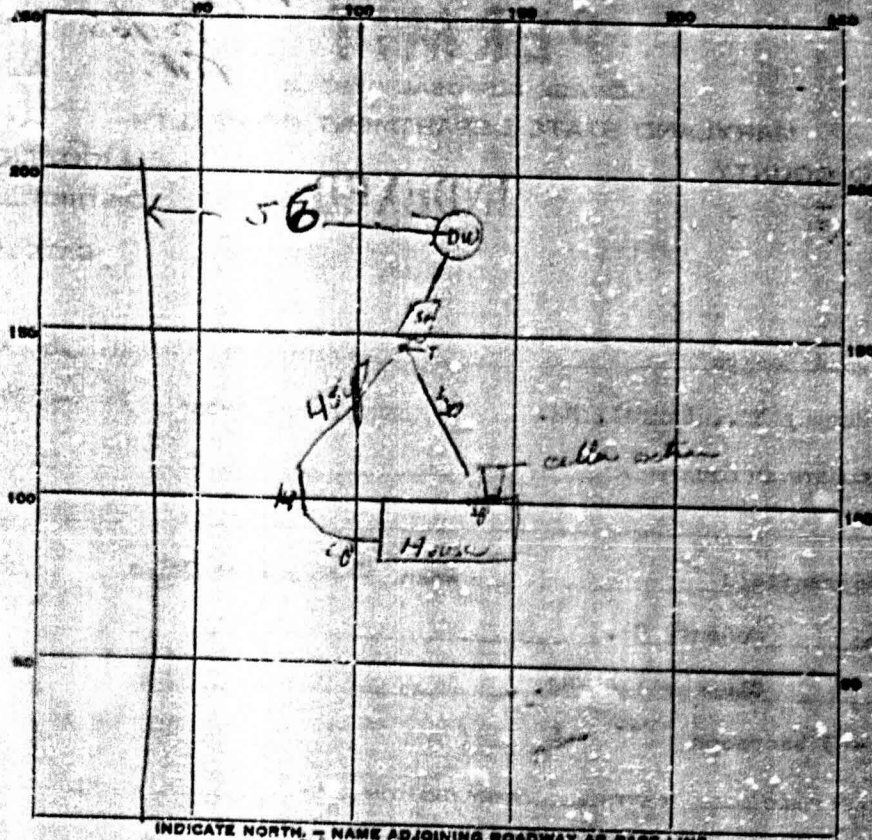

376
8
300.5

INDICATE NORTH - NAME ADJOINING ROADWAY AS BARE LINE.

Cherry Lane Drive

PERMIT CARD OK

SEPTIC TANK, LEVEL OK

CLEANOUTS 2 1/2"

DISTRIBUTION BOX, LEVEL _____

TILE FIELD, DEPTH _____ FT. TRENCH WIDTH _____ FT.

GRAVEL DEPTH _____ IN. TOTAL LENGTH _____ FT.

NUMBER OF TRENCHES _____ TOTAL BOTTOM AREA _____

SEEPAGE PITS, INSIDE-DIAMETER 12 FT. DEPTH BELOW INLET 8 FT.

ABSORBENT AREA 300+ SQ. FT.

REMARKS 7/19/65 - inlet pipe about 4' below grade. - Dig 11' at many locations
will have to extend down to surface in time between the areas tested. To be tested at
5 ft - 7 ft - 12 1/2 ft below grade right next to dig all the way

DATE SYSTEM APPROVED 7/21/65

INSPECTOR R.F. Totten