

APPLICATION

PERCOLATION TESTING

A 517904

F _____

HOWARD COUNTY HEALTH DEPARTMENT

BUREAU OF ENVIRONMENTAL HEALTH

3525-H ELLICOTT MILLS DRIVE/ELLICOTT CITY, MARYLAND 21043
TELEPHONE: 313-2640

DISTRICT _____

DATE 9/5/02

TO: THE COUNTY HEALTH OFFICER
ELLICOTT CITY, MARYLAND

I HEREBY APPLY FOR THE NECESSARY TEST PRIOR TO APPLICATION FOR PERMIT TO CONSTRUCT (OR RECONSTRUCT) A SEWAGE DISPOSAL SYSTEM.

PROPERTY OWNER DORSEY MILL LLC.
ADDRESS 14045 GARED DRIVE PHONE 410-531-8950
GLENWOOD, MD 21738 FAX 410-531-8939

AGENT OR PROSPECTIVE BUYER _____
ADDRESS _____ PHONE _____

PROPERTY LOCATION:

SUBDIVISION DORSEY MILL ROAD LOT NO. _____

ROAD AND DESCRIPTION 14445 DORSEY MILL RD, GLENELG, MD 21737

TAX MAP 21 PARCEL # 227

SIZE OF LOT 53.87 AC. TYPE BLDG. SINGLE FAMILY DWELLING
(SINGLE FAMILY DWELLING OR COMMERCIAL)

THE SYSTEM INSTALLED UNDER THIS APPLICATION IS ACCEPTABLE ONLY UNTIL PUBLIC FACILITIES BECOME AVAILABLE. I FULLY UNDERSTAND THE FEE CONNECTED WITH THE FILING OF THIS PERC TEST APPLICATION IS NON-REFUNDABLE UNDER ANY CIRCUMSTANCES. I ALSO AGREE TO COMPLY WITH ALL M.O.S.H.A. REQUIREMENTS IN TESTING THIS LOT.


(SIGNATURE OF APPLICANT)

APPROVED BY _____ FOR _____ DATE _____

DISAPPROVED BY _____ FOR _____ DATE _____

HOLD PENDING FURTHER TESTS _____

REASONS FOR REJECTION OR HOLDING _____

PERCOLATION TEST PLAT/PRELIMINARY PLAT - TITLE OR I.D. # _____ DATE _____

SITE DEVELOPMENT PLAN/FINAL PLAT - TITLE OR I.D. # _____ DATE _____

THIS IS NOT A PERMIT

517904

NOT TO SCALE

COUNTY #

SOIL PROFILE

3515

0' dark brn 1m
 8" yellow red m to silt 1m
 2' yellow red heavy tm
 1' yellow brn micaceous fine sandy lo
 NO ROCK
 14'8"

3514


SEE 3515

14'


3512

SEE 3515

13'8"

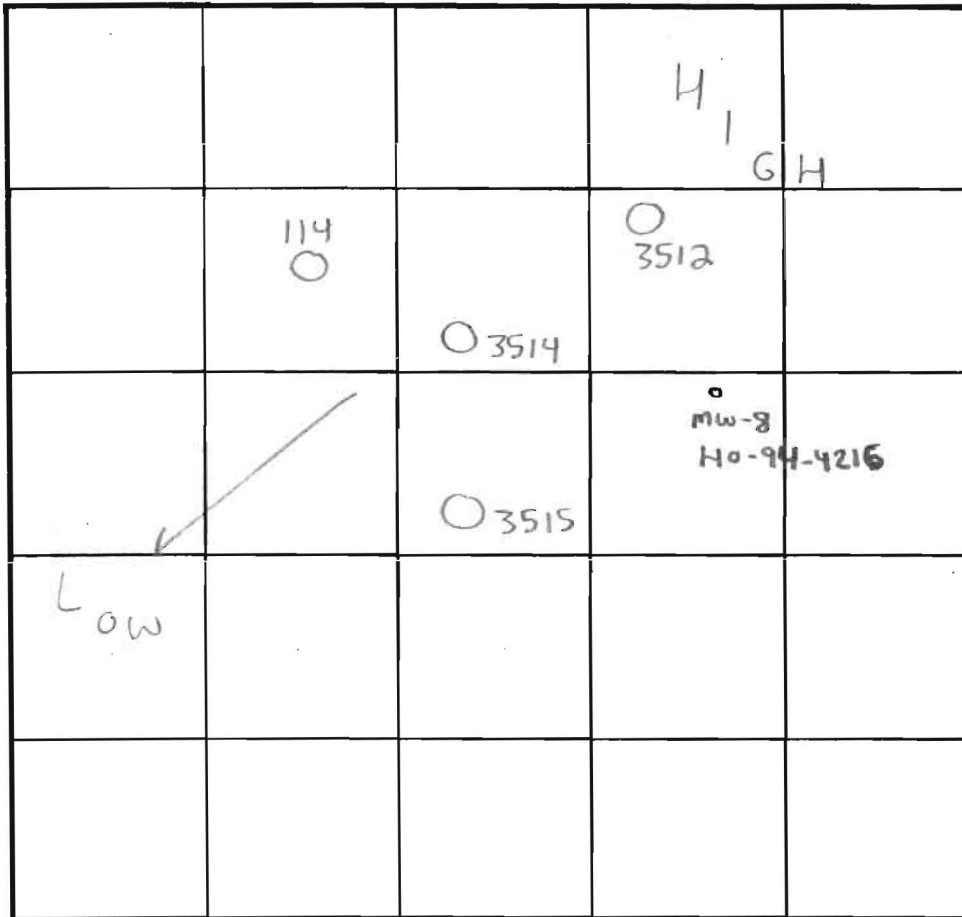

SOIL PROFILE

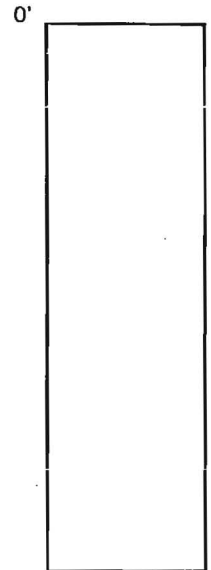

INDICATE NORTH - NAME ADJOINING ROADWAY AS BASE LINE.

DATE	TEST NO.	DEPTH	PRE-WET		TEST - 1" DROP		TIME	
			START	STOP	START	STOP		
12/4/02	3515	14'8" V	(VISUAL OK)	SEE SOIL PROFILE	NA	OK		
	3514	14' V	"	"	"	NA	OK	
	3512	13'8" V	"	"	"	NA	OK	
10/26/98	114	4' T / 18' V	(PREVIOUSLY EVAL. BY PINK LEY)		RON	7min	OK	

REMARKS Holes consistent, Visual holes textured/picked w/trowel

TYPE OF SOIL Glenelg

TESTED BY SRK Donnie Simpson = Backhoe ALSO PRESENT Jim Selfridge - 12/4/02

TRENCH DESIGN DATA: AVERAGE PERCOLATION TIME (Hattfelds) 2-7min TRENCH WIDTH 3'

INLET DEPTH 3.5 MAXIMUM BOTTOM DEPTH 5.5 SQ. FT/BEDROOM 180

Lot 7

