

Make \$15.00 check payable to:
Howard County Health Dept. - Sanitation

A boundary plat must be signed
by the
APPLICATION
Sewer

A 12597

SEWAGE DISPOSAL TESTING

P

MARYLAND STATE DEPARTMENT OF HEALTH

HOWARD COUNTY

ELLICOTT CITY

DISTRICT 4th

Septic Tank - 750 gal.

DATE April 19, 1967

Dry Well - 375 sq ft. absorbent, redwallow area below
inlet pipe. Inlet pipe 2 ft below grade. Max depth permitted
for dry well below original grade is 14 ft.

Place Dry Well at a point about 12 ft in from
lot line parallel with right of way road and about 10 ft
in from wooded area.

TO: THE COUNTY HEALTH OFFICER
ELLICOTT CITY, MARYLAND

I, HEREBY, APPLY FOR THE NECESSARY TESTS IN ORDER TO CONSTRUCT (OR RECONSTRUCT) A SEWAGE
DISPOSAL SYSTEM.

✓ PROPERTY OWNER Edward and Donna M. Brown

✓ ADDRESS 4 Dover Court, Ellicott City, Md. PHONE 465-4785

PROPERTY LOCATION:

SUBDIVISION _____ LOT NO. _____

✓ ROAD AND DESCRIPTION Florence Rd. [Take Rt. 144 West, pass Lisbon, continue to
Long Corner Rd. (at DiPaula's Long View Bar) Left on Long Corner approx. 1 mile to Florence Rd.
Left on Florence Rd about 1/2 mile to property on right.] (See attached Vicinity Map on Plat)

OCCUPANT _____ PHONE _____

PERSON TO CONSTRUCT SYSTEM _____

ADDRESS _____ PHONE _____

✓ SIZE OF LOT 1 acre TYPE BLDG. residential house - 2
NUMBER OF BEDROOMS _____

IF NOT SINGLE RESIDENCE DESCRIBE _____

✓ SIGNATURE OF APPLICANT Edward W. Brown Donna M. Brown

✓ APPROVED BY Donald W. Monaghan FOR Dry Well DATE 5-9-67
(KIND OF SYSTEM)


REJECTED BY _____ FOR _____ DATE _____
(KIND OF SYSTEM)

HOLD PENDING FURTHER TESTS _____ DATE _____

REASONS FOR REJECTION OR HOLDING _____

THIS IS NOT A PERMIT

45/3/9

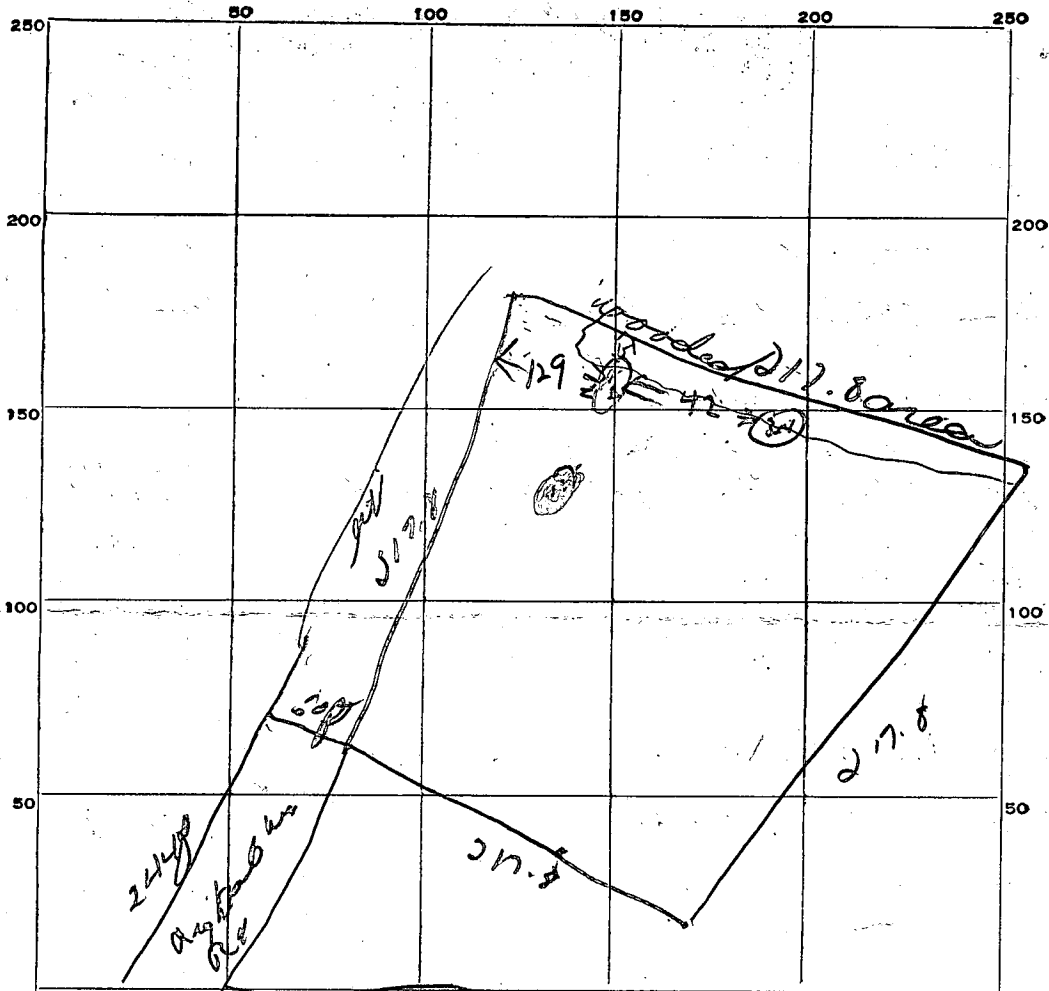

INDICATE NORTH. - NAME ADJOINING ROADWAY AS BASE LINE.

Florence - Long Green Rd

DATE	TEST NO.	DEPTH	PRE-WET		TEST - 1" DROP		TIME	
			START	STOP	START	STOP		
5/9/67	1	4 ft	9 ⁵⁷	10 ¹⁰	10 ¹⁰	10 ³⁰	20 min	
	2	6 ft	9 ⁵⁵	9 ⁵⁶	9 ⁵⁶	10 ⁰⁰	4 min	
	3	4 ft	} not tested - same type soil as hole #1-2 Sand & shale					
	4	9 ft						

SOIL AUGER FINDING

TESTED BY

DM

REMARKS

James Howard Triplett
5/9/67 also present