

CLEAR DRIVE COURT


Approved Septic System Plan
Howard County Health Department

Mark Rifkin
Signature _____ Date 12/14/08

Total linear feet of trench required 280 feet
 Width of trench(es) 3 feet
 Depth of trench(es) 5 feet
 Depth of stone required below distribution pipe 2 feet

Note: Change in Septic tank location OK AP 9/18/07

1500 Gal. Septic Tank
 Inv. In = 535.50
 Inv. Out = 535.20
 Distribution Box
 Ex. Grd = 538.0
 Inv = 535.0

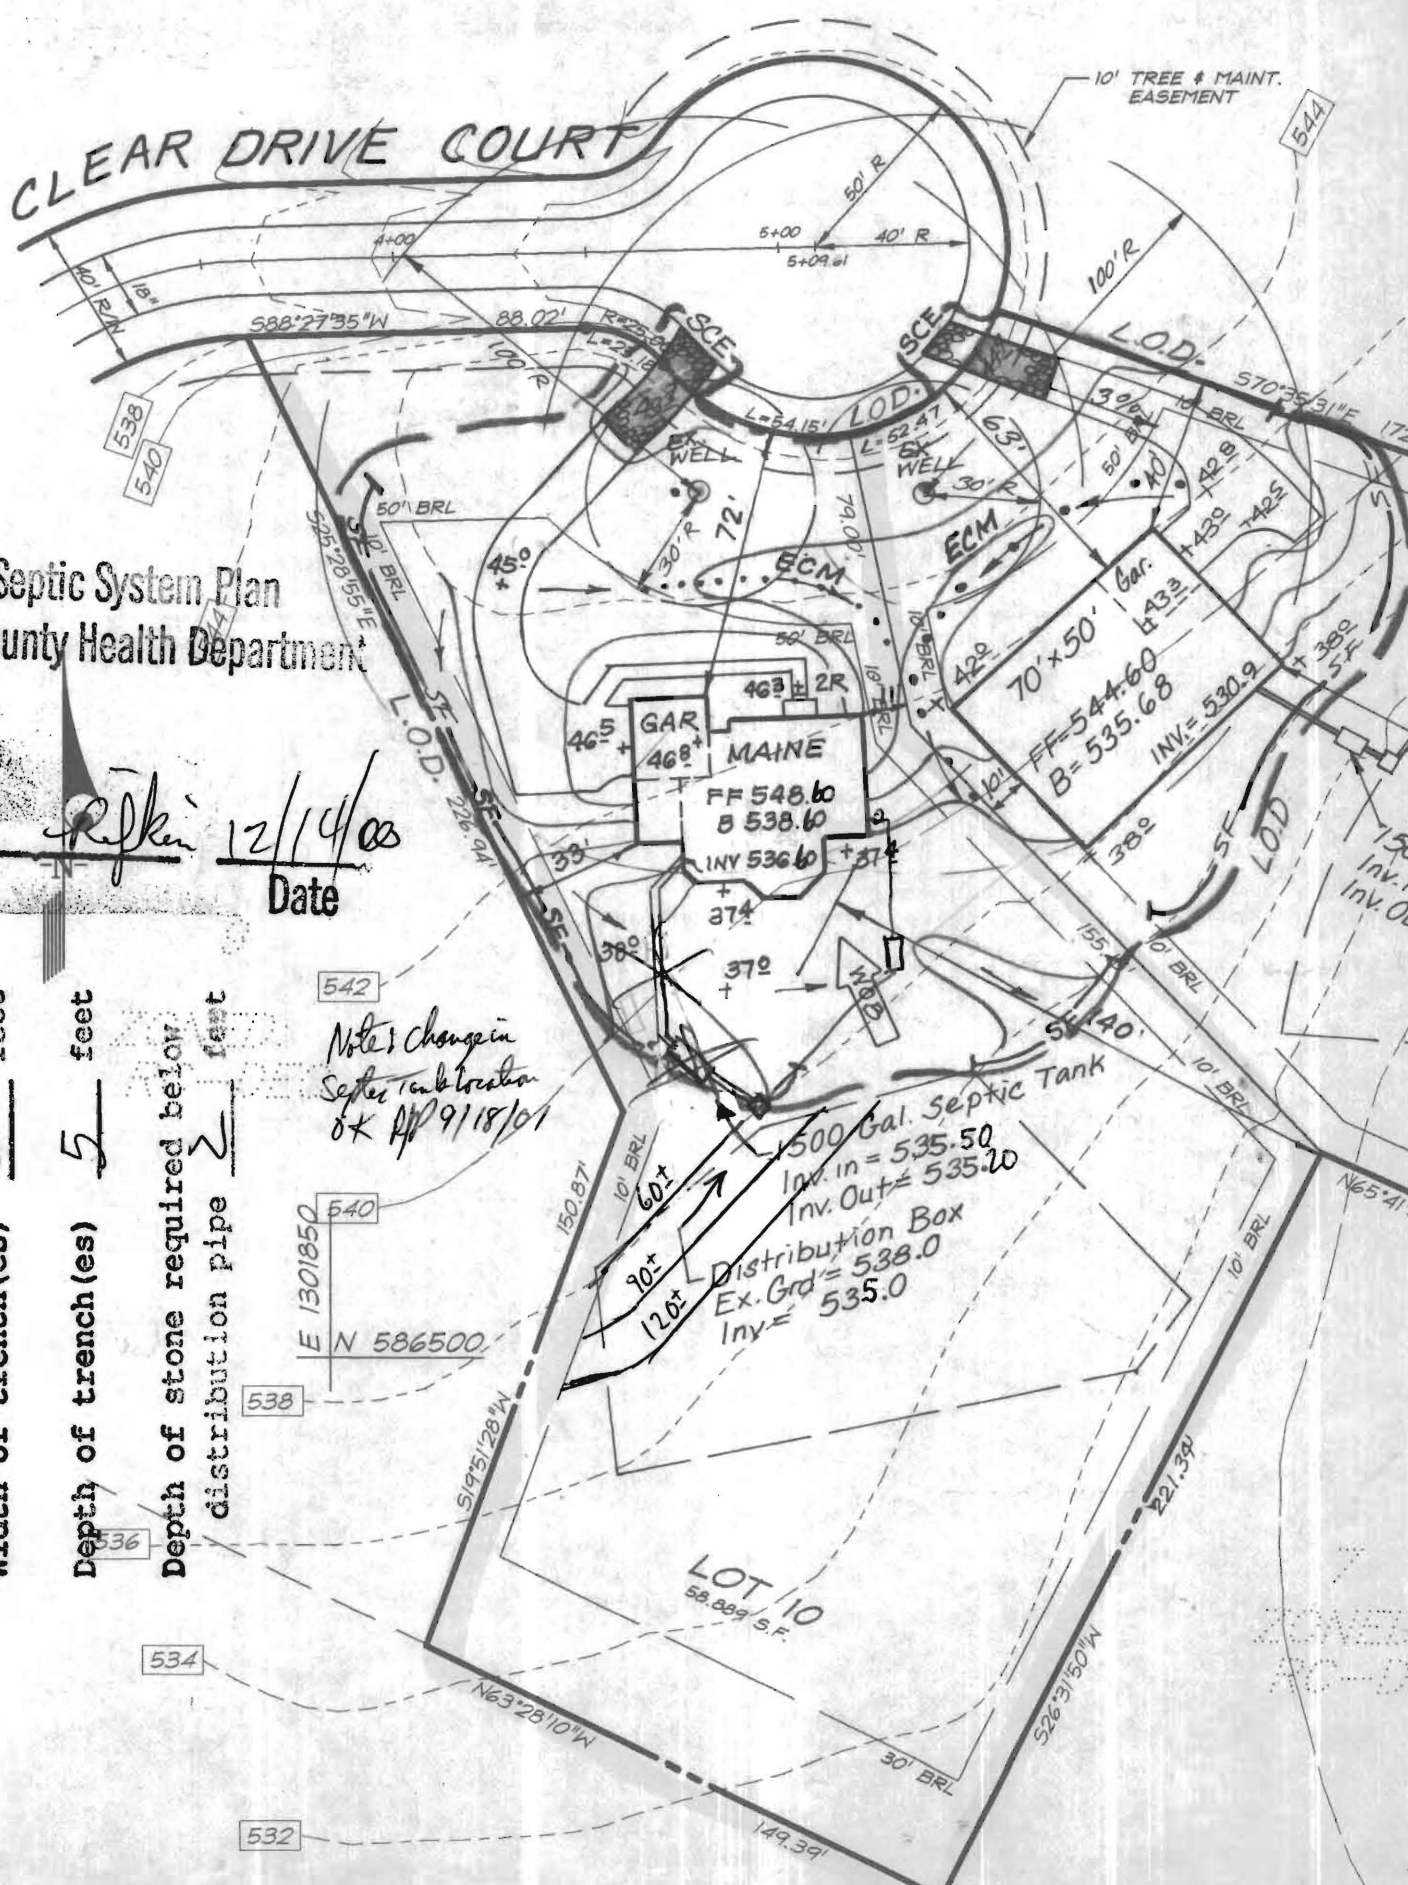

534
532

7
ZONES
AC-D