

PERMIT

SEWAGE DISPOSAL SYSTEM

MARYLAND STATE DEPARTMENT OF HEALTH

HOWARD COUNTY

ELLICOTT CITY

INDEXED

DISTRICT 4

DATE 5/23/67

P 12693

A 12598

copy 6-9-67

about 3:45 pm

*6/9/67
9:30
from Monaghan*

James Triplett

IS PERMITTED TO INSTALL ALTER

ADDRESS Hardy Rd., Mt. Airy, Maryland

PHONE HU 9-4535

A SEWAGE DISPOSAL SYSTEM LOCATED AT _____

SUBDIVISION _____ ROAD Florence Rd. LOT _____

PROPERTY OWNER Edward and Donna M. Brown

ADDRESS _____

SPECIFICATIONS 2 bedrooms

DRAIN FIELD _____ DEPTH _____ FEET, BOTTOM AREA _____ SQ. FT.

SEEPAGE PITS _____ ABSORBENT SIDE-WALL AREA _____ SQ. FT.

SEPTIC TANK CAPACITY 750 GALLONS

FOR GARBAGE GRINDER, INCREASE DISPOSAL AREA 22% & TANK CAPACITY 50%.

OTHER Dry well - 375 sq. ft. absorbent sidewall area below inlet pipe. Inlet pipe 4 ft. below grade. Max. depth permitted for dry well below original grade is 14 ft.

Place dry well at a point about 129 ft. in from lot line parallel with right-of-way road and about 10 ft. in from wooded area.

PERMIT VOID AFTER THREE YEARS.

PLANS APPROVED BY D. W. Monaghan


DATE 5/23/67

FILL SEPTIC TANK AND DISTRIBUTION BOX WITH WATER BEFORE CALLING FOR AN INSPECTION. COVER NO WORK UNTIL INSPECTED AND APPROVED.

NEITHER THE HOWARD COUNTY COMMISSIONERS NOR THE HEALTH DEPARTMENT IS RESPONSIBLE FOR THE SUCCESSFUL OPERATION OF ANY SYSTEM.

NOTIFY THE HEALTH DEPARTMENT 48 HOURS BEFORE EXCAVATIONS ARE TO BE BACK FILLED.

A 12598

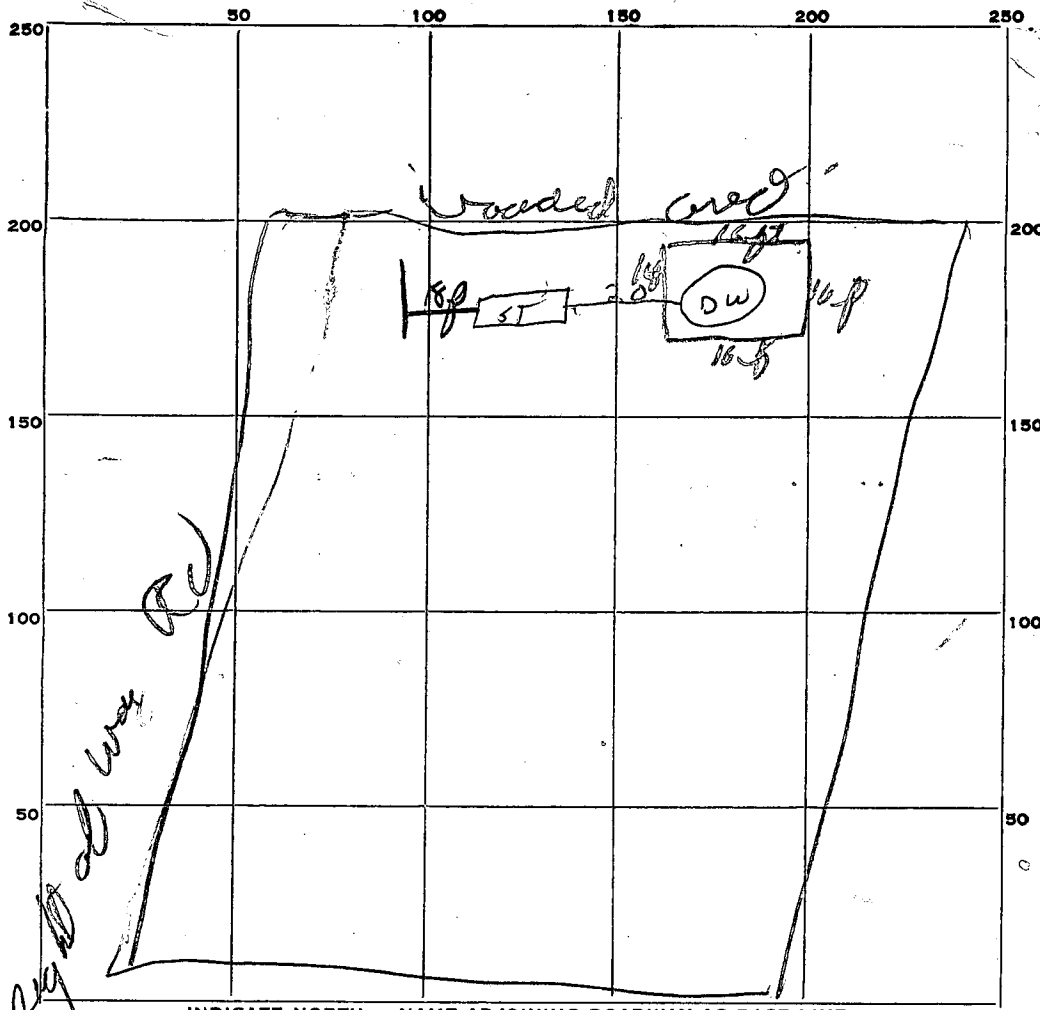

PERMIT CARD _____

SEPTIC TANK, LEVEL OK

CLEANOUTS OK

DISTRIBUTION BOX, LEVEL _____

TILE FIELD, DEPTH _____ FT. TRENCH WIDTH _____ FT.

GRAVEL DEPTH _____ IN. TOTAL LENGTH _____ FT.

NUMBER OF TRENCHES _____ TOTAL BOTTOM AREA _____

SEEPAGE PITS, Perimeter ~~INSIDE~~ DIAMETER 6.4 FT. DEPTH BELOW INLET 5 FT.

ABSORBENT AREA _____ SQ. FT.

REMARKS 6-7-67 not enough gravel - needs about 6 inches load. - have not built - will have to put line from tank to within 5 ft of where house is to be located.

6-9-67 Jpp OK

DATE SYSTEM APPROVED 6-9-67

INSPECTOR Qu. Monaghan