

Prel.

APPLICATION

A 29948

SEWAGE DISPOSAL TESTING

STATE OF MARYLAND - DEPARTMENT OF HEALTH AND MENTAL HYGIENE

P _____

HOWARD COUNTY HEALTH DEPARTMENT
ENVIRONMENTAL HEALTH SERVICES
P O BOX 473 ELLICOTT CITY, MARYLAND 21043
TELEPHONE 992-2330

DISTRICT 3rd

DATE 10/4/83

TO: THE COUNTY HEALTH OFFICER
ELLICOTT CITY, MARYLAND

I HEREBY APPLY FOR THE NECESSARY TEST IN ORDER TO CONSTRUCT (OR RECONSTRUCT) A SEWAGE DISPOSAL SYSTEM.

PROPERTY OWNER WILLIAM M. HAWICE

ADDRESS 7148 LASTING LIGHT WAY, COLUMBIA MD. 21045 PHONE 445-7777 BOENDER ASSOC.

PROPERTY LOCATION: COVENTRY MEADOWS LOT 30 SECT 2 Lot-15 Prelim

SUBDIVISION HAWICES LANDING LOT NO. 7

ROAD AND DESCRIPTION MD. RTE. 32 (WEST SIDE) 4400'± NORTH OF OLD FREDERICIC RD. TO BEGINNING OF SITE

SIZE OF LOT 3 ACRES TYPE BLDG. 3/4
(NUMBER OF BEDROOMS)

THE SYSTEM INSTALLED UNDER THIS APPLICATION IS ACCEPTABLE ONLY UNTIL PUBLIC FACILITIES BECOME AVAILABLE. I FULLY UNDERSTAND THE FEE CONNECTED WITH THE FILING OF THIS PERC TEST APPLICATION IS NON-REFUNDABLE UNDER ANY CIRCUMSTANCES. I ALSO AGREE TO COMPLY

WITH ALL M.O.S.H.A. REQUIREMENTS IN TESTING THIS LOT. John J. Barkard (agent)
(SIGNATURE OF APPLICANT)

APPROVED BY _____ FOR _____ DATE _____

REJECTED BY _____ FOR _____ DATE _____

HOLD PENDING FURTHER TESTS _____ DATE _____

REASONS FOR REJECTION OR HOLDING 10/17/83 Per OK Hoed for Plat B/D

THIS IS NOT A PERMIT

Prel.

APPLICATION

SEWAGE DISPOSAL TESTING

STATE OF MARYLAND - DEPARTMENT OF HEALTH AND MENTAL HYGIENE

HOWARD COUNTY HEALTH DEPARTMENT
ENVIRONMENTAL HEALTH SERVICES
P O BOX 473 ELLICOTT CITY MARYLAND 21043
TELEPHONE 992 2330

A 29948

P _____

DISTRICT 3rd

DATE 10/4/83

TO: THE COUNTY HEALTH OFFICER
ELLICOTT CITY, MARYLAND

I HEREBY APPLY FOR THE NECESSARY TEST IN ORDER TO CONSTRUCT (OR RECONSTRUCT) A SEWAGE DISPOSAL SYSTEM.

PROPERTY OWNER WILLIAM M. HAWICE

ADDRESS 7148 LASTING LIGHT WAY, COLUMBIA MO. 21045 PHONE 465-7777 BOENDER ASSOC.

PROPERTY LOCATION:

SUBDIVISION HAWKES LANDING LOT NO. 7

ROAD AND DESCRIPTION MD. RTE. 32 (WEST SIDE) 4400' NORTH OF OLD FREDERICK
RD. TO BEGINNING OF SITE

SIZE OF LOT 3 ACRES TYPE BLDG. 3/4
(NUMBER OF BEDROOMS)

THE SYSTEM INSTALLED UNDER THIS APPLICATION IS ACCEPTABLE ONLY UNTIL PUBLIC FACILITIES BECOME AVAILABLE. I FULLY UNDERSTAND THE FEE CONNECTED WITH THE FILING OF THIS PERC TEST APPLICATION IS NON-REFUNDABLE UNDER ANY CIRCUMSTANCES. I ALSO AGREE TO COMPLY WITH ALL M.O.S.H.A. REQUIREMENTS IN TESTING THIS LOT.

John J. Barford (agent)
(SIGNATURE OF APPLICANT)

APPROVED BY _____ FOR _____ DATE _____

REJECTED BY _____ FOR _____ DATE _____

HOLD PENDING FURTHER TESTS _____ DATE _____



REASONS FOR REJECTION OR HOLDING _____

THIS IS NOT A PERMIT

Lot 15 SECT 2
 COVENTRY
 MEADOWS


A 29948

LOT

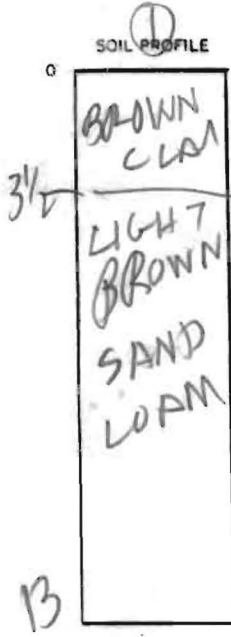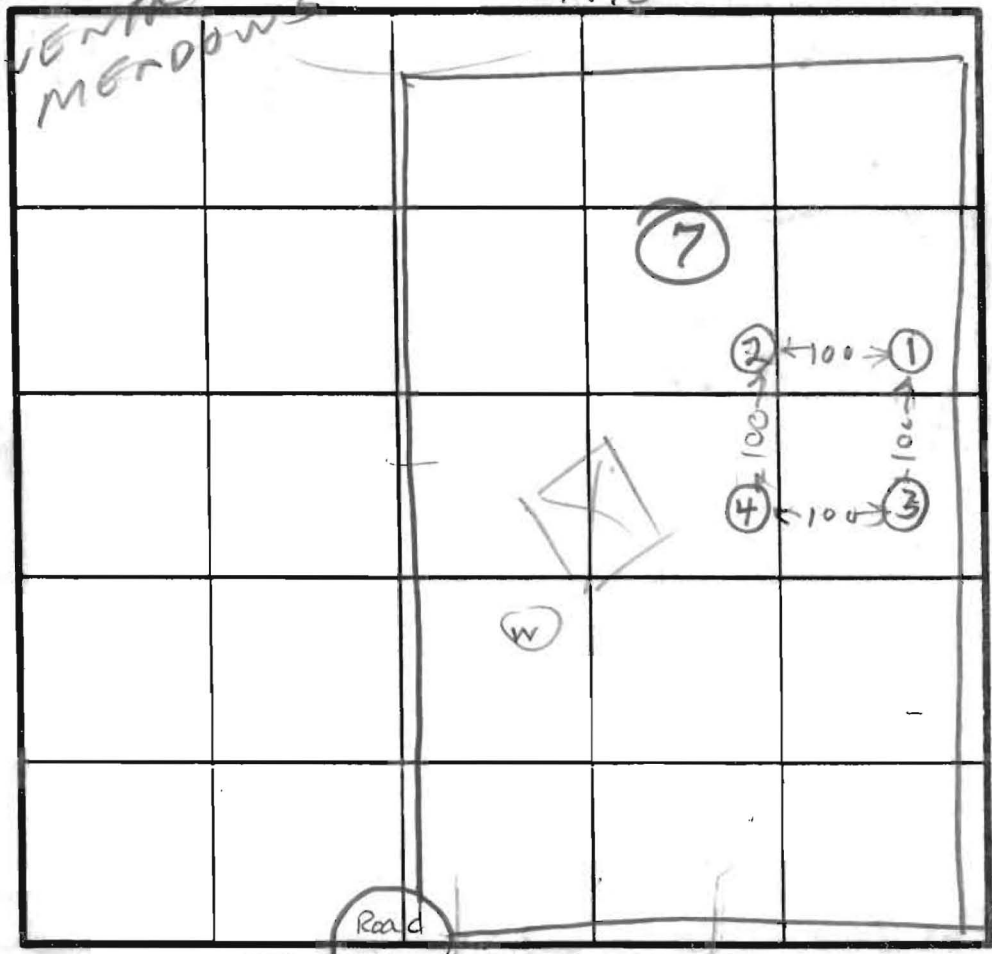

HOLE ELEVATION

②④ = HIGH
 ①③ = LOW

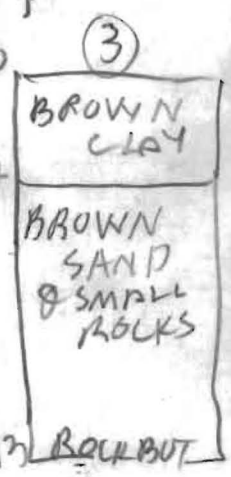

INDICATE NORTH - NAME ADJOINING ROADWAY AS BASE LINE
 Road A

DATE	TEST NO.	DEPTH	PRE-WET		TEST - 1" DROP		TIME
			START	STOP	START	STOP	
10/17/83	1S	4	1032	1033	1035	1036	3
	1N	9	1032	1034	1034	1037	3
	1V	13	LOOKS		OK		
	2S	3	1034	1035	1035	1038	3
	2N	8	1034	1035	1035	1038	3
	2V	13	LOOKS		OK		
	3S	6	1040	1041	1041	1044	3
	3V	13	LOOKS		OK		
10/17/83	4V	13 1/2	LOOKS		OK		

TRENCH BETWEEN ② & ④

AV TIME 3 MIN

MAX DEPTH 2F7

REMARKS PERC HOLES AVG PER PLAT R/H

TYPE OF SOIL

TESTED BY R. HODGES

ALSO PRESENT JACK FYOCH & MEN

E112 10/17/83