

B08001914

INV. @ HOUSE	548.0
GROUND @ INV. @ HOUSE	553.8
INV. IN TANK	547.3
INV. OUT TANK	547.0
TOP OF TANK	548.3
GROUND OVER TANK	551.2
INV. IN DIST. BOX	546.9
INV. OUT DIST. BOX	546.6
GROUND @ BOX	551.1

WELL No. HO-95-0771

Approved Septic System Plan
Howard County Health Department

[Signature]
Signature

[Date]
Date

CORYS COURT

ADDRESS: 14621 CORYS COURT
GLENELG, MD 21737


BUILDING SETBACKS (B.R.L.'s) SHOWN HEREON PER SITE DEVELOPMENT PLAN SETBACK DISTANCES SHOWN HEREON AS "±" HAVE AN ACCURACY OF ±0.1' FOOT.

THE EXISTING WELL(S) SHOWN ON THIS PLAN (IDENTIFIED WITH THE ATTACHED WELL TAG NUMBER HO-95-0771) HAS BEEN FIELD LOCATED BY ESE CONSULTANTS, INC. - PROFESSIONAL LAND SURVEYOR(S), AND IS ACCURATELY SHOWN.

TYPE: HAMPTON (COLONIAL)
DAYLIGHT BASEMENT
ADD'L 1' TO HEIGHT OF BASEMENT
EXPANDED FAMILY ROOM
CONSERVATORY ELITE ADDITION
BRICK TO GRADE SIDES

OPTION No. 018
OPTION No. 070
OPTION No. 023
OPTION No. 039
OPTION No. 90014001

PLOT PLAN
LOT #14
EDGEWOOD FARM
LIBER 4174, FOLIO 0436
PLAT No. 19266, et seq
FOURTH ELECTION DISTRICT
HOWARD COUNTY, MARYLAND

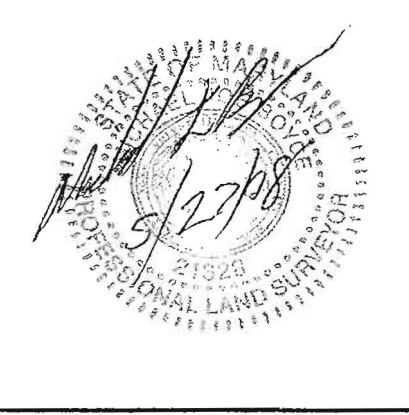

ESE Land Planning
Engineering
Land Surveying

ESE Consultants Inc.
7164 Columbia Gateway Dr.
Suite 203
Columbia, MD 21046
TEL: 410-872-9105
FAX: 410-872-4870

DATE: 05/23/08 SCALE: 1"=40' FILE: LOT 14
CHK'D: MJB JOB#: 1498 DRAWN: CRC