

ISSUE DATE:

1/18/2002

P 516479-A

APPROVAL DATE:

2/11/02

A 515027

PERMIT INDEXED

ON-SITE SEWAGE DISPOSAL SYSTEM HOWARD COUNTY HEALTH DEPARTMENT BUREAU OF ENVIRONMENTAL HEALTH

03-317242

K & K Excavating

IS PERMITTED TO INSTALL ALTER

ADDRESS: 14960 Frederick Road 21797 PHONE NUMBER: 410-442-1336

SUBDIVISION: Meadowood LOT NUMBER: 55

ADDRESS: 1319 Crows Foot Road PROPERTY OWNER: Selfridge Builders

SEPTIC TANK CAPACITY (GALLONS): 1000

PUMP CHAMBER CAPACITY (GALLONS): N/A

NUMBER OF BEDROOMS: 3

SQUARE FEET PER BEDROOM: 180

LINEAR FEET OF TRENCH REQUIRED: 180

TRENCHES:	Trench to be 3.0 feet wide. Inlet 2.5 feet below original grade. Bottom maximum depth 4.5 feet below original grade. Effective area begins at 3.5 feet below original grade. 2.0 feet of stone below distribution pipe.
LOCATION:	Place the Distribution Box 190' from the right lot line (347.22) and 135' from the front lot line as viewed from Cedarberry Court. Install two 90 foot trenches on contour toward the left lot line.
NOTES:	KEEP TRENCHES OUT OF THE 100 FOOT WELL RADIUS FOR THE NEIGHBORING LOT (MEADOWOOD LOT 54)

PLANS APPROVED: SRK 10/23/01 OK (SR) DATE: 10/15/01

NOTE: PERMIT VOID AFTER 2 YEARS

NOTE: CONTRACTOR RESPONSIBLE FOR SCHEDULING A PRE-CONSTRUCTION INSPECTION FOR ALL INSTALLATIONS

NOTE: WATERTIGHT SEPTIC TANKS REQUIRED

NOTE: ALL PARTS OF SEPTIC SYSTEM SHALL BE 100 FEET FROM ANY WATER WELL

NOTE: MANHOLE RISERS REQUIRED ON ALL SEPTIC TANKS AND PUMP CHAMBERS

**NEITHER THE HOWARD COUNTY COUNCIL NOR THE HEALTH DEPARTMENT IS
RESPONSIBLE FOR THE SUCCESSFUL OPERATION OF ANY SYSTEM
PERMITTEE RESPONSIBLE FOR OBTAINING FINAL APPROVAL ON THIS PERMIT
CALL 410-313-2640 FOR INSPECTION OF SEPTIC SYSTEM**


**BUILDING PERMIT SIGNED
AND RETURNED** 2/27/02
B00134535-UG TANK
B00134582-DECK

A515027

NOT TO SCALE

CEDARBERRY CT

AK Wall
10-92-0441

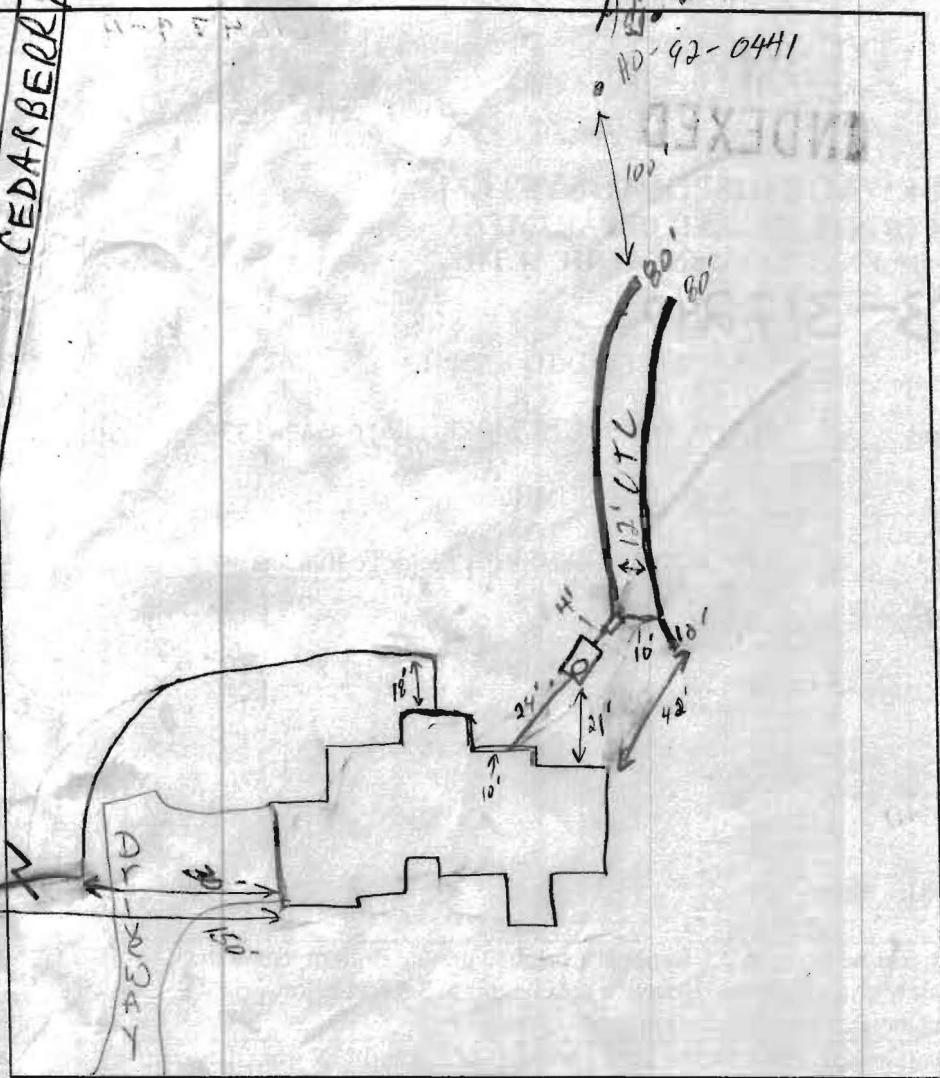

TRENCH DATA

TRENCH WIDTH 3'
 TRENCH INLET DEPTH 2.5'
 TRENCH BOTTOM DEPTH 4.5'
 DEPTH OF STONE 2'
 NUMBER OF TRENCHES 2
 TOTAL TRENCH LENGTH 170
 ABSORBENT AREA 510 #
 DISTRIBUTION BOX LEVEL Yes
 BAFFLE IN DISTRIBUTION BOX Yes - Block

SEPTIC TANK DATA

SEPTIC TANK 1500 T.S. GALLONS
 MANHOLE RISER Front
 6 INCH INSPECTION PORT N/A

PUMP CHAMBER DATA

PUMP CHAMBER GALLONS _____
 MANHOLE RISER N/A
 ALARM _____
 PUMP PERFORMANCE TEST _____

CROWS FOOT RD

PRE-CONSTRUCTION INSPECTION: 2/3/02 SHA appears 10' to close to neighbors wall.

Can only get 80' on 1st trench (EO)

INSPECTION COMMENTS: 2/5/02 Came back. Oden Sr & Jr very abusive. Stuart & I called Mark to verify ok for "t" out of d.b. for 10' of first trench running parallel toward front of house & 80' toward the rear lot line. (SO/KG) 2/4/02 ok to cover except house conn (not made yet) & 2/11/02 house conn made (S)

INSPECTOR [Signature]

DATE SYSTEM APPROVED 2/11/02

BUILDING PERMITS DIVISION AND RETURNED

