

01/10/01
10:00

Repair (Permit Installation)

11/27/01 Notime Known

11/28/01 - 10:00 Final

ISSUE DATE:

9/25/01



PERMIT

P 516044

APPROVAL DATE:

12/26/02

A REPAIR

INDEXED

ON-SITE SEWAGE DISPOSAL SYSTEM HOWARD COUNTY HEALTH DEPARTMENT BUREAU OF ENVIRONMENTAL HEALTH

04-344979

Freedom Septic _____ IS PERMITTED TO INSTALL ALTER

ADDRESS: 239 West Old Liberty Road PHONE NUMBER: 410-795-2947

SUBDIVISION: Byong Yoo Property LOT NUMBER: 4

ADDRESS: 3200 Daisy Road PROPERTY OWNER: Steve Fitzgerald

SEPTIC TANK CAPACITY (GALLONS): 1250 TS as discussed with septic contractor on 11/21/01

PUMP CHAMBER CAPACITY (GALLONS): 1250 TS
N/A

NUMBER OF BEDROOMS: (total) 4

SQUARE FEET PER BEDROOM: 210

LINEAR FEET OF TRENCH REQUIRED: 210 (2 x 105' is acceptable)

TRENCHES: <i>11/16/01 per telephone description of trench location per permit</i>	Trench to be 2 feet wide. Inlet 3 feet below original grade. Bottom maximum depth 7 feet below original grade. Effective area begins at 3 feet below original grade. 4 feet of stone below distribution pipe.
LOCATION:	<i>upper part of area tested, to be determined on future perc test plan. Run trenches on contour.</i>
PURPOSE:	In support of building permit B00132236. Call for inspection when ground is opened so sanitarian can recommend repair.


PLANS APPROVED: _____ DATE: 11/16/01

- NOTE: PERMIT VOID AFTER 2 YEARS
- NOTE: CONTRACTOR RESPONSIBLE FOR SCHEDULING A PRE-CONSTRUCTION INSPECTION FOR ALL INSTALLATIONS
- NOTE: WATERTIGHT SEPTIC TANKS REQUIRED
- NOTE: ALL PARTS OF SEPTIC SYSTEM SHALL BE 100 FEET FROM ANY WATER WELL
- NOTE: MANHOLE RISERS REQUIRED ON ALL SEPTIC TANKS AND PUMP CHAMBERS

NEITHER THE HOWARD COUNTY COUNCIL NOR THE HEALTH DEPARTMENT IS RESPONSIBLE FOR THE SUCCESSFUL OPERATION OF ANY SYSTEM PERMITTEE RESPONSIBLE FOR OBTAINING FINAL APPROVAL ON THIS PERMIT CALL 410-313-2640 FOR INSPECTION OF SEPTIC SYSTEM

PS16044

2 - 2' padding of pea gravel material
 12 - 5' few rocks
 Rocks Near Bottom NOT TO SCALE

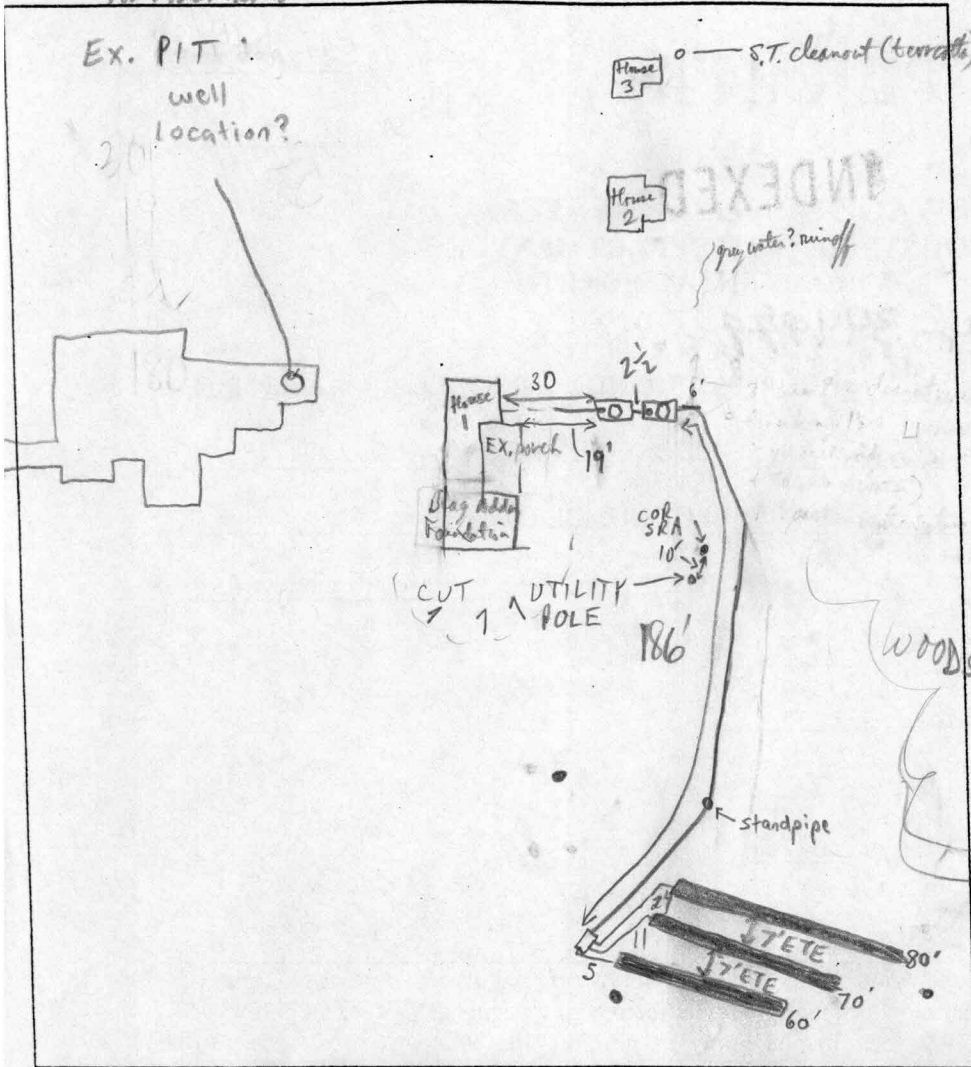

TRENCH DATA	
TRENCH WIDTH	2'
TRENCH INLET DEPTH	3'
TRENCH BOTTOM DEPTH	7'
DEPTH OF STONE	4'
NUMBER OF TRENCHES	3
TOTAL TRENCH LENGTH	210'
ABSORBENT AREA	870 sq ft
DISTRIBUTION BOX LEVEL	✓
BAFFLE IN DISTRIBUTION BOX	4" on " " " " ✓

SEPTIC TANK DATA	
SEPTIC TANK	1250 TS GALLONS
MANHOLE RISER	CENTER
6 INCH INSPECTION PORT	FRONT
PUMP CHAMBER DATA	
PUMP CHAMBER GALLONS	1250 TS
MANHOLE RISER	CTR, 6" @ FRONT
ALARM	
PUMP PERFORMANCE TEST	

10/10/01 I visited site - No septic people here, only builders working on jobs - called - appt was reached for next week.
 PRE-CONSTRUCTION INSPECTION: I checked site - unable to locate existing septic system for this house - service 3 houses
 maybe on one septic system (beside House #3) I recommend a Fall 4' draw septic be installed for House #1 only. PMP 11/10/01

INSPECTION COMMENTS: Unable to get to site due to other inspection commitments, I gave design to
 telephone to contractor based on his description of percolation (He'll leave open on tomorrow's inspection to
 write a detailed description @ time of inspection

11/27/01 12:00 OK, CONTINUE (MR) 11/27/01 3:40 OK TO COVER 2 TRENCHES,
 INSTALL 3RD; OK TO COVER MIDDLE OF 3RD TRENCH; INSTALL PORT @ D.B. &
 MARKER @ LAST BEND IN PRESSURE LINE BEFORE D.B. 11/28/01 - OK TO COVER ALL
 WORK, PUMP & ALARM TEST STILL NEEDED (SRK/MS) 12/26/02 TEST REQUESTED
 NO PUMP/ALARM

INSPECTOR M. Ripkin DATE SYSTEM APPROVED 12/26/02

12/26/02 CONT'D: T/C w/OWNER CONFIRMS PUMP & ALARM OPERATIONAL;
 FILE CLOSED (MR)