

8/2/77
~~9:30 a.m.~~
9:30 a.m.

APPLICATION

A 26361

SEWAGE DISPOSAL TESTING

P _____

STATE OF MARYLAND - DEPARTMENT OF HEALTH AND MENTAL HYGIENE

DISTRICT 2nd

HOWARD COUNTY HEALTH DEPARTMENT
ENVIRONMENTAL HEALTH SERVICES

DATE 6-30-77

P. O. BOX 476, ELLICOTT CITY, MARYLAND 21043
TELEPHONE: 465-5000, EXT. 356

2 day wells 10x10, in 4' max depths 10'

1 50' from ROW (Hole 1) 1 20' away towards hole 5.

Probably Tax Map 18 Parcel 350 (Closest by shape)

TO: THE COUNTY HEALTH OFFICER
ELLICOTT CITY, MARYLAND

I, HEREBY, APPLY FOR THE NECESSARY TEST IN ORDER TO CONSTRUCT (OR RECONSTRUCT) A SEWAGE DISPOSAL SYSTEM.

PROPERTY OWNER Joan Collins Warren Kuhn, John Kuhn

ADDRESS 2257 Daniels Rd., Ellicott City, Md. PHONE 465-8185

PROPERTY LOCATION: _____

SUBDIVISION _____ LOT NO. _____

ROAD AND DESCRIPTION 2257 Daniels Rd. - Drive on right - metal gate with Gas & Electric sign - 1/2 mile from Rte. 99.

SIZE OF LOT 1.6A TYPE BLDG. 3 NUMBER OF BEDROOMS _____

IF NOT SINGLE RESIDENCE DESCRIBE _____

THE SYSTEM INSTALLED UNDER THIS APPLICATION IS ACCEPTABLE ONLY UNTIL PUBLIC FACILITIES BECOME AVAILABLE

SIGNATURE OF APPLICANT Joan Collins


APPROVED BY [Signature] FOR 210' diam day wells DATE 8/8/77
(KIND OF SYSTEM)

REJECTED BY _____ FOR _____ DATE _____
(KIND OF SYSTEM)

HOLD PENDING FURTHER TESTS _____ DATE _____

REASONS FOR REJECTION OR HOLDING _____

THIS IS NOT A PERMIT

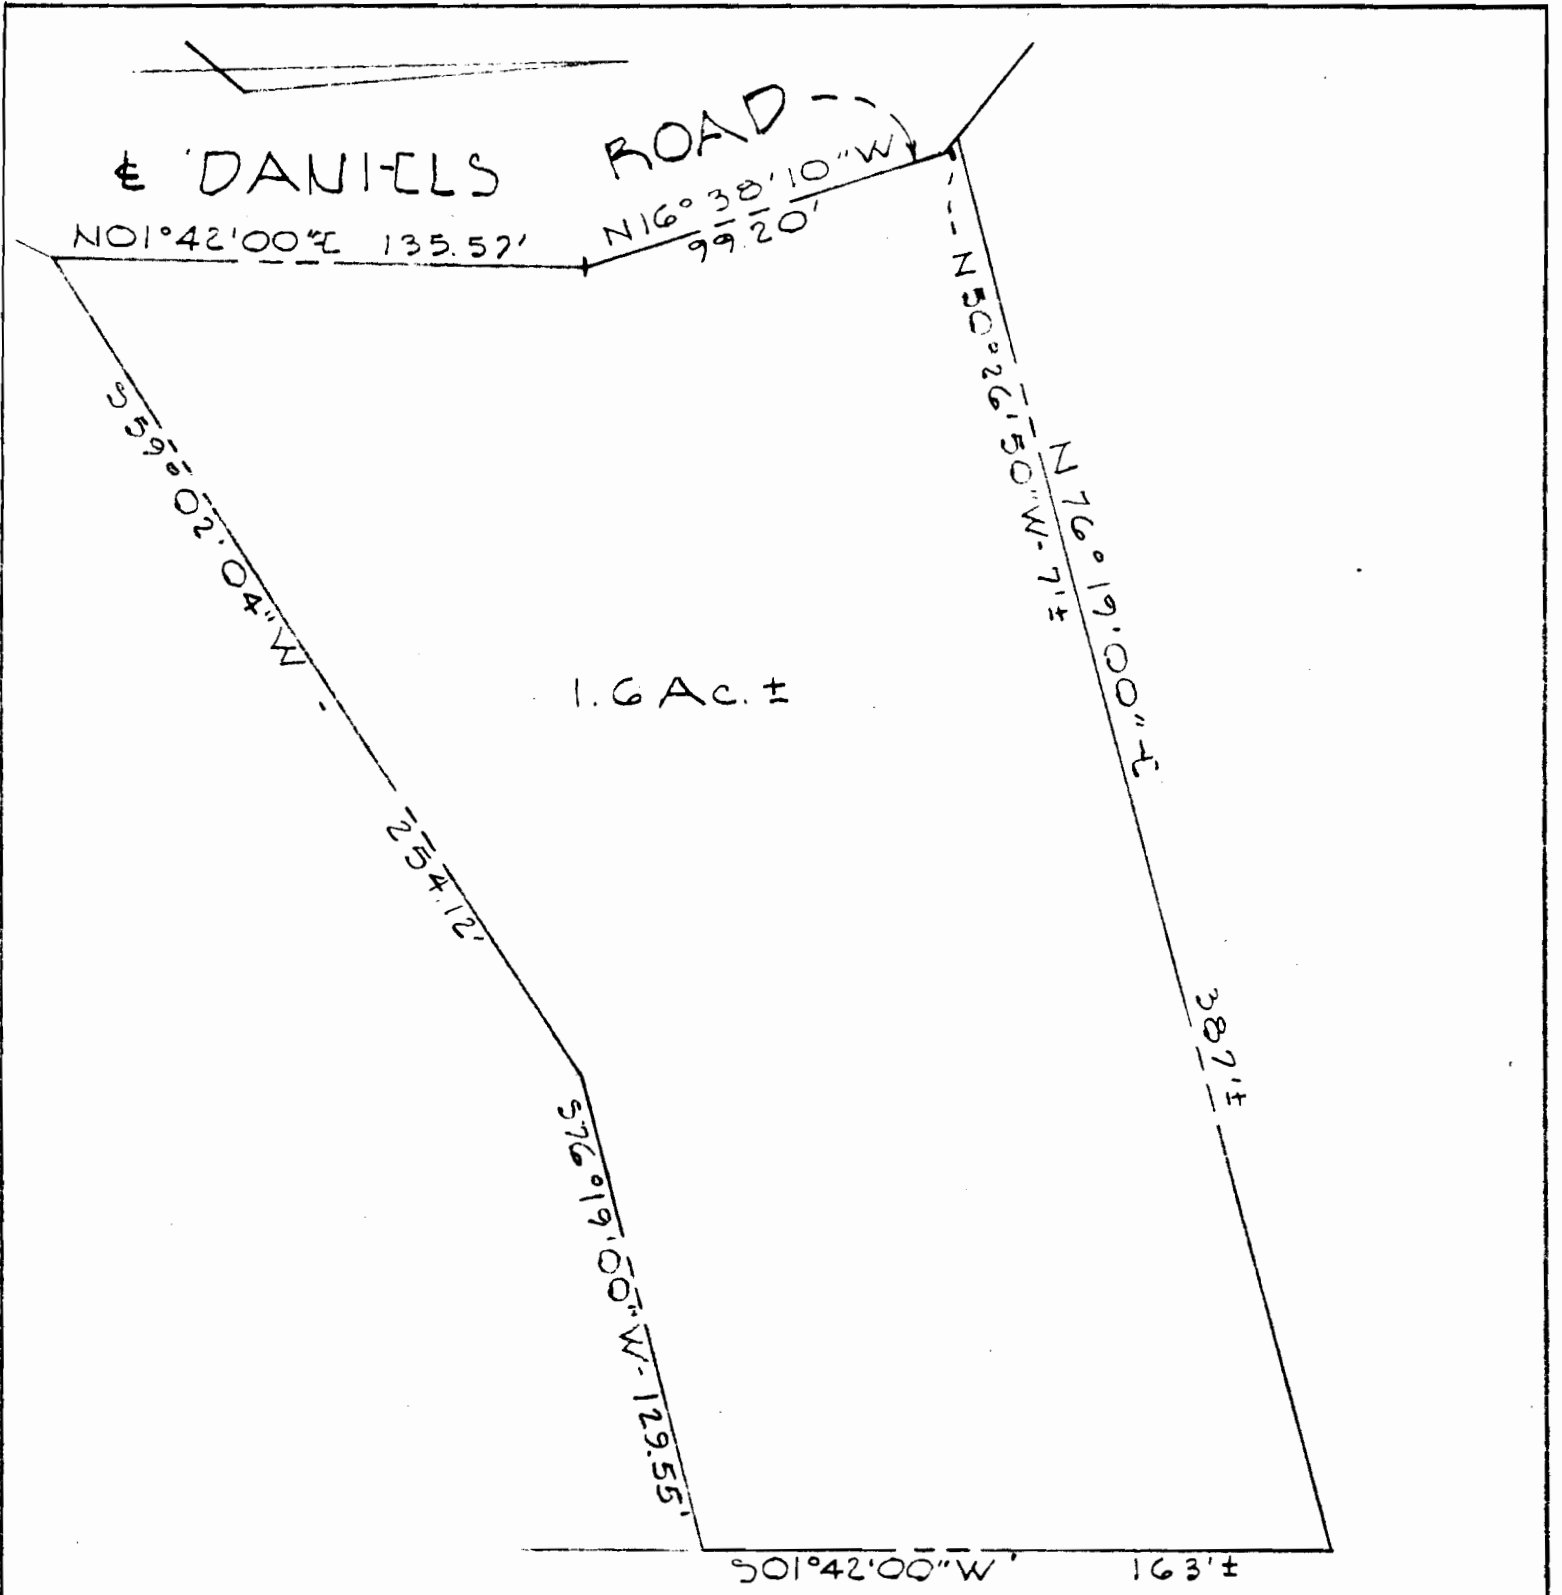


APPROVED: FOR PRIVATE WATER AND PRIVATE
 SEWERAGE SYSTEM, HOWARD COUNTY HEALTH DEPT.

 COUNTY HEALTH OFFICER DATE

PURDUM & ESCHKE
 CONSULTING ENGINEERS
 LAND SURVEYORS
 1023 N. CALVERT STREET
 BALTIMORE, MARYLAND 21202

PROPERTY OF
 JOHN C. KUHN, JR., ET AL
 2ND ELECTION DISTRICT
 HOWARD COUNTY, MARYLAND
 JUNE 9, 1976
 SCALE: 1" = 50'

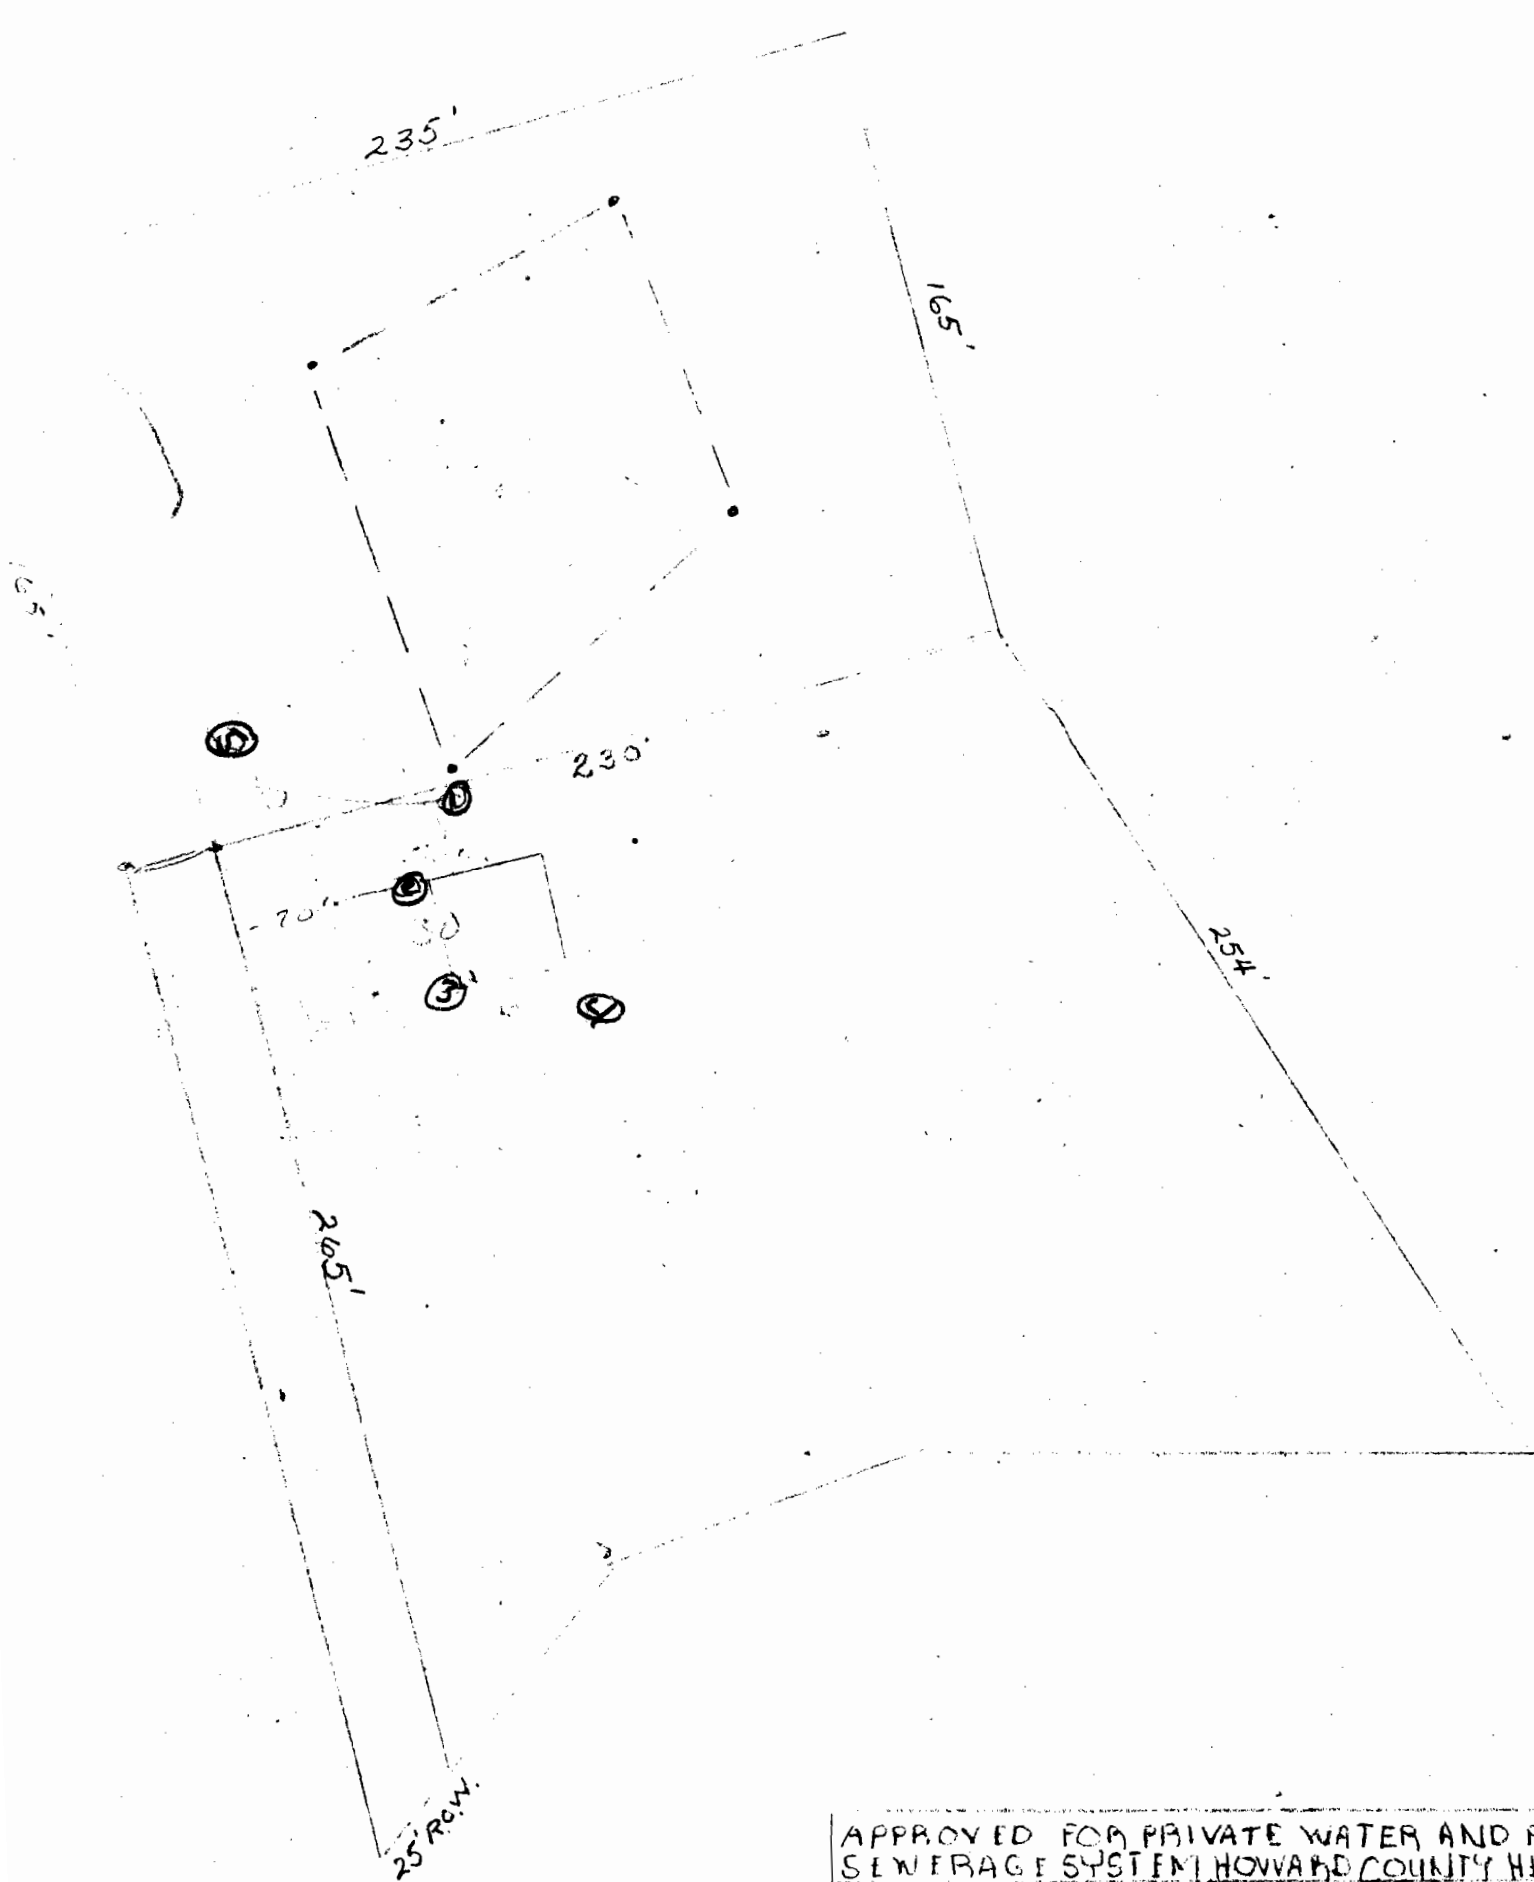

APPROVED FOR PRIVATE WATER AND PRIVATE SEWERAGE SYSTEM HOWARD COUNTY HEALTH

COUNTY HEALTH OFFICER _____ DATE _____

PUMDUM / JESCHKE

PROPERTY OF
 JOHN C. KUHN, JR. ET AL
 2nd ELECTION DISTRICT
 HOWARD COUNTY, MARYLAND
 AUG. 30, 1976
 SCALE 1"=50'