

04-500111

PERMIT

P P514965

SEWAGE DISPOSAL SYSTEM HOWARD COUNTY HEALTH DEPARTMENT BUREAU OF ENVIRONMENTAL HEALTH 410-313-2640

A 41984

ISSUE DATE 3/7/200

APPROVAL DATE 4/2/01

3/20/01
10:00
4/2/01 pm

INDEXED

Amir Dahan (B T Plumbing) IS PERMITTED TO INSTALL ALTER

ADDRESS 6824 Industrial Drive, #105, Beltsville, MD 20705 PHONE 301-996-3444

SUBDIVISION Choi Property LOT NUMBER 21 ADDRESS 3332 Danmark Drive

PROPERTY OWNER Amir Dahan PROPERTY OWNER'S ADDRESS 6824 Industrial Dr, #105
Beltsville, MD 20705

SEPTIC TANK CAPACITY 1500 GALLONS

PUMP CHAMBER CAPACITY N/A GALLONS

NUMBER OF BEDROOMS 5

SQUARE FEET PER BEDROOM 180

LINEAR FEET OF TRENCH REQUIRED 300

TRENCHES: Trenches to be 3 feet wide. Inlet 3 feet below original grade. Bottom maximum depth 5 feet below original grade. 2 feet of stone below distribution box.

LOCATION: Starting at the lot corner at the end of the flagstem driveway, place the distribution box 75 feet down the 275.00' lot line and 75 feet off this same lot line. Run trenches on contour in both directions as shown on plan

Trenches should be 7' edge to edge (10' center to center) to conserve future septic area. - This is for this job only! Assuming contour allows.

PLANS APPROVED Mark Rifkin, R.S. OKSRU 11/15/00 DATE 11/1/2000

PERMIT VOID AFTER 2 YEARS

NOTE: CONTRACTOR RESPONSIBLE FOR SCHEDULING A PRE-CONSTRUCTION INSPECTION FOR ALL INSTALLATIONS

NOTE: TOP OF SEPTIC TANKS ARE TO BE NO DEEPER THAN 3.0 FEET BELOW FINISH GRADE

BLDG. PERMIT SIGNED

NOTE: WATERTIGHT SEPTIC TANKS REQUIRED

AND RETURNED 4/6/01

NOTE: CLEANOUT REQUIRED EVERY 70 FEET OF SEWER LINE AND/OR AT 90° SWEEPS IN LINES FROM HOUSE TO DRAIN FIELDS, 90° ELBOWS ARE NOT ACCEPTABLE

000129173 Proxima Tank

NOTE: ALL PARTS OF SEPTIC SYSTEMS (I.E. TANK, DISTRIBUTION BOX, DRAINFIELDS) TO BE 100 FEET FROM ANY WATER WELL UNLESS OTHERWISE SPECIFICALLY AUTHORIZED

NOTE: NO ABSORPTION TRENCH TO EXCEED 100 FEET IN LENGTH UNLESS SPECIFICALLY AUTHORIZED

NOTE: ALL PIPE FROM HOUSE TO SEPTIC TANK MUST BE CAST IRON OR SCHEDULE 35/40 PVC OR ABS

NOTE: MANHOLE RISERS REQUIRED ON ALL SEPTIC TANKS AND PUMP CHAMBERS

NOTE: DISTRIBUTION BOXES MUST HAVE BAFFLES


NOTE: IF PUMPED SEPTIC SYSTEM REQUIRED, (1) SEPTIC PUMP DETAIL TO BE PROVIDED BY INSTALLER PRIOR TO ISSUANCE OF SEPTIC PERMIT (2) PUMP PERFORMANCE TEST IS NECESSARY PRIOR TO HEALTH DEPARTMENT APPROVAL OF SEPTIC PERMIT

NEITHER THE HOWARD COUNTY COUNCIL NOR THE HEALTH DEPARTMENT IS RESPONSIBLE FOR THE SUCCESSFUL OPERATION OF ANY SYSTEM
PERMITTEE RESPONSIBLE FOR OBTAINING FINAL APPROVAL ON THIS PERMIT
CALL 410-313-2640 FOR INSPECTION OF SEPTIC SYSTEM

P514965

HO-94-2012

NOT TO SCALE

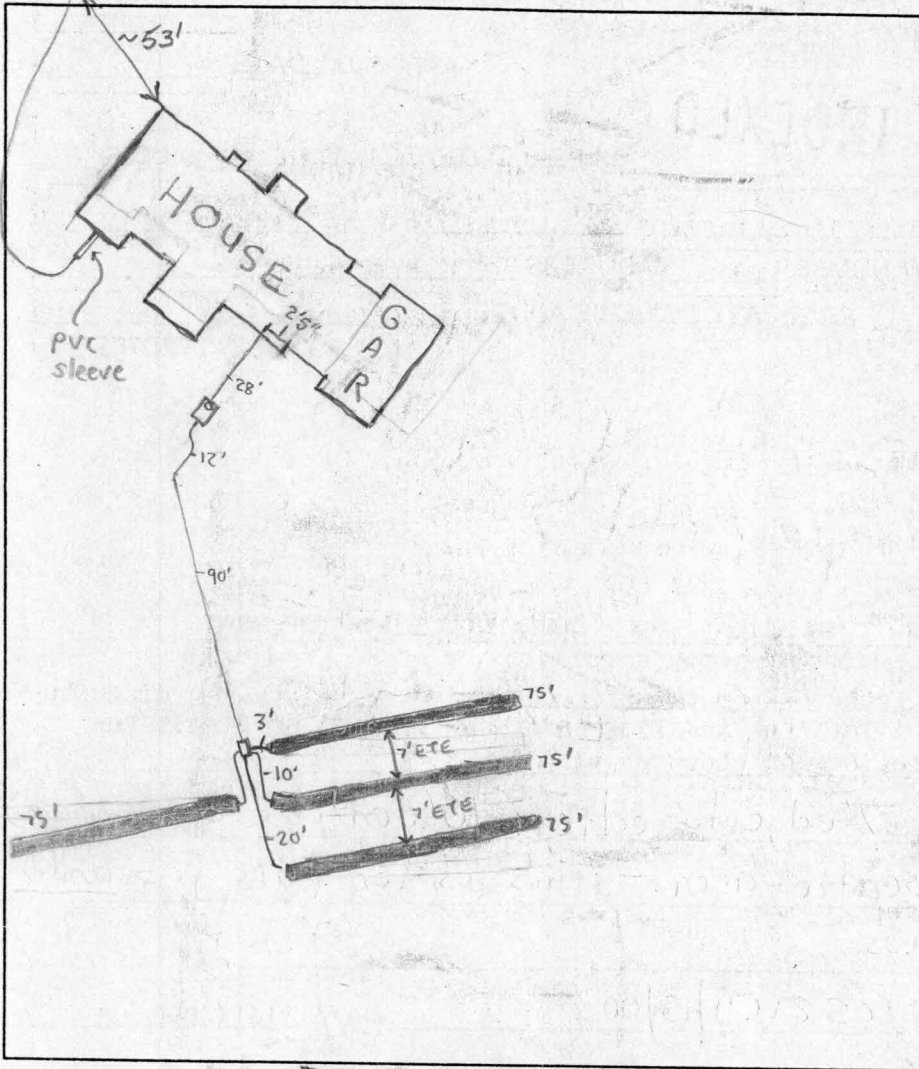

TRENCH DATA

TRENCH WIDTH 3'
 TRENCH INLET DEPTH 3'
 TRENCH BOTTOM DEPTH 5'
 DEPTH OF STONE 2'
 NUMBER OF TRENCHES 4
 TOTAL TRENCH LENGTH 300'
 ABSORBENT AREA 900 ft²
 DISTRIBUTION BOX LEVEL
 BAFFLE IN DISTRIBUTION BOX

SEPTIC TANK DATA

SEPTIC TANK 1500TS GALLONS
 MANHOLE RISER NA
 6 INCH INSPECTION PORT on front

PUMP CHAMBER DATA


PUMP CHAMBER GALLONS NA
 MANHOLE RISER NA
 ALARM NA
 PUMP PERFORMANCE TEST NA

Danmark Drive

PRE-CONSTRUCTION INSPECTION: 3/30/01 Contour similar to BP plan. OK to put in system as per plan and 7' trench spacing. Contractor to gravel pipe

INSPECTION COMMENTS: under driveway and leave beginning and ends of trenches open (BB) 4/2/01- OK TO COVER ALL WORK, WPI OK - (SRK)

INSPECTOR Steven R. Krieg DATE SYSTEM APPROVED 4/2/01

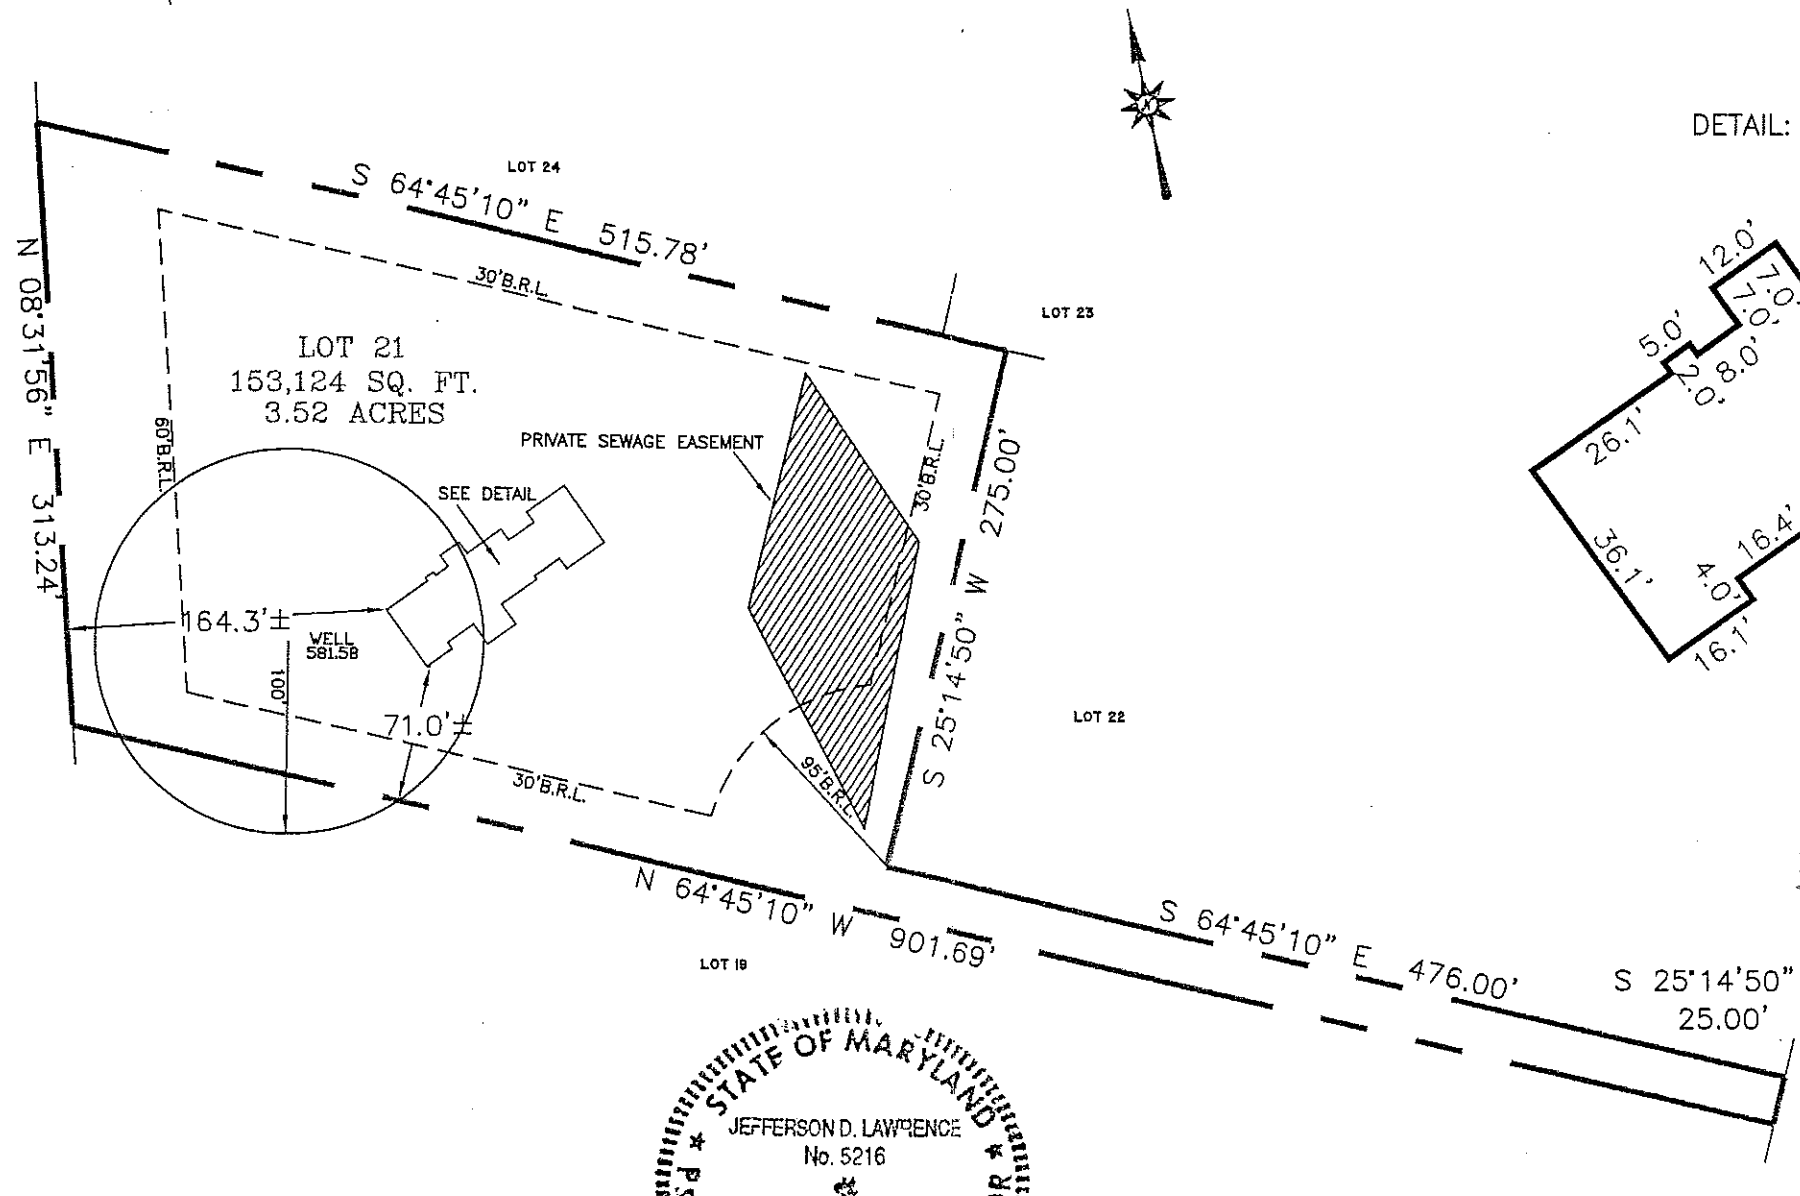

SURVEYOR'S CERTIFICATION

I hereby certify to the best of my knowledge and belief that the property delineated hereon is in accordance with the Plat of Subdivision and/or deed of record, that the improvements were located by accepted field practices and include permanent visible structures and encroachments, if any. This drawing is not to be relied upon for the establishment or location of fences, garages, building or other existing or future improvements. This drawing does not provide for the accurate identification of property boundary lines, but such identification may not be required for the transfer of title or securing financing or refinancing. Questions pertaining to relationships of the property corners or lines to real objects must be addressed by a Boundary Survey. This drawing is of benefit to a consumer only insofar as it is required by lender or title insurance company or its agent in connection with contemplated transfer, financing or refinancing, and valid only within six months from field date, and as to them I warrant the accuracy of the drawing. No title report furnished.

Jefferson D. Lawrence 1-12-01
MD Reg. Professional Surveyor #5216 Jefferson D. Lawrence Date

O'CONNELL & LAWRENCE, INC.
SURVEYORS, ENGINEERS & LAND PLANNERS
17904 Georgia Avenue, Suite 302, Olney, Maryland 20832
Tel: (301) 924-4570 * Fax: (301) 924-5872

Offset dimensions shown thus NN± are generally within 1 (one) foot of the stated distance if 20 feet or less. Longer distances may exceed 1 foot margin proportionally. All offsets depend on site conditions and other factors including but not limited to; elevation changes, availability of property markers, availability and age of land record data, irregularly shaped and or large lots.

CHOI PROPERTY
LOT 21
PLAT# 10632
HOWARD COUNTY, MARYLAND

Job No. 22-421
Scale 1"=100'
Field Dates
Wall Check 01/11/01
Final Loc.
Recert