

Fill out in triplicate.
Make \$15.00 check payable:
Howard County Health Dept. - Sanitation

APPLICATION

A 18539

P _____

SEWAGE DISPOSAL TESTING

STATE OF MARYLAND - DEPARTMENT OF HEALTH AND MENTAL HYGIENE

HOWARD COUNTY HEALTH DEPARTMENT
ENVIRONMENTAL HEALTH SERVICES

P. O. BOX 476, ELLICOTT CITY, MARYLAND 21043
TELEPHONE: 465-5000, EXT. 356

DISTRICT 3rd

DATE 5-29-1973

7/6/73
9:30

TO: THE COUNTY HEALTH OFFICER
ELLICOTT CITY, MARYLAND

I, HEREBY, APPLY FOR THE NECESSARY TEST IN ORDER TO CONSTRUCT (OR RECONSTRUCT) A SEWAGE DISPOSAL SYSTEM.

PROPERTY OWNER JOHN A. EVANS & JOSEPHINE B. EVANS (WIFE)

ADDRESS 970 DAY ROAD - DYKESVILLE, MD. PHONE 442-2087

PROPERTY LOCATION:

SUBDIVISION _____ LOT NO. _____

ROAD AND DESCRIPTION Day Rd. - directly behind 970 Day Rd. off Rt. 32

Short Dist from Route 32 on Right

SIZE OF LOT 10.5 ACRES TYPE BLDG. Exploratory

NUMBER OF BEDROOMS _____

IF NOT SINGLE RESIDENCE DESCRIBE _____

THE SYSTEM INSTALLED UNDER THIS APPLICATION IS ACCEPTABLE ONLY UNTIL PUBLIC FACILITIES BECOME AVAILABLE.

SIGNATURE OF APPLICANT John A. Evans - Josephine B. Evans

APPROVED BY _____ FOR _____ DATE _____

(KIND OF SYSTEM)

REJECTED BY _____ FOR _____ DATE _____

(KIND OF SYSTEM)

HOLD PENDING FURTHER TESTS _____ DATE _____

REASONS FOR REJECTION OR HOLDING 7/6/73 - Per OK but need final plat

with minor ownership statement & Dr. Lopez Signature

THIS IS NOT A PERMIT

APPLICATION

INDICATE NORTH. - NAME ADJOINING ROADWAY AS BASE LINE.

see
plat

60

98

43
141

22

DATE	TEST NO.	DEPTH	PRE-WET		TEST - 1" DROP		TIME
			START	STOP	START	STOP	
7/6/73	1	12 1/2	1138	1141	1141	1147	6
7/6/73	2	6 1/2	1136	1139	1139	1149	8
7/6/73	3	5 1/2	1139	1144	1144	1153	9
7/6/73	4	12	1141	1149	1149	1153	9
	5	11 1/2	TOP 5 FT Clay BOT 6 1/2 FT Sand				
	6	11	TOP 3 FT Clay BOT 6 FT Sand				


Low

High

REMARKS

TYPE OF SOIL

Clay & Sand

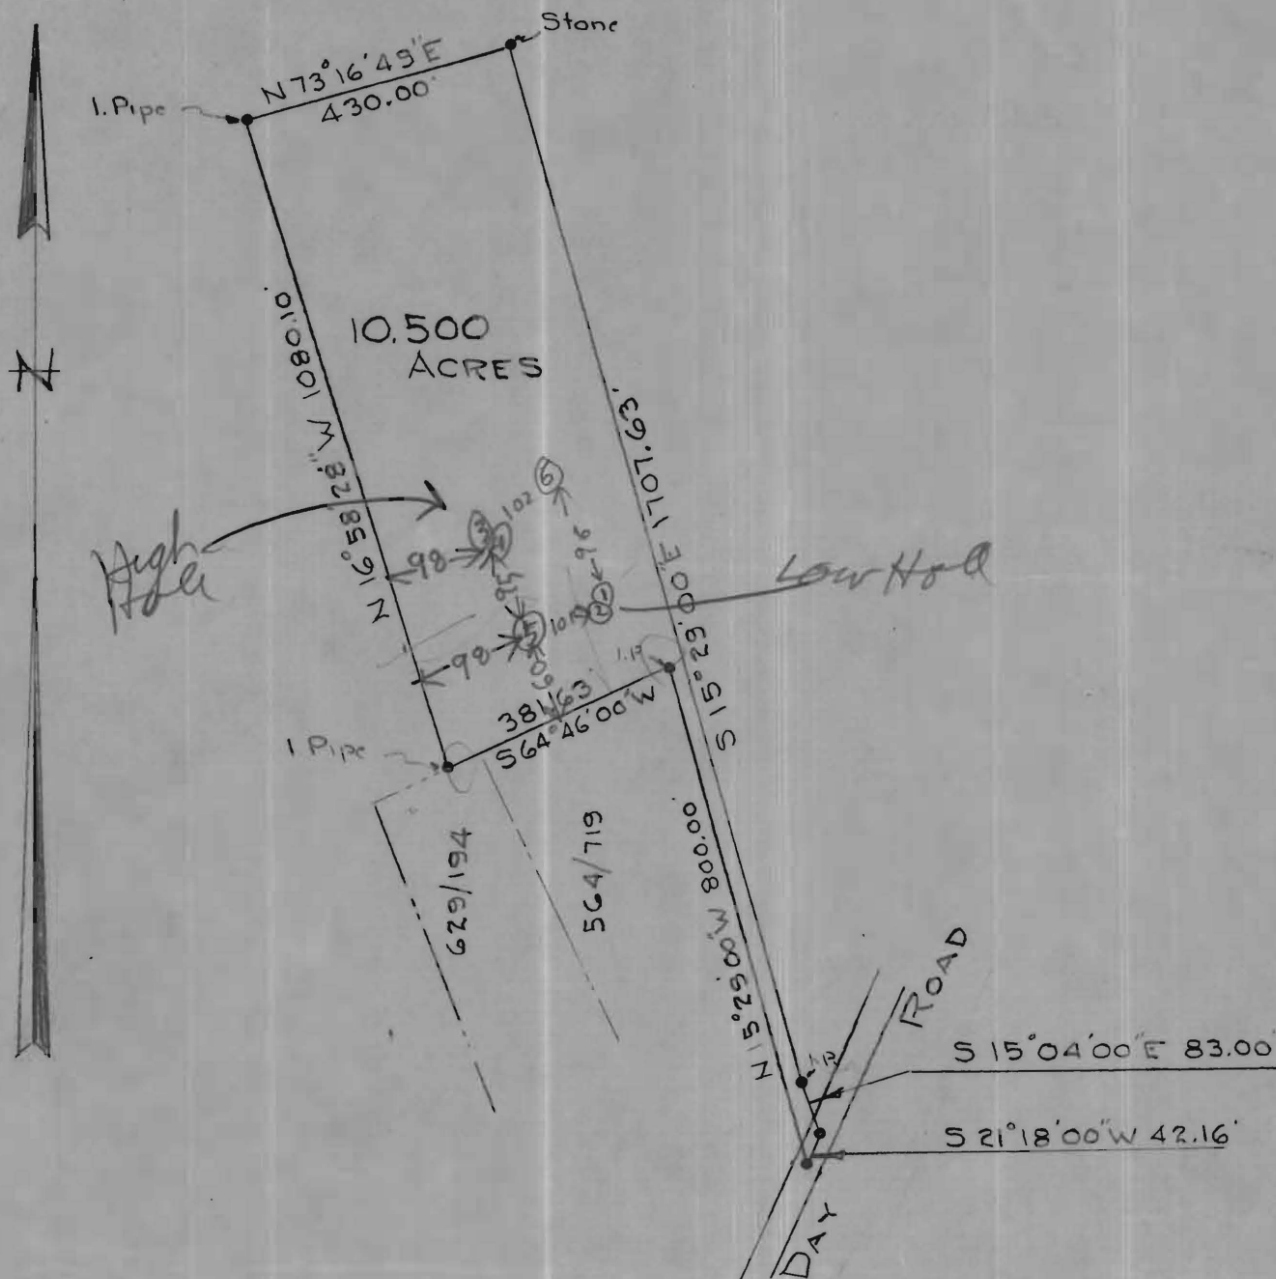

PLAT OF SURVEY
FOR
MRS. GEORGE P. GARRATT, JR
THIRD ELECTION DIST, HOWARD COUNTY,
SYKESVILLE, MARYLAND.
SCALE: 1 IN. = 200 FT. APRIL 19, 1973



Claude M. Skinner, Jr.
A-3598-B