

APPLICATION

A 25054

P _____

SEWAGE DISPOSAL TESTING

STATE OF MARYLAND - DEPARTMENT OF HEALTH AND MENTAL HYGIENE

DISTRICT 3rd

HOWARD COUNTY HEALTH DEPARTMENT
ENVIRONMENTAL HEALTH SERVICES

DATE 12/27/76

P. O. BOX 476, ELLICOTT CITY, MARYLAND 21043
TELEPHONE: 465-5000, EXT. 356

Septem First

TO: THE COUNTY HEALTH OFFICER
ELLICOTT CITY, MARYLAND

I, HEREBY, APPLY FOR THE NECESSARY TEST IN ORDER TO CONSTRUCT (OR RECONSTRUCT) A SEWAGE DISPOSAL SYSTEM.

PROPERTY OWNER Charles Wohlwend (JAMES DICKEY 489 7148)

ADDRESS Ellicott City, Md, PHONE 465-8755

PROPERTY LOCATION:

SUBDIVISION Rockway Farms LOT NO. 16

ROAD AND DESCRIPTION _____

SIZE OF LOT 2.7460 Ac. TYPE BLDG. 3
NUMBER OF BEDROOMS _____

IF NOT SINGLE RESIDENCE DESCRIBE _____

THE SYSTEM INSTALLED UNDER THIS APPLICATION IS ACCEPTABLE ONLY UNTIL PUBLIC FACILITIES BECOME AVAILABLE.

SIGNATURE OF APPLICANT Alb. F. S. C. J.


APPROVED BY _____ FOR _____ DATE _____
(KIND OF SYSTEM)

REJECTED BY _____ FOR _____ DATE _____
(KIND OF SYSTEM)

HOLD PENDING FURTHER TESTS _____ DATE _____

REASONS FOR REJECTION OR HOLDING 7/17/78 - DIG MORE WHEN CERTIFIED PLAT SUBMITTED IT WAS NOTED THAT THERE WAS NO HOUSE SITE HIGHER THAN THE HIGHEST HOLE OF THE TEST PATTERN QH

THIS IS NOT A PERMIT

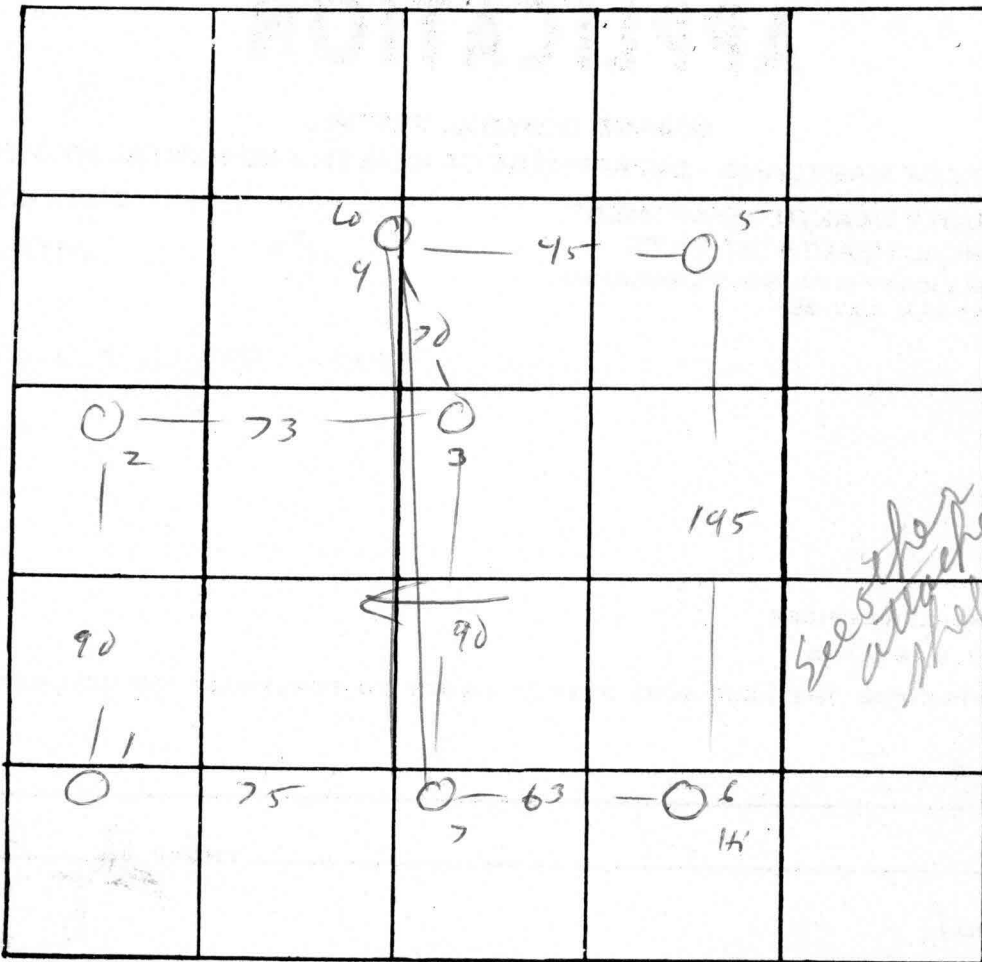

INDICATE NORTH. - NAME ADJOINING ROADWAY AS BASE LINE.

DATE	TEST NO.	DEPTH	PRE-WET		TEST - 1" DROP		TIME
			START	STOP	START	STOP	
4/4/77	1	9	water	@	6 1/2'		
	2	11	water	@	7 1/2'		
	3	4				342	5
	3A	13	332	337	337	345	8
	4	4				346	10
	4A	9	340	346	346	358	230
	4B	11				358	
	5	12	vis	dry			
	6	11	rock beginning @ 4'				
	7	12	vis	sandy			
8/9/77	8B	13	1120	1125	1125	1136	6
8/9/77	8S	5	1120	1122	1122	1127	5
	9D	12 1/2	1137	1140	1140	1144	4
	9S	3	1137	1138	1138	1143	5
	10S	3 1/2	130	131	131	133	2
	10D	12 1/2	130	133	133	133	2
	11S	3	209	210	210	213	3
	11D	12 1/2	209	212	212	220	8

REMARKS

TYPE OF SOIL

TESTED BY

ALSO PRESENT:

Carol Clark

1, 2, 5
0
1 clay red
4-6 red-brown sandy loam
12 loam

14
0 red clay
1 red-brown sandy loam
11

16
1 sandy clay Brn
1 Brn
1 sandy

17
0 clay (sandy)
1 rock

18
3
3.5