

APPLICATION

FOR PERCOLATION TESTING AND SITE EVALUATION

A25423
P25425

Also there are
a few additional
pages in Public File
search.

TEST DATE(S) _____ TEST TIME _____

AP # ~~165~~ 25423

AGENCY REVIEW: _____

DATE 4/11/08

DO NOT WRITE ABOVE THIS LINE

I HEREBY APPLY FOR THE NECESSARY TESTING/EVALUATION PRIOR TO ISSUANCE OF SEWAGE DISPOSAL SYSTEM PERMIT(S) TO:

CHECK AS NEEDED:

- CONSTRUCT NEW SEPTIC SYSTEM(S)
- REPAIR/ADD TO AN EXISTING SEPTIC SYSTEM
- REPLACE AN EXISTING SEPTIC SYSTEM

CHECK AS NEEDED:

- NEW STRUCTURE(S)
- ADDITION TO AN EXISTING STRUCTURE
- REPLACE AN EXISTING STRUCTURE

CHECK ONE:

- CREATE NEW LOT(S)
- BUILD ON AN EXISTING LOT IN A SUBDIVISION
- BUILD ON AN EXISTING PARCEL OF RECORD

IS THE PROPERTY WITHIN 2500' OF ANY RESERVOIR?

- YES
- NO

THE TYPE OF STRUCTURE IS:

- RESIDENTIAL WITH 4 PROPOSED BEDROOMS IN THE COMPLETED STRUCTURE (NOTE **UNKNOWN** IF APPROPRIATE)
- COMMERCIAL (PROVIDE DETAIL OF NUMBERS AND TYPES OF EMPLOYEES/CUSTOMERS ON ACCOMPANYING PLAN)
- INSTITUTIONAL/GOVERNMENT (PROVIDE DETAIL OF NUMBERS AND TYPES OF EMPLOYEES/USERS ON ACCOMPANYING PLAN)

PROPERTY OWNER(S) Christie E Orlando

DAYTIME PHONE 301-854-6118 CELL 240 462 7139 FAX _____

MAILING ADDRESS 13036 Deanmar Dr Highland MD 20777
STREET CITY/TOWN STATE ZIP

APPLICANT J.M. Contracting LLC / Ronnie Heaps

DAYTIME PHONE 443-277-7526 CELL SAME FAX 410 552 5815

MAILING ADDRESS 425 G Bucht Rd Sykesville MD 21784
STREET CITY/TOWN STATE ZIP

APPLICANT'S ROLE: DEVELOPER BUILDER BUYER RELATIVE/FRIEND REALTOR CONSULTANT

PROPERTY LOCATION
SUBDIVISION/PROPERTY NAME White Oak Estates LOT NO. 1


PROPERTY ADDRESS 13036 Deanmar Dr Highland 20777
STREET TOWN/POST OFFICE

TAX MAP PAGE(S) _____ GRID _____ PARCEL(S) _____ PROPOSED LOT SIZE _____

AS APPLICANT, I UNDERSTAND THE FOLLOWING: THE SYSTEM INSTALLED SUBSEQUENT TO THIS APPLICATION IS ACCEPTABLE ONLY UNTIL PUBLIC SEWERAGE IS AVAILABLE. THIS APPLICATION IS COMPLETE WHEN ALL APPLICABLE FEES AND A SUITABLE SITE PLAN HAVE BEEN RECEIVED. I ACCEPT THE RESPONSIBILITY FOR COMPLIANCE WITH ALL M.O.S.H.A. AND "MISS UTILITY" REQUIREMENTS. APPROVAL IS BASED UPON SATISFACTORY REVIEW OF A PERC CERTIFICATION PLAN.

TEST RESULTS WILL BE MAILED TO APPLICANT. _____
SIGNATURE OF APPLICANT

HOWARD COUNTY HEALTH DEPARTMENT, BUREAU OF ENVIRONMENTAL HEALTH, WELL AND SEPTIC PROGRAM
7178 COLUMBIA GATEWAY DRIVE COLUMBIA, MARYLAND 21046 (410) 313-1771 FAX (410) 313-2648
TDD (410) 313-2323 TOLL FREE 1-877-4MD-DHMH

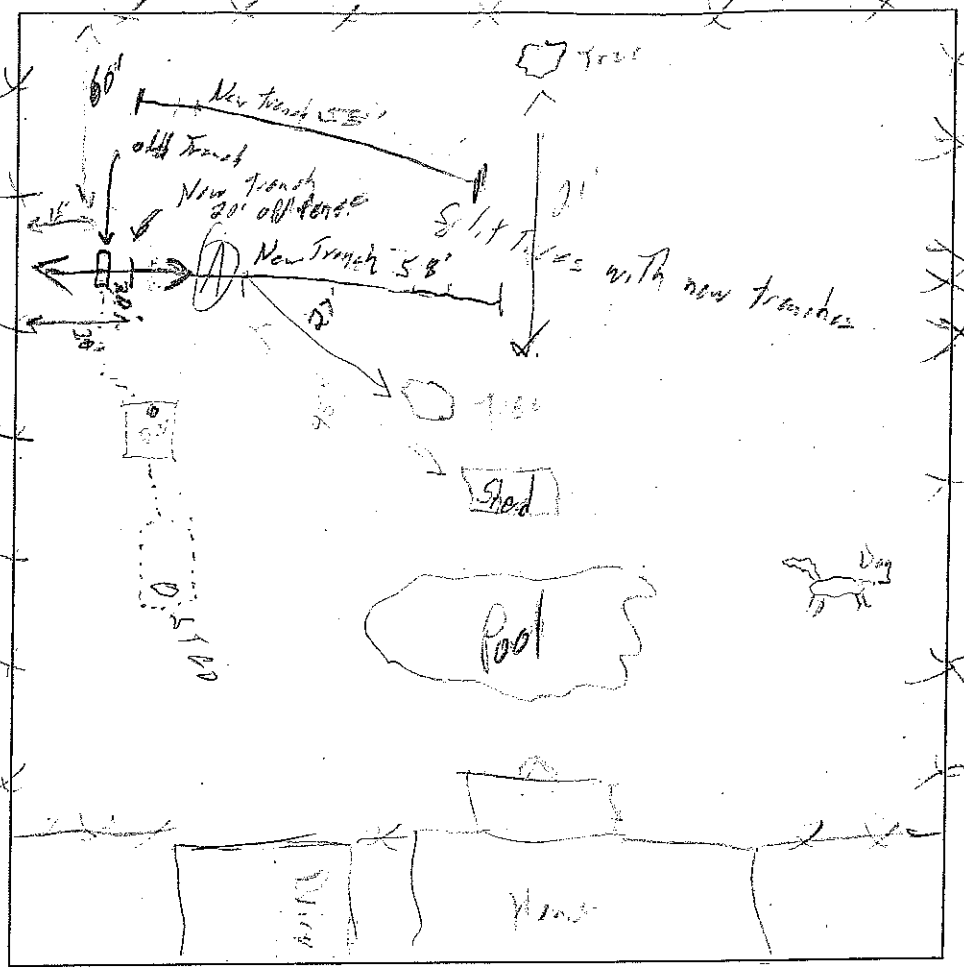

(A)
 Red D. ...
 Heavy Clay
 4-3
 Tan Orange
 clay loam
 17-5 sample 1-17
 17
 Tan Orange
 Loam
 20-10 sample 1-17
 17

DATE	TEST #	DEPTH	START	BREAK 1" DROP	STOP 2" DROP	TIME OF 2ND INCH	P/F/H
11/14/09	(A)	5'	10:28	10:33	10:53	15	P

REMARKS _____
 SANITARIAN SFO BACKHOE Roomba OTHERS Hand-dug
 TEST HOLES USED IN SDA _____ AVG. PERC TIME 15 SQ. FT/BR _____
 TRENCH WIDTH 2 INLET DEPTH 5 MAX. BOT DEPTH 10 EFFECTIVE S/W 5'

116' = (A) 58

SEPTIC SYSTEM REPAIR / UPGRADE / EVALUATION REQUEST

Please fill out this form completely and check off the reason for the request:

Date requested: _____

Reason for Request

Failing System (includes surface discharge or inadequate treatment zone)

Has the contractor verified through excavation/pumping evaluation, that there are no pipe blockages? _____

In support of a building permit. Type of building addition: NO

*System relocation for proposed addition for setback compliance _____

*Verification of adequate system capacity per COMAR 26.04.02.02D (4) _____

To replace collapsed septic tank or upgrade tank capacity _____

To replace collapsed drywell _____

Septic Contractor: JM Contracting LLC / Ronnie Heaps

Contractor's Address: 425 O'Brien Rd

Contractor's Phone #: 443 277 7526

Property Address: 13036 DEANMAR DR.

Property (Subdivision) & Lot #: Highland MD 20777

Owner's Name: Christl E. Orlando

Is public sewer available/nearby: NO

Names of Any Previous Owners: NONE

Year House Built: 1970

of Existing Bedrooms: 4

of Bedrooms after completion of addition: _____

Has this request been discussed previously with a Sanitarian, who? _____

If public sewer is close, further research will be performed to verify availability and possible hook up to public sewer.

A Sanitarian will be in contact within three business days depending upon the urgency of the situation to coordinate the scheduling of the repair /upgrade/evaluation. No inspection will be performed without fee collection at the office.

Environmental Sanitarian tentatively assigned _____