

Ferron Interiors
5900 Deer Ridge Lane
Elkridge, Maryland 21227
(410) 796-8885

November 12, 1993

Mr. Craig Williams
The Bureau of Environmental Health
3525 Ellicott Mills Drive, Suite H
Ellicott City, Maryland 21043

Dear Mr. Williams,

Enclosed please find a parcel lay-out of the planned well location in accordance with the septic tank.

It is 1750 feet from Deer Ridge Lane to this building site. The availability of City water from Deer Ridge to this building site is not permitted by the owners of the right away.

Please take a look at the lay-out and let me know if you have any questions or concerns. You can reach me at the number listed above.

Thank you for your time and I look forward to hearing from you soon.

Regards,

Ernest M. Ferron


Ernest M. Ferron

EMF/tfa

OK -
PLEASE ~~BUY~~
CONTACT WELL DRILLER
~~WELL~~ AND SUBMIT
PERMIT APPLICATION,
12/3/93
C. Williams

ERNEST M. FERRON SR.
5900 DEER RIDGE LANE
ELKRIDGE, MD. 21075

LOT OR PARCEL
West

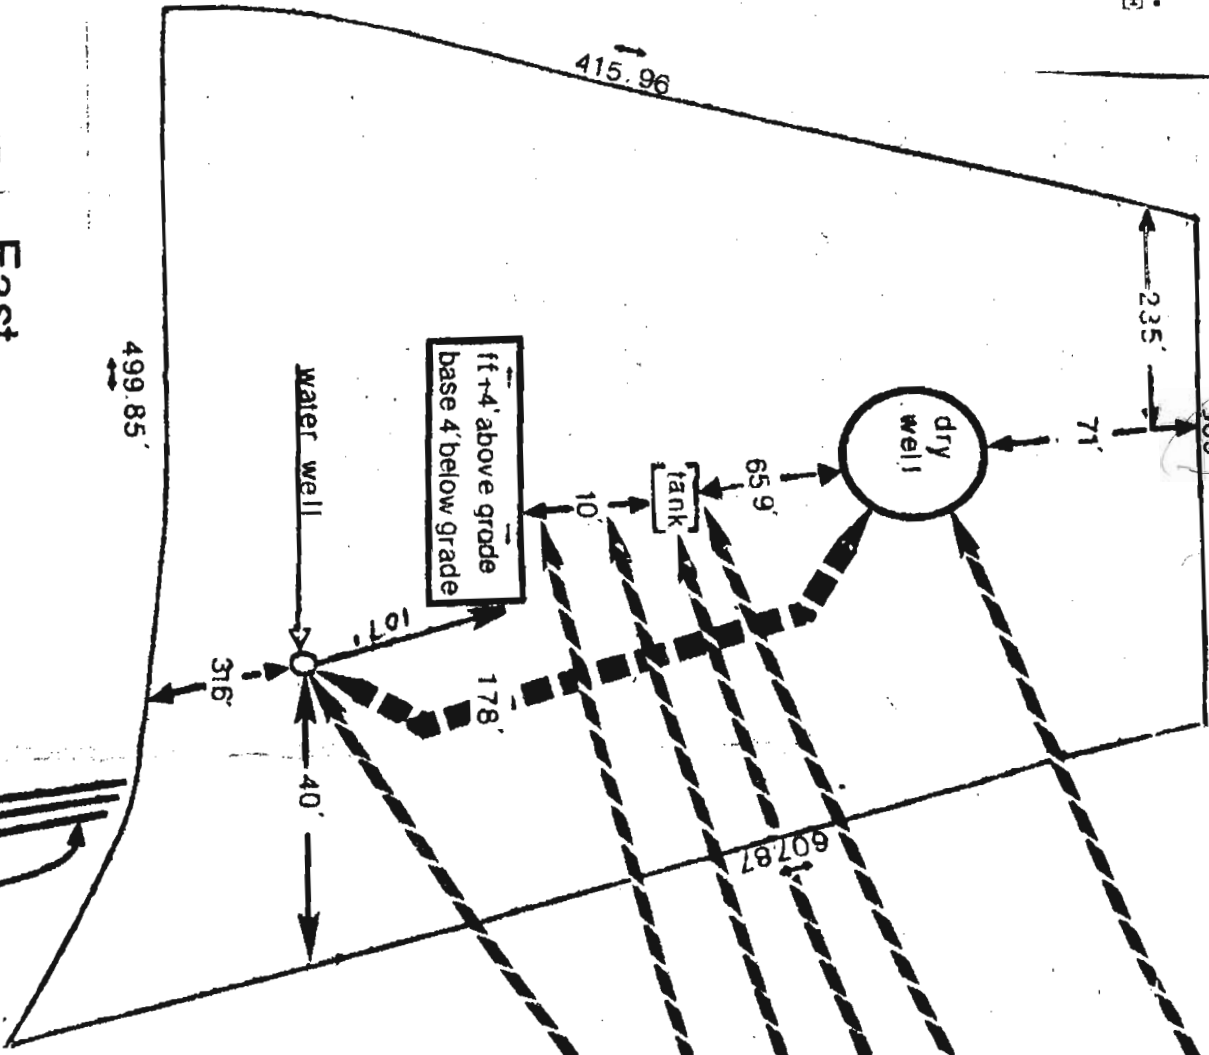

high elev. exist.
-3' to 4'
= 36" to 48" below exist elev.

INV OUT = -2 3/4' = -3.3'
DIST ELEV = -1 1/2' = -6"
INV IN = 2 1/2' = -30"
INV = 2 1/4' = 27"
1' Below Exist Elev

SOUTH

NORTH

Note:

All plumbing pipe will be in original soil 1' to 1 1/2' below grade and/or 1' to 1 1/2' fill over pipe if pipe is just below original surface

I CERTIFY THE ABOVE MEASUREMENTS AND ELEVATIONS ARE ACTUAL AND CORRECT FOR THIS PROPERTY

East

SIGNED _____
DATE _____



HOWARD CO
DEPT OF RECREATION
PARKS
431 483
96 80 A.
P. 68

MEADOWRIDGE MEMORIAL PARK INC.
151/322
1364/99
86/78A.
P. 78

HO. CO., MD.
577/414
53/31A
P. 561

501

498

495



HOWARD COUNTY HEALTH DEPARTMENT

Mary Sue Baker, MBA, Acting County Health Officer

July 15, 1999

TO: Cindy Hamilton
Subdivision Review Committee

FROM: Mark Rifkin MR
Water and Sewerage Program

RE: File Number: WP-99-139
Title: Ferron Property

The following comments apply to the above referenced document:

The Health Department has no objection to the requested waiver based on standards contained in COMAR 26.04.02.02, which allow for approval of parcels existing prior to 1985.

However, the applicant is advised of the following caution: Due to the age and uncertainty of the original evaluation, a request for percolation test re-evaluation is to be anticipated prior to recommendation for building permit approval.

MR

LOT OR PARCEL


West

Road Address--4500 Duckett La
Elkridge Md. 21227
Name Ernest M. Ferron

SOUTH

NORTH

0' high elev. exist.
- 3' to 4' =
- 36" to 48" below exist elev.

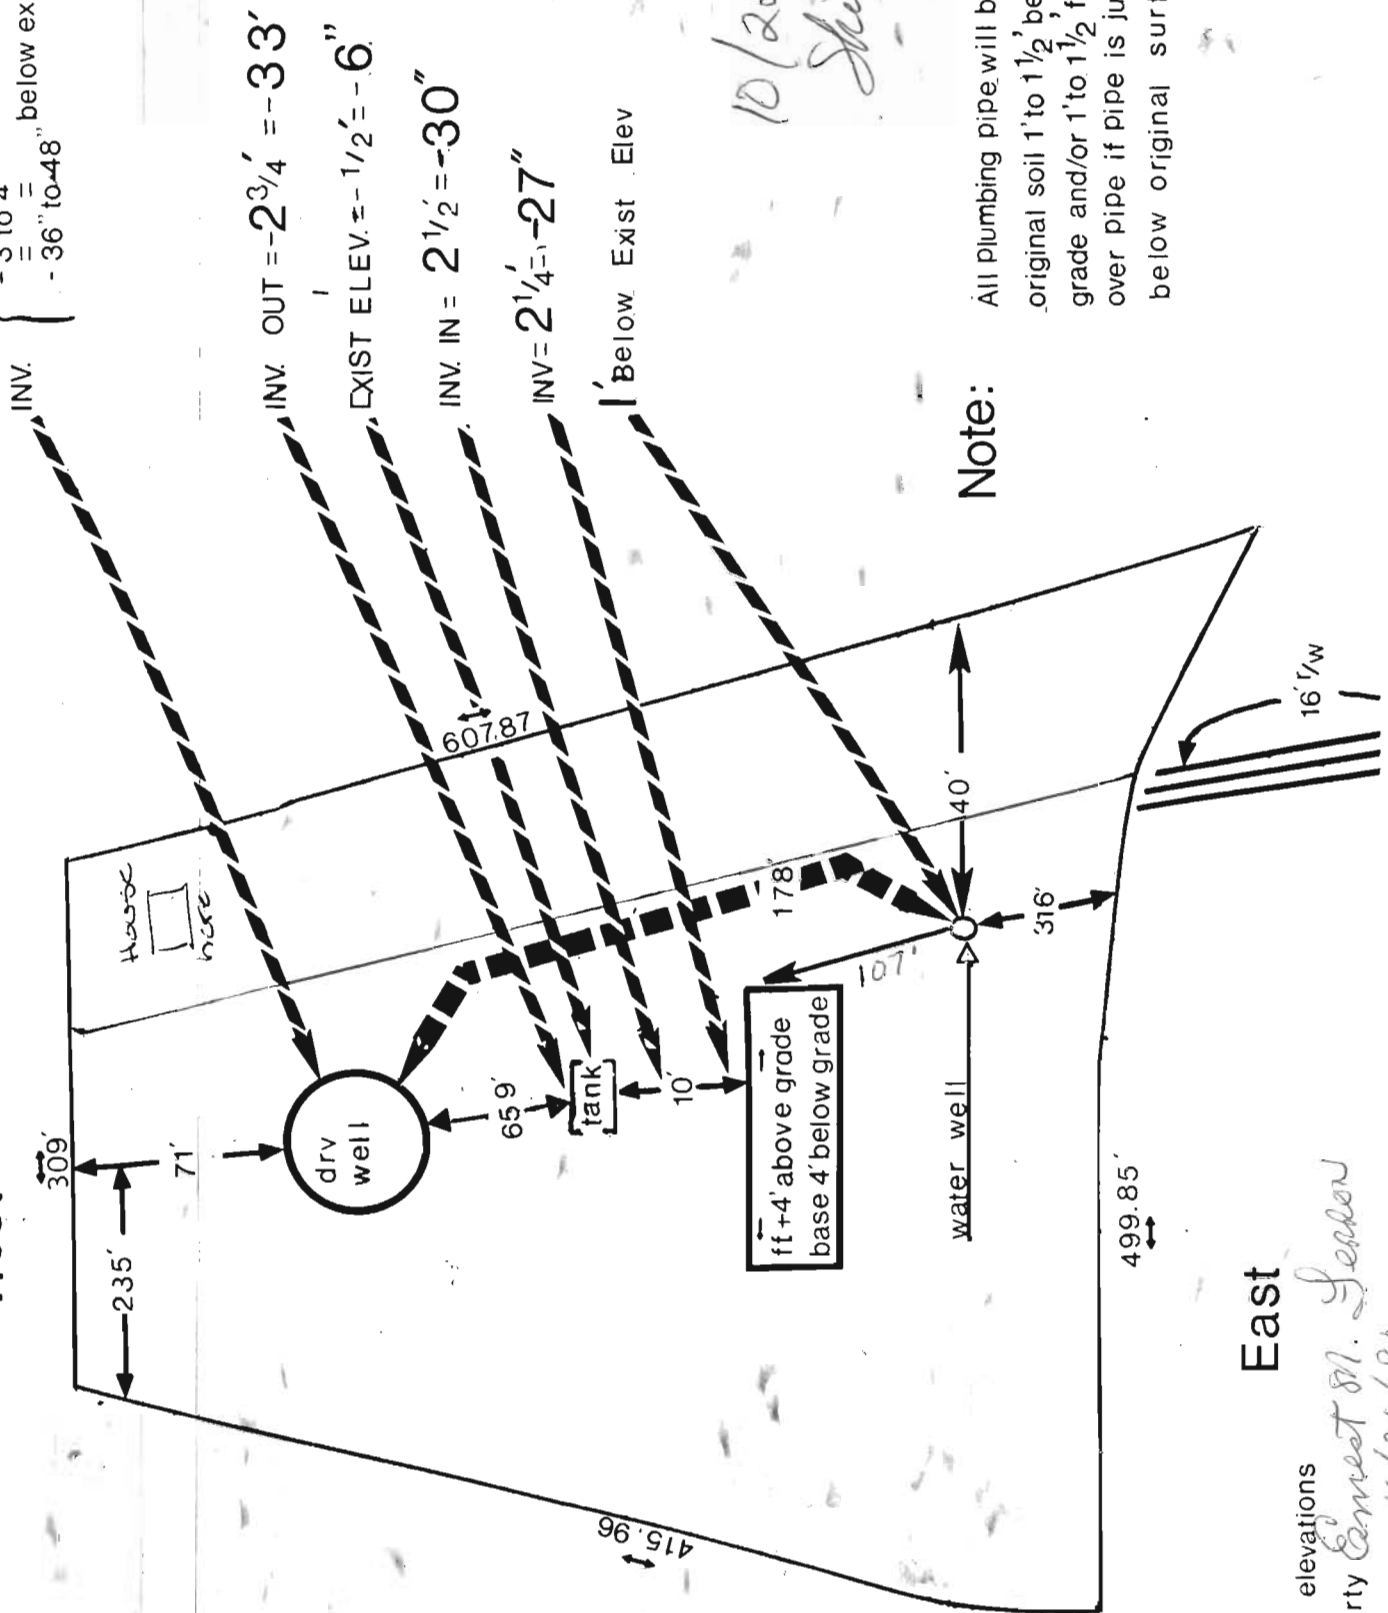

10/22/81
Sketch O.K.
G.S.

Note: All Plumbing pipe will be in original soil 1' to 1 1/2' below grade and/or 1' to 1 1/2' fill over pipe if pipe is just below original surface

East

I certify the above measurements and elevations are actual and correct for this property Ernest M. Ferron 10/21/81

121	Ernest	5900 Beer Ridge	3.99 acres	No house
169	Donald	5864	2.26 acres	No house
171	Rebecca	5882	1.09	1910 building

1910