

# APPLICATION

*Revised  
3/7/87  
9:30*

SEWAGE DISPOSAL TESTING

A 38976

STATE OF MARYLAND - DEPARTMENT OF HEALTH AND MENTAL HYGIENE

P \_\_\_\_\_

HOWARD COUNTY HEALTH DEPARTMENT  
ENVIRONMENTAL HEALTH SERVICES

DISTRICT 4TH

P. O. BOX 476 ELLICOTT CITY, MARYLAND 21043  
TELEPHONE: 992-2330

DATE 3-26-87

HICKORY ESTATES

*OK to process*

*3/20/87*

TO: THE COUNTY HEALTH OFFICER  
ELLICOTT CITY, MARYLAND

I, HEREBY, APPLY FOR THE NECESSARY TEST IN ORDER TO CONSTRUCT (OR RECONSTRUCT) A SEWAGE DISPOSAL SYSTEM.

PROPERTY OWNER Joseph Connolly *Connolly* CONSTRUCTION MGT, INC.

ADDRESS 7535 Montevideo Road PHONE 799.5988

PROPERTY LOCATION:

SUBDIVISION 3202 ~~3210~~ Florence Road LOT NO. 1

ROAD AND DESCRIPTION 1000+ ft. northwest of Ed Warfiend Road

BLDG. PERMIT SIGNED  
AND RETURNED 8/7/94  
*Serial # 55897*  
SFD - 4B  
(NUMBER OF BEDROOMS)

SIZE OF LOT 3+ acres TYPE BLDG. \_\_\_\_\_

THE SYSTEM INSTALLED UNDER THIS APPLICATION IS ACCEPTABLE ONLY UNTIL PUBLIC FACILITIES BECOME AVAILABLE. I FULLY UNDERSTAND THE FEE CONNECTED WITH THE FILING OF THIS PERC TEST APPLICATION IS NON-REFUNDABLE UNDER ANY CIRCUMSTANCES. I ALSO AGREE TO COMPLY WITH ALL M.O.S.H.A. REQUIREMENTS IN TESTING THIS LOT.

*Lynee Bask*  
(SIGNATURE OF APPLICANT)

APPROVED BY \_\_\_\_\_ FOR \_\_\_\_\_ DATE \_\_\_\_\_

REJECTED BY \_\_\_\_\_ FOR \_\_\_\_\_ DATE \_\_\_\_\_


HOLD PENDING FURTHER TESTS \_\_\_\_\_ DATE \_\_\_\_\_

REASONS FOR REJECTION OR HOLDING 4-3-87 PUC satisfactory; hold for plan. S.A.W.

BLDG. PERMIT SIGNED  
AND RETURNED 2-4-88

*BP 16617  
SAW*

# THIS IS NOT A PERMIT

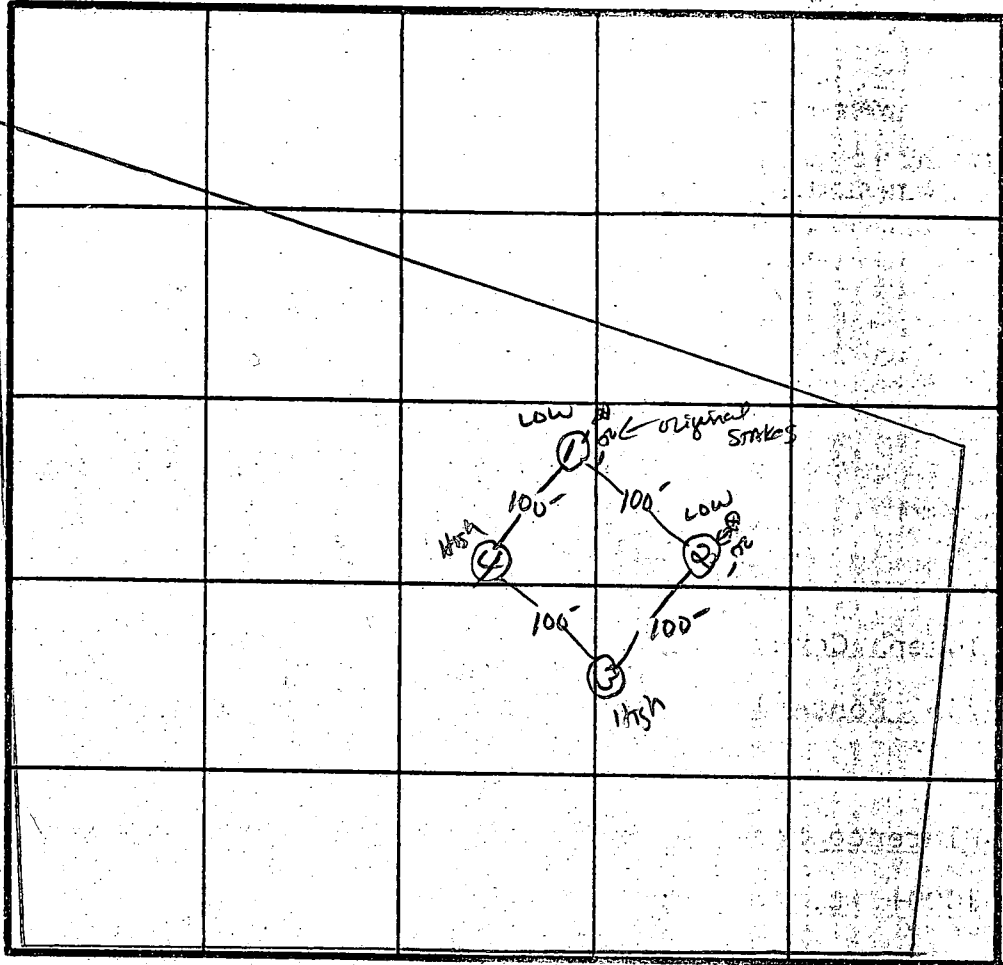

2 Perc 10 min  
200 #/BK  
INLET 3.0  
BOTTOM 5.0

SOIL PROFILE

AP
Yellow Red / Red Brown Silt loam 9-12% clay
4'-5.5'
Yellow Red / Red Bse. Silt loam 20-30% FRAGS.
FB

INDICATE NORTH - NAME ADJOINING ROADWAY AS BASE-LINE.  
Florence Rd.

DATE	TEST NO.	DEPTH	PRE-WET		TEST - 1" DROP		TIME
			START	STOP	START	STOP	
4/3/87	1S	4.5' 13' UNIFORM SOIL	11:51	11:53	11:53	11:58	5 MIN
	2S	6' 13' UNIFORM SOIL	11:54	12:06	12:06	12:28	22 MIN
	3S	3' 6'	11:58	12:00	12:00	12:03	3 MIN
	3V	13' UNIFORM SOIL	12:03:30	12:05:30	12:05:30	12:13	7.5 MIN
	4V	12.5' MASSIVE SANDSTONE			AT 9'-10'	CLAY RD	4.0'

REMARKS Holes slightly Diff Than Plat. Shallow SPST only

TYPE OF SOIL mt clay - mndr

S. Abel