

7/12/01
WPI
AM

04-362578

ISSUE DATE: 7/9/2001

P 515325-C

APPROVAL DATE: 9/12/01

A 58095-AA

PERMIT

7/12/01
Layout
10-11

7/13/01
Final

ON-SITE SEWAGE DISPOSAL SYSTEM HOWARD COUNTY HEALTH DEPARTMENT BUREAU OF ENVIRONMENTAL HEALTH

INDEXED

Fogles Septic Clean, Inc IS PERMITTED TO INSTALL ALTER

ADDRESS: 580 Obrecht Road, Sykesville, MD PHONE NUMBER: 410-795-5670

SUBDIVISION: Wellington West LOT NUMBER: 29

ADDRESS: 15320 Doe Hill Court PROPERTY OWNER: Pulte Home Corp.

SEPTIC TANK CAPACITY (GALLONS): 1250

PUMP CHAMBER CAPACITY (GALLONS): N/A

NUMBER OF BEDROOMS: 4

SQUARE FEET PER BEDROOM: 180

LINEAR FEET OF TRENCH REQUIRED: 240

TRENCHES:	Trench to be 3.0 feet wide. Inlet 2.5 feet below original grade. Bottom maximum depth 4.0 feet below original grade. Effective area begins at 2.5 feet below original grade. 1.5 feet of stone below distribution pipe.
LOCATION:	Begin trenches 150 feet down the right lot line and 40 feet off that same lot line as seen when facing the lot from Doe Hill Court. Run trenches on contour toward the left lot line.
NOTES:	

PLANS APPROVED: Amy Mc Millen 6/15/01 OK AB DATE: 6-1-01

- NOTE: PERMIT VOID AFTER 2 YEARS
- NOTE: CONTRACTOR RESPONSIBLE FOR SCHEDULING A PRE-CONSTRUCTION INSPECTION FOR ALL INSTALLATIONS
- NOTE: WATERTIGHT SEPTIC TANKS REQUIRED
- NOTE: ALL PARTS OF SEPTIC SYSTEM SHALL BE 100 FEET FROM ANY WATER WELL
- NOTE: MANHOLE RISERS REQUIRED ON ALL SEPTIC TANKS AND PUMP CHAMBERS

NEITHER THE HOWARD COUNTY COUNCIL NOR THE HEALTH DEPARTMENT IS RESPONSIBLE FOR THE SUCCESSFUL OPERATION OF ANY SYSTEM PERMITTED RESPONSIBLE FOR OBTAINING FINAL APPROVAL ON THIS PERMIT BUILDING PERMIT SIGNED


CALL 410-313-2640 FOR INSPECTION OF SEPTIC SYSTEM

AND RETURNED

0204 B00148517-DECK

515325-C

NOT TO SCALE

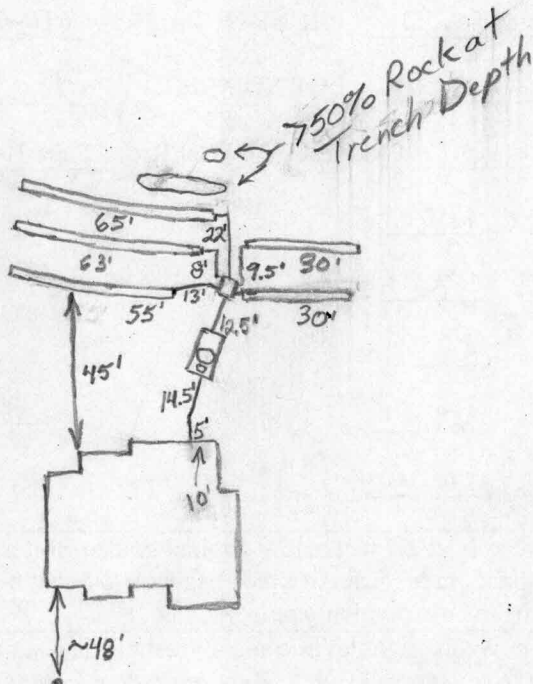

HO-94-1671

TRENCH DATA

TRENCH WIDTH 3'
 TRENCH INLET DEPTH 2.5'
 TRENCH BOTTOM DEPTH 4'
 DEPTH OF STONE 1.5'
 NUMBER OF TRENCHES 5
 TOTAL TRENCH LENGTH 243'
 ABSORBENT AREA 729 sq ft
 DISTRIBUTION BOX LEVEL Yes
 BAFFLE IN DISTRIBUTION BOX Yes

SEPTIC TANK DATA

SEPTIC TANK 1250TS GALLONS
 MANHOLE RISER Yes
 6 INCH INSPECTION PORT Yes

PUMP CHAMBER DATA N/A

~~PUMP CHAMBER GALLONS _____
 MANHOLE RISER _____
 ALARM _____
 PUMP PERFORMANCE TEST _____~~

Doe Hill Court

PRE-CONSTRUCTION INSPECTION: 7/12/01 Contour different than on plans To install a

short 45'-50' trench which may be deeper than 4' on highest part of easement. To

INSPECTION COMMENTS: install 3 more trenches ~65' and work with contours and

spacing as best possible. (BB) 7/12/01 Encountered excessive rock while

digging last trench. To install two short trenches to the right of

distribution box out of easement area to compensate. No house

connection. (BB) 7/13/01 The 2-30' trenches are done. Still need house

connection. (BB) 9/12/01 Plumber putting in house connection. (BB)

INSPECTOR B. Baker connection

DATE SYSTEM APPROVED 9/12/01