

01/1/01
11:00 AM layout
10/2/01 10AM FINAL

ISSUE DATE: 8/17/2001

APPROVAL DATE: 10/2/01

PERMIT INDEXED

P 515988-D

A 58947-B

ON-SITE SEWAGE DISPOSAL SYSTEM HOWARD COUNTY HEALTH DEPARTMENT BUREAU OF ENVIRONMENTAL HEALTH

04-364872

K & K Excavating IS PERMITTED TO INSTALL ALTER

ADDRESS: 14960 Frederick Road, Woodbine PHONE NUMBER: 410-442-1336

SUBDIVISION: Windridge Farm LOT NUMBER: 2

ADDRESS: 14530 Dorsey Mill Road PROPERTY OWNER: Selfridge Builders

SEPTIC TANK CAPACITY (GALLONS): 1500 (TOPSEAM)

PUMP CHAMBER CAPACITY (GALLONS): N/A

NUMBER OF BEDROOMS: 5

SQUARE FEET PER BEDROOM: 180

LINEAR FEET OF TRENCH REQUIRED: 300

| | |
|-----------|---|
| TRENCHES: | Trench to be 3.0 feet wide. Inlet 2.5 feet below original grade. Bottom maximum depth 4.5 feet below original grade. Effective area begins at 2.5 feet below original grade. 2.0 feet of stone below distribution pipe. |
| LOCATION: | <i>place box</i> Begin trenches 130 feet down the left lot line and 67 feet off that same lot line as seen when facing the lot from Dorsey Mill Road. Run trenches on contour both to <i>directions. right side of lot EXACTLY AS SHOWN ON PLAN.</i> |
| NOTES: | <i>Install dist. box in location described 2.5' below grade to allow for efficient future use. Start trenches 10' further downhill.</i> |

PLANS APPROVED: Amy Mc Millen *ON SRK 7/13/01* DATE: 7-9-01

- NOTE: PERMIT VOID AFTER 2 YEARS
- NOTE: CONTRACTOR RESPONSIBLE FOR SCHEDULING A PRE-CONSTRUCTION INSPECTION FOR ALL INSTALLATIONS
- NOTE: WATERTIGHT SEPTIC TANKS REQUIRED
- NOTE: ALL PARTS OF SEPTIC SYSTEM SHALL BE 100 FEET FROM ANY WATER WELL
- NOTE: MANHOLE RISERS REQUIRED ON ALL SEPTIC TANKS AND PUMP CHAMBERS

NEITHER THE HOWARD COUNTY COUNCIL NOR THE HEALTH DEPARTMENT IS RESPONSIBLE FOR THE SUCCESSFUL OPERATION OF ANY SYSTEM PERMITTEE RESPONSIBLE FOR OBTAINING FINAL APPROVAL ON THIS PERMIT CALL 410-313-2640 FOR INSPECTION OF SEPTIC SYSTEM


**BUILDING PERMIT SIGNED
AND RETURNED** *6/5/2002*

300136671 PORCH, DECK, SHED

P 515988-D

NOT TO SCALE

INDEXED

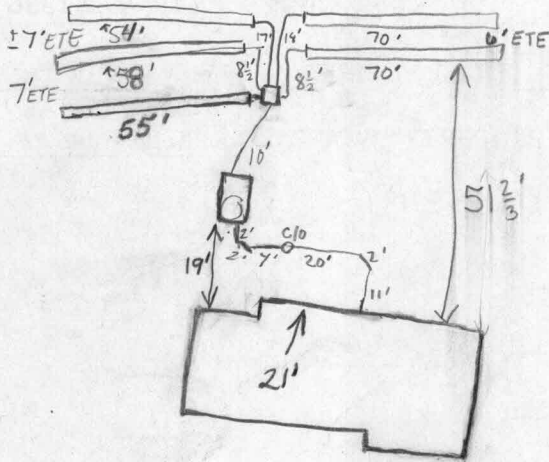

HO-94-2646

TRENCH DATA

TRENCH WIDTH 3'
 TRENCH INLET DEPTH 2.5'
 TRENCH BOTTOM DEPTH 4.5'
 DEPTH OF STONE 2'
 NUMBER OF TRENCHES 5
 TOTAL TRENCH LENGTH 300'+
 ABSORBENT AREA 900 sqft+
 DISTRIBUTION BOX LEVEL Yes
 BAFFLE IN DISTRIBUTION BOX Yes

SEPTIC TANK DATA

SEPTIC TANK 1500TS GALLONS
 MANHOLE RISER on front
 6 INCH INSPECTION PORT N/A

PUMP CHAMBER DATA N/A

~~PUMP CHAMBER GALLONS _____
 MANHOLE RISER _____
 ALARM _____
 PUMP PERFORMANCE TEST _____~~

PRE-CONSTRUCTION INSPECTION: Dorsey Mill Road 10/1/01 Homeowners want room for

deck, etc. So tank placed near left rear of house. O.K. to run 3-55' and

INSPECTION COMMENTS: 2-70' trenches from location after where tank set. (BB)

10/1/01 Tank set. First trench started (BB) 10/2/01 OKAY TO COVER TRENCHES.

HOUSE CONN OKAY (S/BB)


INSPECTOR Goede King, K

DATE SYSTEM APPROVED 10/2/01

BUILDING PERMIT SIGNED AND RETURNED

GENERAL NOTES:

- 1) THIS PLAT IS PREPARED FOR THE BENEFIT OF THE CLIENT SIGNING THE HOUSE LOCATION SURVEY APPROVAL FORM INsofar AS IT IS REQUIRED BY A LENDER OR TITLE INSURANCE COMPANY OR ITS AGENTS IN CONNECTION WITH THE CONTEMPLATED TRANSFER, FINANCING OR RE-FINANCING. UNLESS INDICATED AS BEING A BOUNDARY SURVEY, THIS PLAT IS NOT INTENDED FOR USE IN THE ESTABLISHMENT OF PROPERTY LINES AND IS NOT TO BE RELIED UPON FOR THE ESTABLISHMENT OR LOCATIONS OF FENCES, GARAGES, BUILDINGS OR OTHER EXISTING OR FUTURE IMPROVEMENTS. AS A RESULT, THIS PLAT DOES NOT PROVIDE FOR ACCURATE IDENTIFICATION OF PROPERTY LINE, BUT SUCH IDENTIFICATION MAY NOT BE REQUIRED FOR THE TRANSFER OF TITLE OR SECURING FINANCING OR RE-FINANCING.
- 2) SUBJECT PROPERTY IS SHOWN IN ZONE C ON THE NATIONAL FLOOD INSURANCE PROGRAM FLOOD INSURANCE RATE MAP OF HOWARD COUNTY, MARYLAND, COMMUNITY PANEL No. 210014 0020 B EFFECTIVE DATE: DEC. 4, 1988.
- 3) THE OFFSETS FROM BUILDING LINE TO PROPERTY LINE AS SHOWN ON THE PLAT HEREON ARE TO AN ACCURACY OF 1' PLUS OR MINUS (±).
- 4) NO TITLE REPORT FURNISHED, SUBJECT TO ALL EASEMENTS AND CONDITIONS OF RECORD.

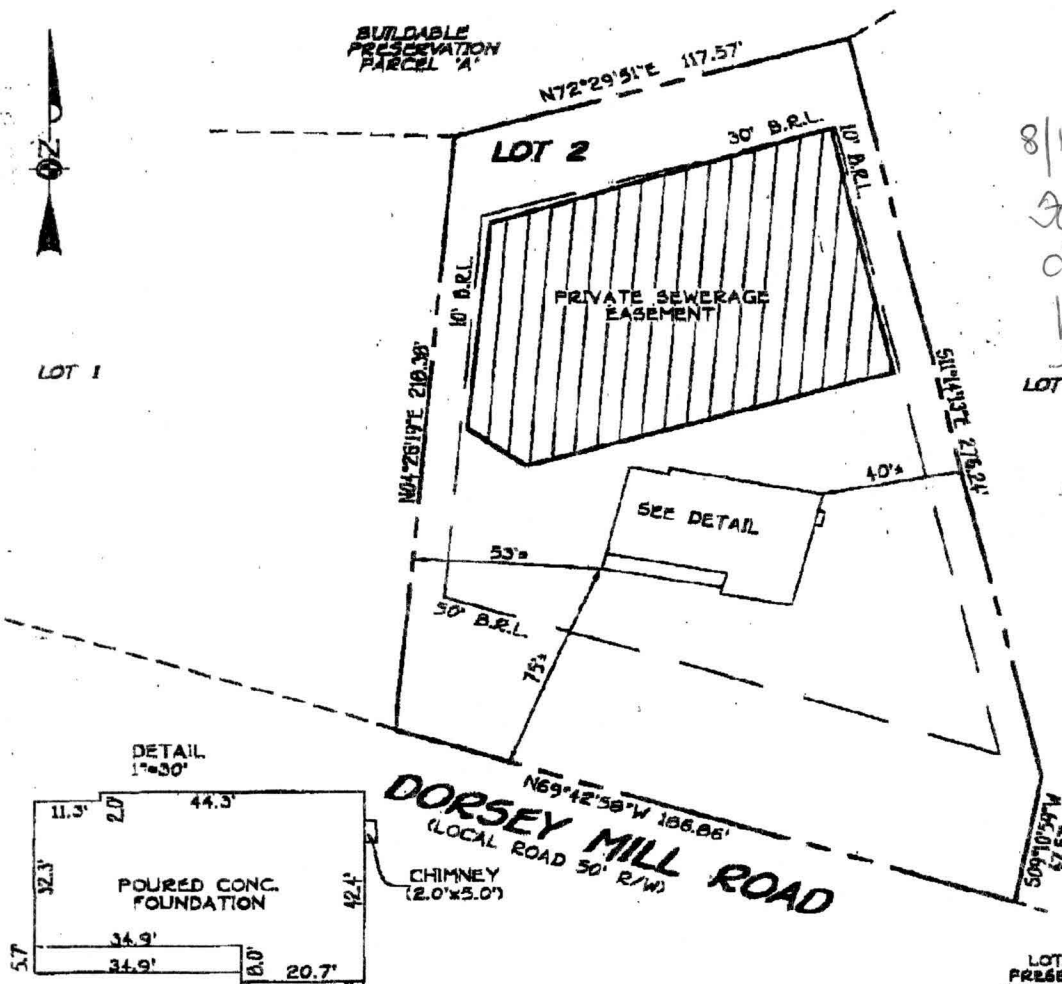

8/15/01
 Saved copy, distorted slightly, but it appears that house shifted back ~7' - OK to proceed DCC

B.R.L.-BUILDING RESTRICTION LINE
 TOP OF FOUNDATION ELEV. 545.7'

FISHER, COLLINS & CARTER, INC.
 CIVIL, ENGINEERING CONSULTANTS & LAND SURVEYORS

CENTENNIAL SQUARE, OFFICE PARK - 10672 BALTIMORE NATIONAL PIKE
 CLIKETT CITY, MARYLAND 21042
 410 750 3784

STATE OF MARYLAND
 CHARLES J. CROIG, JR.
 PROFESSIONAL LAND SURVEYOR
 No. 10769
 EXPIRES 12/31/02

[Signature]
 PROFESSIONAL LAND SURVEYOR
 REG. # 10769

8/15/01
 DATE

HOUSE LOCATION DRAWING

FOUNDATION LOCATION: 8/13/01
 FINAL LOCATION:
 BOUNDARY SURVEY: _____

SCALE: 1"=30'
 DATE: 8/15/01
 DRAWN BY: T.B.F.
 CHECKED BY: C.C.
 PROJECT No. 61607