

10/29/63 approved
B.H.

PERMIT

Repair # 07597
A _____

SEWAGE DISPOSAL SYSTEM

MARYLAND STATE DEPARTMENT OF HEALTH

HOWARD COUNTY

INDEXED

ELLICOTT CITY
INDEXED
DATE 10-22-63

Howard Triplett

IS PERMITTED TO INSTALL ALTER

ADDRESS _____ PHONE _____

A SEWAGE DISPOSAL SYSTEM LOCATED AT 2 Douglas Rd - 2nd house
on left from Manhattansville Rd - between Routes 70 and 147

SUBDIVISION _____ ROAD _____ LOT _____

PROPERTY OWNER Wm. Saunders

ADDRESS 2 Douglas Rd - E.C.

SPECIFICATIONS Repair

DRAIN FIELD _____ DEPTH _____ FEET, BOTTOM AREA _____ SQ. FT.

SEWAGE PITS _____ ABSORBENT SIDE-WALL AREA _____ SQ. FT.

SEPTIC TANK CAPACITY _____ GALLONS

FOR GARBAGE GRINDER, INCREASE DISPOSAL AREA 22% & TANK CAPACITY 50%.

OTHER Maximum system to be installed - 300 sq. ft.

No work is to be ~~started~~ ^{ceased} until ~~inspected~~


By the Health Dept.

PLANS APPROVED BY _____ DATE _____

FILL SEPTIC TANK AND DISTRIBUTION BOX WITH WATER BEFORE CALLING FOR AN INSPECTION. COVER NO WORK UNTIL INSPECTED AND APPROVED.

NEITHER THE HOWARD COUNTY COMMISSIONERS NOR THE HEALTH DEPARTMENT IS RESPONSIBLE FOR THE SUCCESSFUL OPERATION OF ANY SYSTEM.

07597

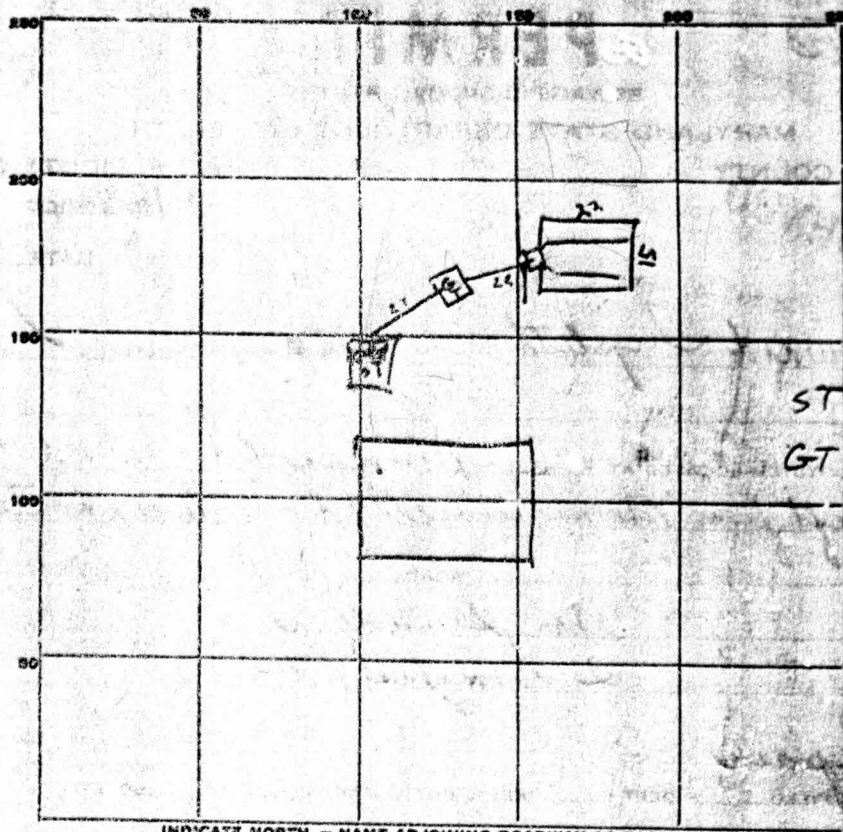

INDICATE NORTH. - NAME ADJOINING ROADWAY AS BASE LINE.

PERMIT CARD _____

SEPTIC TANK, LEVEL _____

CLEANOUTS _____

DISTRIBUTION BOX, LEVEL OK

LEAKING 2 1/2 IN. FIELD DEPTH 5 1/2 FT. TRENCH WIDTH 15 FT.
BED

GRAVEL DEPTH 24 IN. TOTAL LENGTH 23 FT.

NUMBER OF TRENCHES _____ TOTAL BOTTOM AREA 345

SEEPAGE PITS, INSIDE DIAMETER _____ FT. DEPTH BELOW INLET _____ FT.

ABSORBENT AREA _____ SQ. FT.

REMARKS Good soil in bed

Only 2 ft rock in bed. No rock over top of pipes. Unnecessary Grease Trap installed downstream from tank. However this is good enough for repair job.

DATE SYSTEM APPROVED 29 Oct 63

INSPECTOR Raymond Dodge