

# APPLICATION

A 30018

SEWAGE DISPOSAL TESTING

STATE OF MARYLAND - DEPARTMENT OF HEALTH AND MENTAL HYGIENE

P \_\_\_\_\_

HOWARD COUNTY HEALTH DEPARTMENT  
ENVIRONMENTAL HEALTH SERVICES  
P.O. BOX 476 ELLICOTT, MARYLAND 21043  
TELEPHONE: 992-2330

DISTRICT 4th

DATE 7/25/79

TO: THE COUNTY HEALTH OFFICER  
ELLICOTT CITY, MARYLAND

I, HEREBY, APPLY FOR THE NECESSARY TEST IN ORDER TO CONSTRUCT (OR RECONSTRUCT) A SEWAGE DISPOSAL SYSTEM.

PROPERTY OWNER William Swann

ADDRESS 12979 Clarksville Pike, Highland, Md. 20777 PHONE \_\_\_\_\_

PROPERTY LOCATION:

SUBDIVISION Jaycox Prpperty LOT NO. BACK LOT  
Resubdivision of Lot 12  
Lot 24

ROAD AND DESCRIPTION Duvall Road

SIZE OF LOT \_\_\_\_\_ TYPE BLDG. 3 or 4 bedrooms

THE SYSTEM INSTALLED UNDER THIS APPLICATION IS ACCEPTABLE ONLY UNTIL PUBLIC FACILITIES BECOME AVAILABLE.

I FULLY UNDERSTAND THE FEE CONNECTED WITH THE FILING OF THIS PERC TEST APPLICATION IS NON-REFUNDABLE UNDER

ANY CIRCUMSTANCES.

SIGNATURE OF APPLICANT /s/ William Swann

APPROVED BY \_\_\_\_\_ FOR \_\_\_\_\_ DATE \_\_\_\_\_

REJECTED BY \_\_\_\_\_ FOR \_\_\_\_\_ DATE \_\_\_\_\_

HOLD PENDING FURTHER TESTS \_\_\_\_\_ DATE \_\_\_\_\_

REASONS FOR REJECTION OR HOLDING 8/16/79 - PERC TIME OK

CERTIFIED HOLES NEEDED BH

**THIS IS NOT A PERMIT**

A 30018  
NAYCOX PROPERTY  
LOT 24  
BACK LOT

3 BEDROOMS - 1000 GALLON TANK



4 BEDROOMS - 1250 GALLON TANK

DEEP TRENCHES - 153 sq. ft. one sidewall area per bedroom. Ditch is to be  
2 ft. wide, 9 ft. deep, with inlet at 3  
ft. below original grade and filled with 6 ft. of stone. Length of the  
ditch deepens on the number of sq. ft. needed. Start the ditch at perc hole # 2  
and run it along level ground toward perc hole # 3. Perc hole # 2 is located  
120 ft. from the FRONT lot line and 162 ft. from the LEFT  
lot line as seen when facing the lot from DUVALL road.  
Perc hole # 3 is located 112 ft. from the FRONT lot line and 100  
ft. from the RIGHT lot line as seen when facing the lot from DUVALL  
road.


BACK

12B

SCOOPER

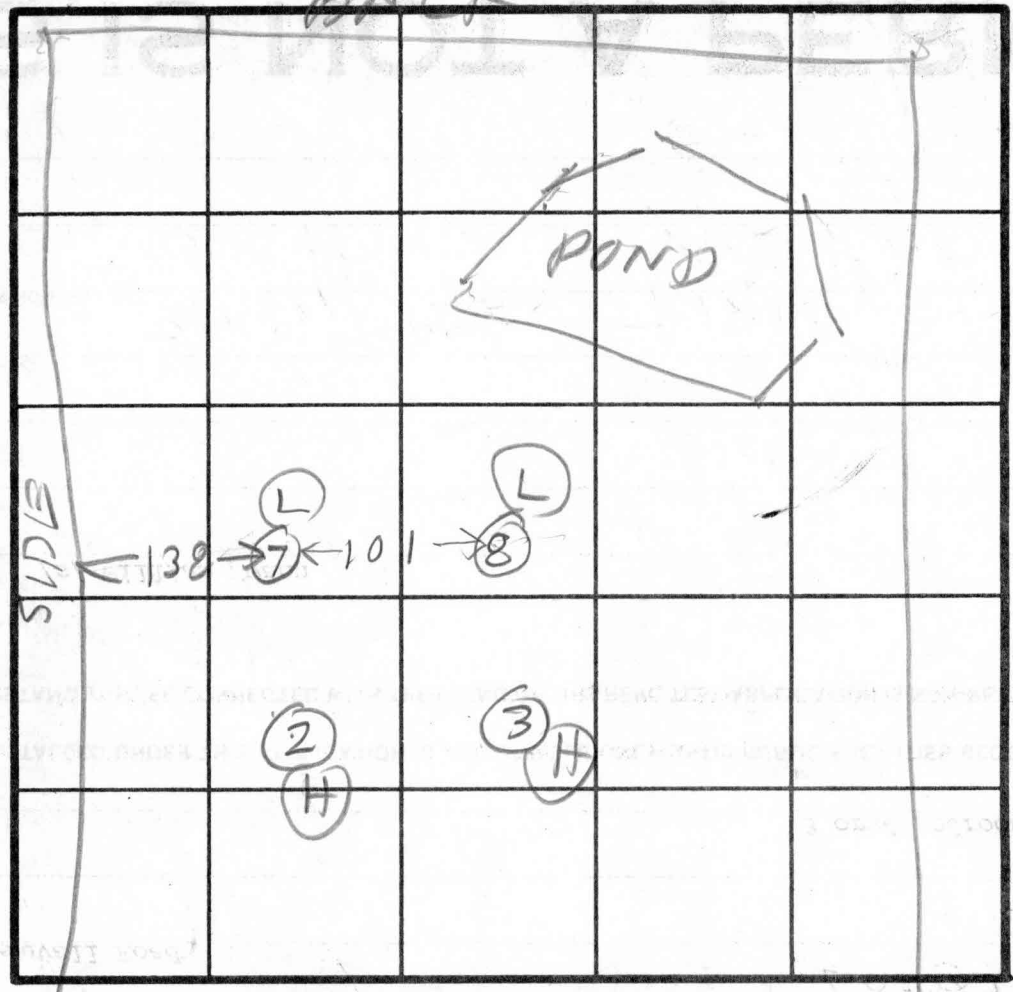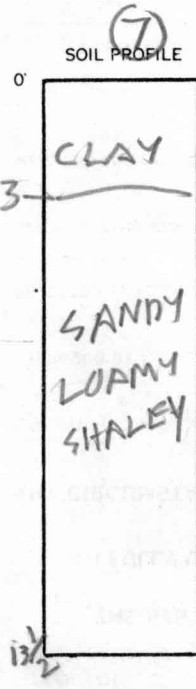

INDICATE NORTH - NAME ADJOINING ROADWAY AS BASE LINE.

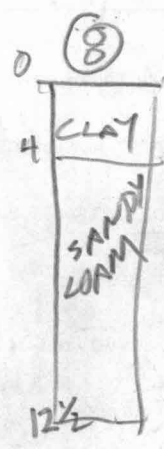


DATE	TEST NO.	DEPTH	PRE-WET		TEST - 1" DROP		TIME
			START	STOP	START	STOP	
7/26/77	7D	13 1/2	1055	1057	1057	1100	3
	7S	5 1/2	1057	1100	1100	1103	3
	8D	12 1/2	1108	1122	1122	1128	6
	8S	4 1/2	1119	1123	1123	1128	6
			1138				

REMARKS \_\_\_\_\_

TYPE OF SOIL \_\_\_\_\_

TESTED BY RH

ALSO PRESENT O. KOTTERMAN SWANN

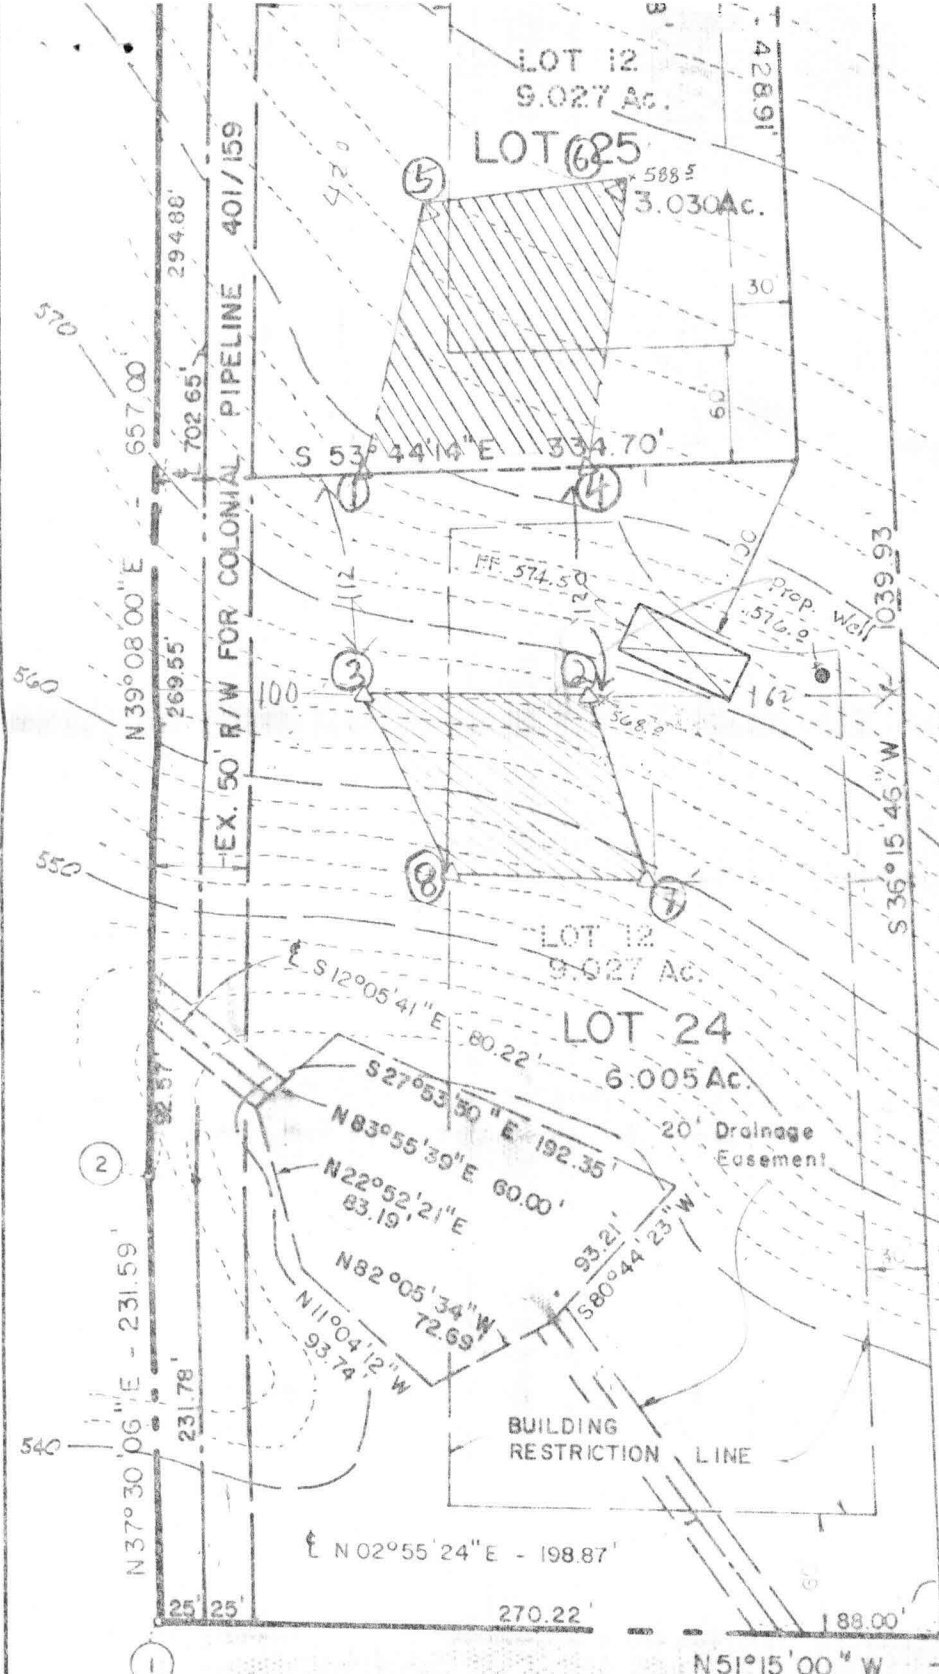

GENERAL NOTES

1. This area designates a private sewage easement of approximately 10,000 square feet as required by the Maryland State Health Department for individual sewage disposal. Improvements of any nature in this area are restricted until public sewage is available and servicing any residential structure on these building sites. This easement shall become null and void upon these connections to a public sewage system.
2. The lots shown hereon comply with the minimum ownership width and lot area as required by the Maryland State Department of Health and Mental Hygiene.
3. Percolation tests have been field located as shown  $\Delta$ .

E. W. GRAMKOW  
534/419


TITLE:  
PERCOLATION CERTIFICATION  
Scale 1"=100'

C. MILTON JAYCOX PROPERTY  
LOTS 24 & 25  
a resubdivision of lot 12  
fourth election district  
Howard County, Maryland

APPROVED: For private water and private sewerage systems  
Howard County Health Department  
\_\_\_\_\_  
County Health Officer      Date



TYDINGS-OHEIM ASSOC., INC  
8370 Court Avenue  
Ellicott City, Md.  
21043  
465-0660

JACOX

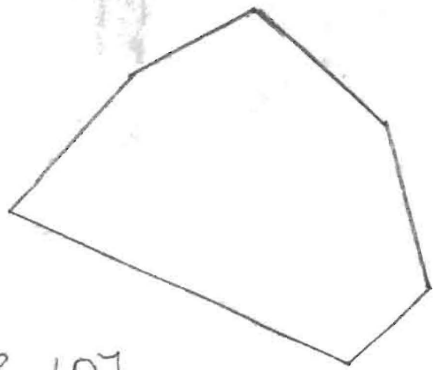

LOT 24

12

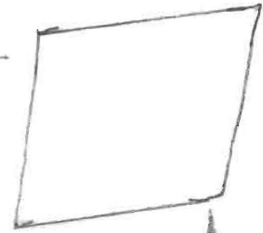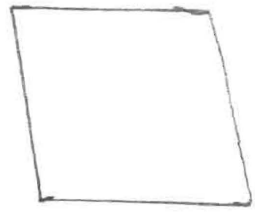

25

278'

front  
prop. line