

7/3/01
Repair
10:00
8/8/01-2=30 Final
04-315316

PERMIT

SEWAGE DISPOSAL SYSTEM
HOWARD COUNTY HEALTH DEPARTMENT
BUREAU OF ENVIRONMENTAL HEALTH
410-313-2640

P 515 300

A REPAIR

ISSUE DATE 6/21/2001

APPROVAL DATE 8/8/01

INDEXED

Fogles Septic Clean, Inc IS PERMITTED TO INSTALL ALTER X

ADDRESS 580 Obrecht Road, Sykesville, MD 21784 PHONE 410-795-5670

SUBDIVISION _____ LOT NUMBER _____ ADDRESS 280 E Watersville Road

PROPERTY OWNER Evelyn Fountain PROPERTY OWNER'S ADDRESS Same

SEPTIC TANK CAPACITY 1200+ GALLONS (plastic tank)

PUMP CHAMBER CAPACITY _____ GALLONS

NUMBER OF BEDROOMS 3

SQUARE FEET PER BEDROOM 180

LINEAR FEET OF TRENCH REQUIRED 180

TRENCHES: Trenches to be 3 feet wide. Inlet 1.5 feet below original grade. Bottom maximum depth 2.5 feet below original grade. 1.0 feet of stone below distribution box. (use 1' infiltrators)

LOCATION: _____

REPAIR - PURPOSE - Existing septic system has failed.
Call for inspection when ground is opened so sanitarian can recommend repair. 6-21-01

Install 2-90' trenches near to perc hole closer to house
Trenches to be 7' edge to edge
old tank to be pumped and collapsed.

PLANS APPROVED DKC DATE 7-8-01

PERMIT VOID AFTER 2 YEARS

NOTE: CONTRACTOR RESPONSIBLE FOR SCHEDULING A PRE-CONSTRUCTION INSPECTION FOR ALL INSTALLATIONS

NOTE: TOP OF SEPTIC TANKS ARE TO BE NO DEEPER THAN 3.0 FEET BELOW FINISH GRADE

NOTE: WATERTIGHT SEPTIC TANKS REQUIRED

NOTE: CLEANOUT REQUIRED EVERY 70 FEET OF SEWER LINE AND/OR AT 90° SWEEPS IN LINES FROM HOUSE TO DRAIN FIELDS, 90° ELBOWS ARE NOT ACCEPTABLE

NOTE: ALL PARTS OF SEPTIC SYSTEMS (I.E. TANK, DISTRIBUTION BOX, DRAINFIELDS) TO BE 100 FEET FROM ANY WATER WELL UNLESS OTHERWISE SPECIFICALLY AUTHORIZED

NOTE: NO ABSORPTION TRENCH TO EXCEED 100 FEET IN LENGTH UNLESS SPECIFICALLY AUTHORIZED

NOTE: ALL PIPE FROM HOUSE TO SEPTIC TANK MUST BE CAST IRON OR SCHEDULE 35/40 PVC OR ABS

NOTE: MANHOLE RISERS REQUIRED ON ALL SEPTIC TANKS AND PUMP CHAMBERS

NOTE: DISTRIBUTION BOXES MUST HAVE BAFFLES

NOTE: IF PUMPED SEPTIC SYSTEM REQUIRED, (1) SEPTIC PUMP DETAIL TO BE PROVIDED BY INSTALLER PRIOR TO ISSUANCE OF SEPTIC PERMIT (2) PUMP PERFORMANCE TEST IS NECESSARY PRIOR TO HEALTH DEPARTMENT APPROVAL OF SEPTIC PERMIT


NEITHER THE HOWARD COUNTY COUNCIL NOR THE HEALTH DEPARTMENT IS RESPONSIBLE FOR THE SUCCESSFUL OPERATION OF ANY SYSTEM
PERMITTEE RESPONSIBLE FOR OBTAINING FINAL APPROVAL ON THIS PERMIT
CALL 410-313-2640 FOR INSPECTION OF SEPTIC SYSTEM

4515300

topsoil
org. brn
2" lim
wish
frog
org. brn
si. line
Refuse

① 10:28 10:29 10:31

NOT TO SCALE

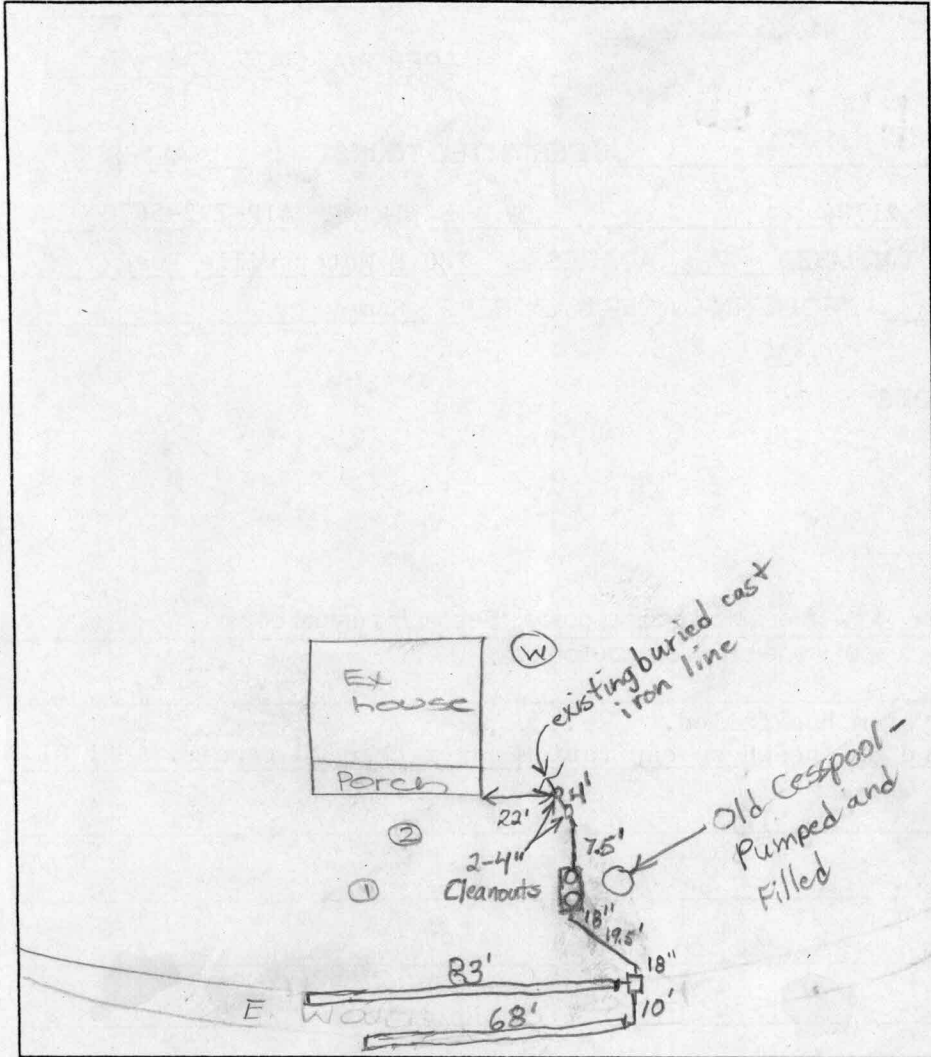

TRENCH DATA

TRENCH WIDTH 3'

TRENCH INLET DEPTH 2'

TRENCH BOTTOM DEPTH 3'

DEPTH OF STONE Infiltrator

NUMBER OF TRENCHES 2

TOTAL TRENCH LENGTH 151'

ABSORBENT AREA 453 sq. ft.

DISTRIBUTION BOX LEVEL Yes

BAFFLE IN DISTRIBUTION BOX Yes

SEPTIC TANK DATA

SEPTIC TANK 1250 Plastic GALLONS

MANHOLE RISER 2

6 INCH INSPECTION PORT No

PUMP CHAMBER DATA

PUMP CHAMBER GALLONS _____

MANHOLE RISER _____

ALARM _____

PUMP PERFORMANCE TEST _____

PRE-CONSTRUCTION INSPECTION: _____

INSPECTION COMMENTS: 8/8/01 System satisfactory. Plastic septic tank and infiltrators used. Old cesspool pumped and filled with dirt. O.K. to cover. (BB)

INSPECTOR B. Baker DATE SYSTEM APPROVED 8/8/01