

# APPLICATION

A 21359

SEWAGE DISPOSAL TESTING

P \_\_\_\_\_

STATE OF MARYLAND - DEPARTMENT OF HEALTH AND MENTAL HYGIENE

HOWARD COUNTY HEALTH DEPARTMENT  
ENVIRONMENTAL HEALTH SERVICES

DISTRICT 4TH

P. O. BOX 476, ELLICOTT CITY, MARYLAND 21043  
TELEPHONE: 465-5000, EXT. 356

DATE 4/18/75

*See attached paper for specs*

*6/25/75  
9:30*

TO: THE COUNTY HEALTH OFFICER  
ELLICOTT CITY, MARYLAND

I, HEREBY, APPLY FOR THE NECESSARY TEST IN ORDER TO CONSTRUCT (OR RECONSTRUCT) A SEWAGE DISPOSAL SYSTEM.

PROPERTY OWNER Albert G. Warfield property

ADDRESS Sunnyside Farm, Florence Road, Woodbine, Md. Any questions call: 442-2642

PROPERTY LOCATION: Mr. Grankow (old 1 part of lot 3 July 80)

SUBDIVISION Plat 10/79 Proposed #1 LOT NO. \_\_\_\_\_

ROAD AND DESCRIPTION Ed Warfield Road - Daisy Rd. to Ed Warfield Rd. stay on Warfield Rd. - 1st farm on right after passing Florence Rd. - lock for trees later on Ed. Warfield Rd.)

SIZE OF LOT 17.169 acres TYPE BLDG. 3 or 4 bedrooms  
4,627 ac NUMBER OF BEDROOMS \_\_\_\_\_

IF NOT SINGLE RESIDENCE DESCRIBE \_\_\_\_\_

THE SYSTEM INSTALLED UNDER THIS APPLICATION IS ACCEPTABLE ONLY UNTIL PUBLIC FACILITIES BECOME AVAILABLE.

SIGNATURE OF APPLICANT [Signature]

APPROVED BY Raymond Hodges FOR Ray Veld & Patch DATE 9/11/80  
(KIND OF SYSTEM)

REJECTED BY \_\_\_\_\_ FOR \_\_\_\_\_ DATE \_\_\_\_\_  
(KIND OF SYSTEM)


HOLD PENDING FURTHER TESTS WWE DATE 6/25/75

REASONS FOR REJECTION OR HOLDING final plat  
9/11/80 FINAL PLAT HAS BEEN SIGNED

# THIS IS NOT A PERMIT

# Lot 1

①  
 0  
 3 1/2  
 clayish  
 sandy type  
 very little  
 shale  
 12  
 cut

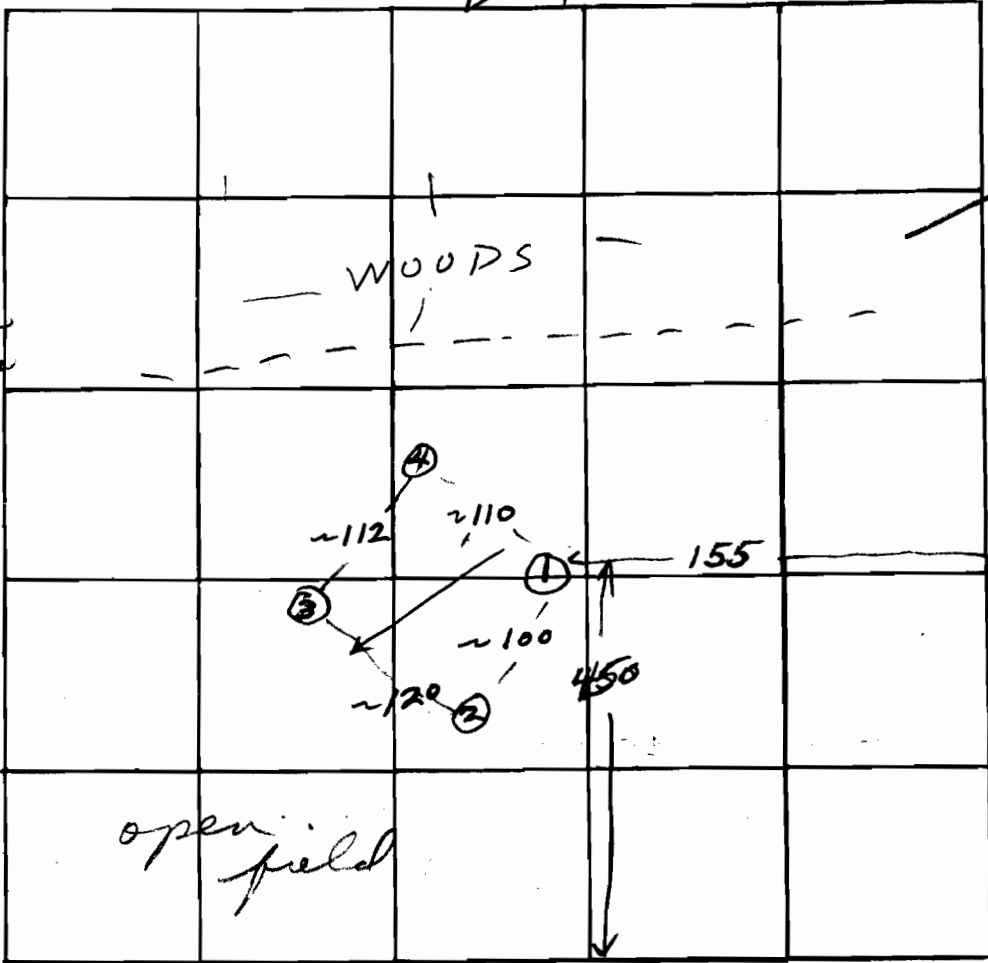

Scepter  
 for location  
 of holes

FLORENCE RD

INDICATE NORTH. - NAME ADJOINING ROADWAY AS BASE LINE  
 ED WARFIELD RD

DATE	TEST NO.	DEPTH	PRE-WET		TEST - 1" DROP		TIME	
			START	STOP	START	STOP		
6/25/75	1	4	9:53	10:00	10:00	10:15	15	
	1-A	12	9:53	9:59	9:59	10:13	14	
	2	4	10:03	10:09	10:09	10:25	16	
	2-A	11 1/2	10:02	10:03	10:03	10:05	2	
too	3	4	10:13	10:16	10:16	10:26	10	
	3-A	11 1/2	10:11	10:20	10:20	10:47	27	
	4	11	Vertical; more shale, but enough soil					

REMARKS \_\_\_\_\_

TYPE OF SOIL \_\_\_\_\_

TESTED BY \_\_\_\_\_ ALSO PRESENT: \_\_\_\_\_

