

ADDITIONAL HOLES DUG FOR LOT 49


COUNTY # \_\_\_\_\_

SOIL PROFILE

190B  
Brown loam 1 1/2'  
Red Si Clay loam 5'  
Silt loam 13'  
Yellow Brown S loam 2'  
L590 Rock 3 1/2'

190C  
DK Brown loam 2'  
Red Si Clay loam 3 1/2'  
Red Si loam 6'  
Yellow Brown S loam 12'  
L590 Rock 17'

190D  
DK Brown loam 1'  
Brown Si loam 2 1/2'  
Yellow Brown S loam 17'

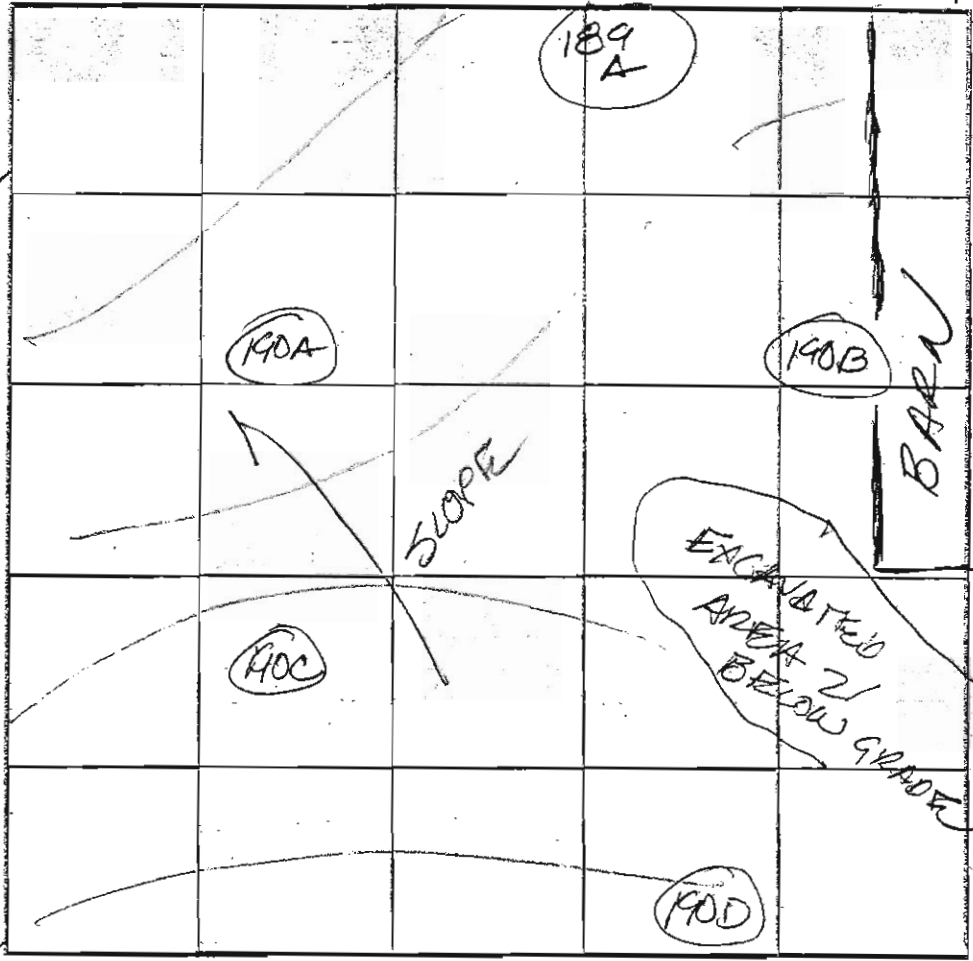

SOIL PROFILE

189A  
Brown loam 3"  
Loam 75090 Cherty Gneiss 3"  
Hard Gneiss Bottom

190A  
DK Brown loam 8"  
Red Si Clay loam 4 1/2'  
Yellow Brown S loam 12'  
L590 Rock

INDICATE NORTH - NAME ADJOINING ROADWAY AS BASE LINE.

DATE	TEST NO.	DEPTH	PRE-WET		TEST - 1" DROP		TIME	
			START	STOP	START	STOP		
7/30/03	190B	6' 1/2'	12 <sup>00</sup>	12 <sup>03</sup>	12 <sup>03</sup>	12 <sup>07</sup>	4min	
	190C	6' 1/2'	12 <sup>23</sup>	12 <sup>39</sup>	12 <sup>39</sup>	12 <sup>55</sup>	16min	
	190D	5 1/2'	12 <sup>49</sup>	12 <sup>52</sup>	12 <sup>52</sup>	12 <sup>56</sup>	4min	
	189A	5 SHALLOW ROCKS	NOT TESTED					
	190A	5 1/2'	11 <sup>40</sup>	11 <sup>44</sup>	11 <sup>44</sup>	11 <sup>48</sup>	4min	

REMARKS \_\_\_\_\_

TYPE OF SOIL FA

TESTED BY \_\_\_\_\_ ALSO PRESENT Bob Sheehy  
Mark Johnson

TRENCH DESIGN DATA. AVERAGE PERCOLATION TIME \_\_\_\_\_ TRENCH WIDTH \_\_\_\_\_


COUNTY #

SOIL PROFILE

0' 190  
 DK Brown Loam 1/2'  
 Red Silty loam 3 1/2'  
 Yellow Brown Silty loam 1/2'  
 Silty loam 15' 90 rock

189  
 DK Brown loam 8"  
 Compacted Red Silty loam 3'  
 Yellow Brown Silty loam 35-50% 4 1/2'

191  
 DK Brown loam 8"  
 150 90 Stony Gneiss 5'  
 Brown Silty loam 11'

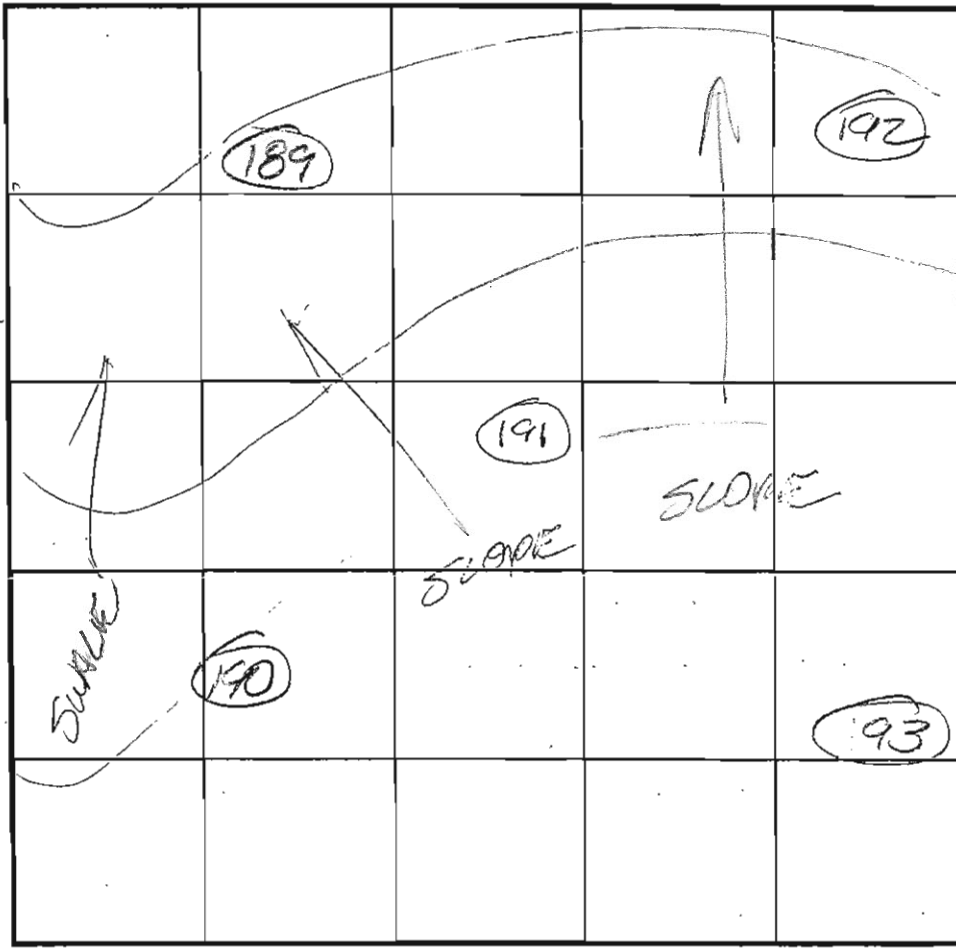


SOIL PROFILE

0' 192  
 Brown loam 8'  
 Brown Silty loam 35-50% Gneiss 6'  
 Brown Silty loam 40-50% Gneiss 8'  
 Lt Brown loamy sand HARD BOTTOM 11'

INDICATE NORTH - NAME ADJOINING ROADWAY AS BASE LINE.

DATE	TEST NO.	DEPTH	PRE-WET		TEST - 1" DROP		TIME
			START	STOP	START	STOP	
7/30/03	190	5' / 13	10:57	11:02	11:02	11:10	8 min
	189	4' / 9 1/2	11:20	11:27	11:27	11:32	5 min
	193	NOT DUG					
	192	DUG BUT NOT TESTED BECAUSE OF ROCK ON FEEL					F
	191	5 1/2' / 11'	1:57	2:01	2:01	2:09	8 min

REMARKS \_\_\_\_\_  
 TYPE OF SOIL \_\_\_\_\_  
 TESTED BY FR ALSO PRESENT Bob Sheekey  
Mark Johnson  
 TRENCH DESIGN DATA: AVERAGE PERCOLATION TIME \_\_\_\_\_ TRENCH WIDTH \_\_\_\_\_  
 INLET DEPTH \_\_\_\_\_ MAXIMUM BOTTOM DEPTH \_\_\_\_\_ SQ. FT./BEDROOM \_\_\_\_\_

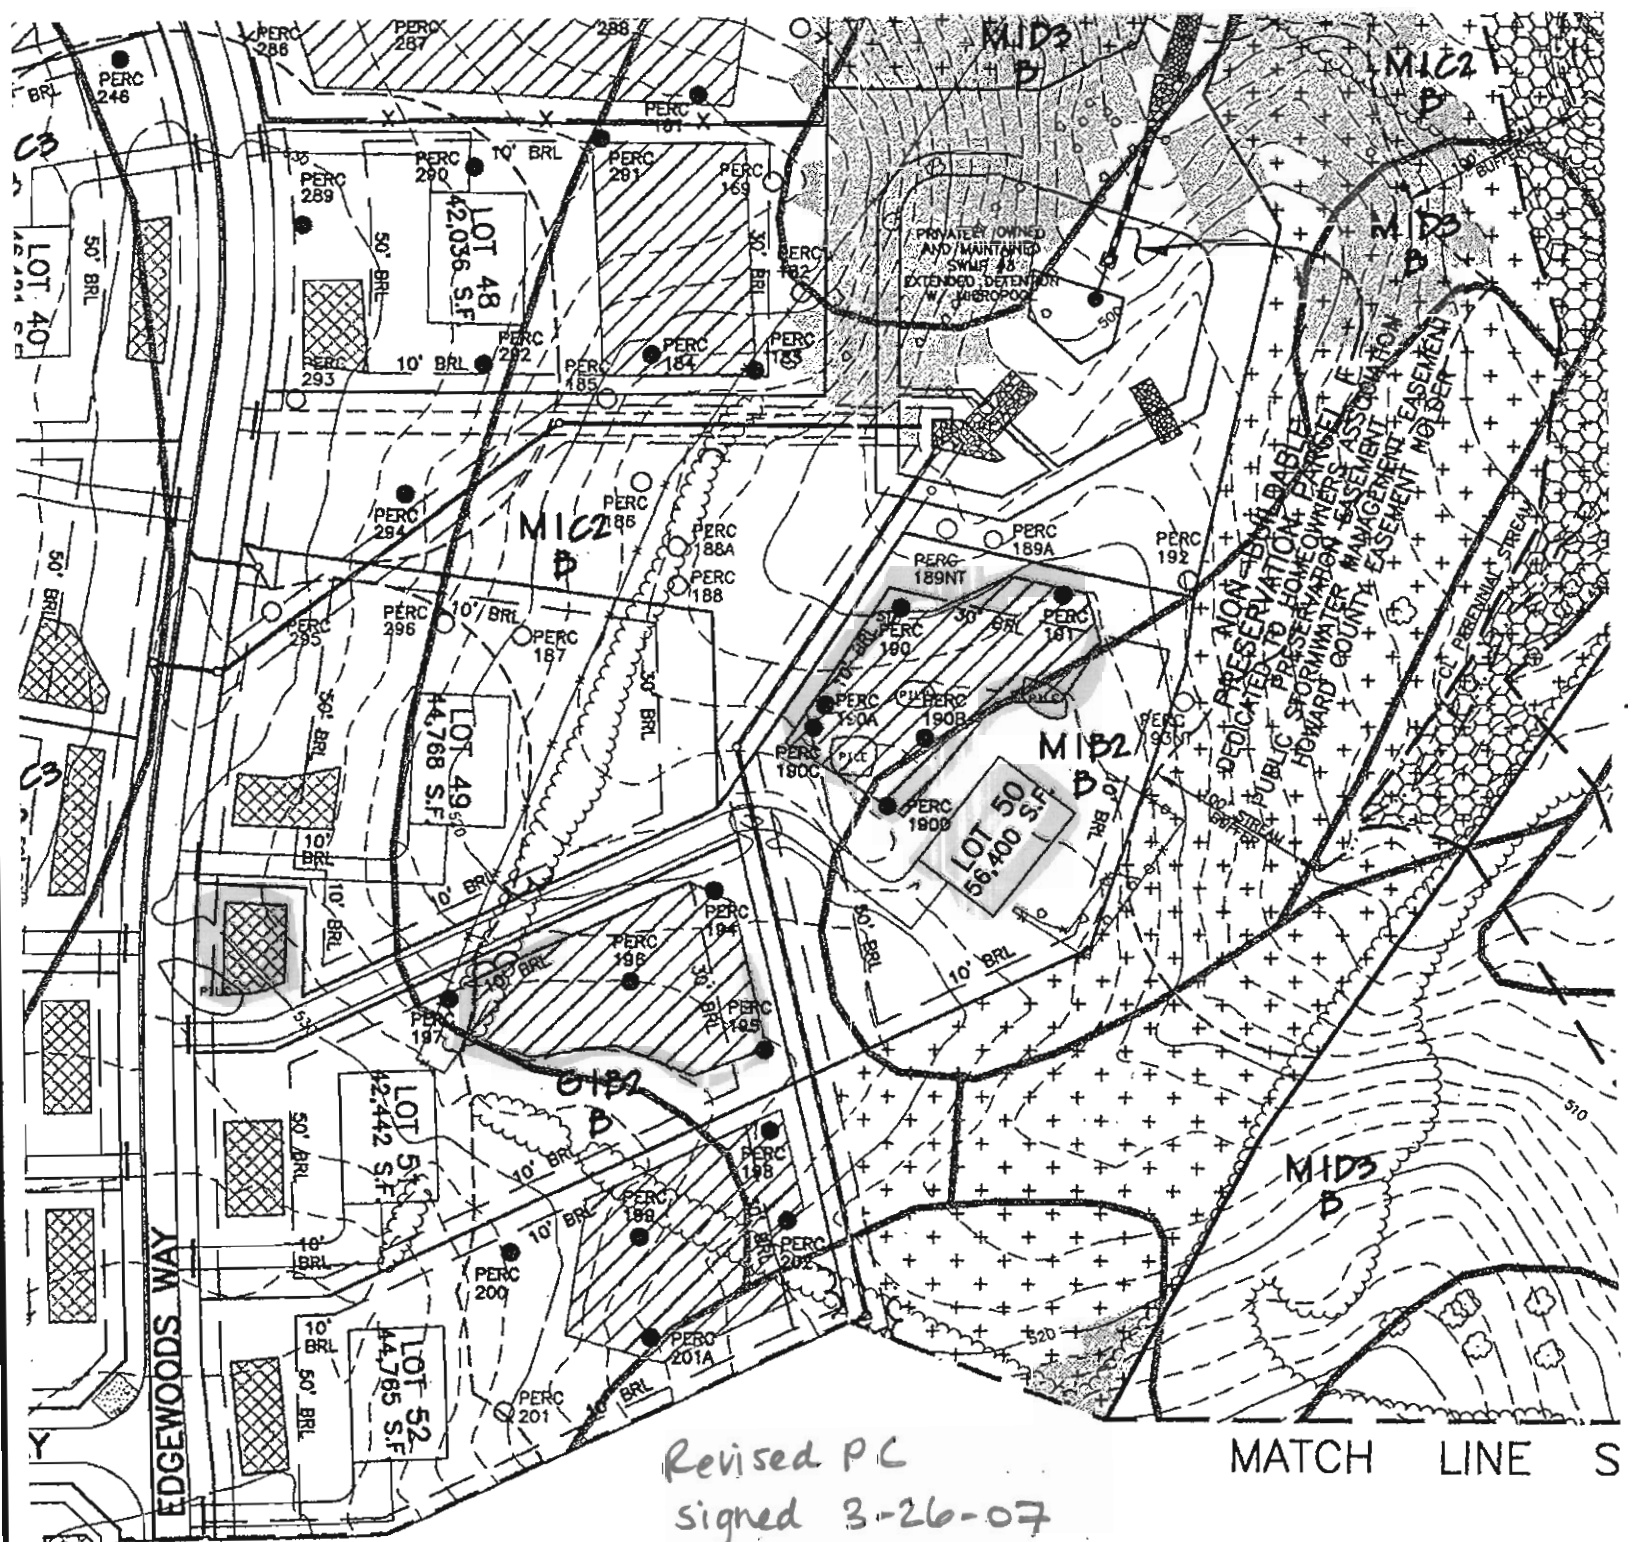

PLAN VIEW  
SCALE: 1" = 100'

I CERTIFY THAT THE INFORMATION SHOWN HEREON IS BASED ON FIELD WORK PERFORMED BY ME OR UNDER MY DIRECT SUPERVISION, AND IS CORRECT, TO THE BEST OF KNOWLEDGE AND BELIEF.

DAVID THOMPSON  
PLAN PREPARER

