

# APPLICATION

6/21/84.  
1:30 P.M.  
Per. RECORDED  
15 YEARS AGO

SEWAGE DISPOSAL TESTING

A 33999

STATE OF MARYLAND - DEPARTMENT OF HEALTH AND MENTAL HYGIENE

P \_\_\_\_\_

HOWARD COUNTY HEALTH DEPARTMENT  
ENVIRONMENTAL HEALTH SERVICES

DISTRICT 1st.

P. O. BOX 476 ELLICOTT CITY, MARYLAND 21043  
TELEPHONE: 992-2330

DATE 6/13/84

INLET MAX. 3'  
Total max. depth. 6'-7'

Trench to be located 750' from change in direction point, which is  
(meeting of 203' & 173' lines) test hole # 3. Hole is approx 20'  
from change in direction and 70' from corner of garage.  
can possibly be moved closer to house if ground similar.

TO: THE COUNTY HEALTH OFFICER  
ELLICOTT CITY, MARYLAND

I, HEREBY, APPLY FOR THE NECESSARY TEST IN ORDER TO CONSTRUCT (OR RECONSTRUCT) A SEWAGE DISPOSAL SYSTEM.

PROPERTY OWNER WILLIAM R POWELL (CLINTON ROUTH = PURCHASER)

ADDRESS 5124 DURHAM RD PHONE 687-1000

COLUMBIA MD. 21044

PROPERTY LOCATION:  
SUBDIVISION ELIBANK DR. (END) LOT NO. PARCEL 96

# 6426 ROAD AND DESCRIPTION ELIBANK DR.

Clinton Routh 687-1000 BP# 59987

SIZE OF LOT 1.22 ACRES TYPE BLDG. SFD.  
(NUMBER OF BEDROOMS)

THE SYSTEM INSTALLED UNDER THIS APPLICATION IS ACCEPTABLE ONLY UNTIL PUBLIC FACILITIES BECOME AVAILABLE. I FULLY UNDERSTAND THE  
FEE CONNECTED WITH THE FILING OF THIS PERC TEST APPLICATION IS NON-REFUNDABLE UNDER ANY CIRCUMSTANCES. I ALSO AGREE TO COMPLY  
WITH ALL M.O.S.H.A. REQUIREMENTS IN TESTING THIS LOT.

*William R Powell*  
(SIGNATURE OF APPLICANT)

APPROVED BY \_\_\_\_\_ FOR \_\_\_\_\_ DATE \_\_\_\_\_

REJECTED BY \_\_\_\_\_ FOR \_\_\_\_\_ DATE \_\_\_\_\_

HOLD PENDING FURTHER TESTS \_\_\_\_\_ DATE \_\_\_\_\_

REASONS FOR REJECTION OR HOLDING 6/21/84 Per OK Hold for den  
Certification Plat RH

BLDG. PERMIT SIGNED  
AND RETURNED 8-26-84

# THIS IS NOT A PERMIT

# APPLICATION

SEWAGE DISPOSAL TESTING

STATE OF MARYLAND - DEPARTMENT OF HEALTH AND MENTAL HYGIENE

A 33999

P \_\_\_\_\_

HOWARD COUNTY HEALTH DEPARTMENT  
ENVIRONMENTAL HEALTH SERVICES

P. O. BOX 476 ELLICOTT CITY, MARYLAND 21043  
TELEPHONE: 992-2330

DISTRICT 1st.

DATE 6/13/84

TO: THE COUNTY HEALTH OFFICER  
ELLICOTT CITY, MARYLAND

I, HEREBY, APPLY FOR THE NECESSARY TEST IN ORDER TO CONSTRUCT (OR RECONSTRUCT) A SEWAGE DISPOSAL SYSTEM.

PROPERTY OWNER WILLIAM R POWELL (CLINTON ROUTH = PURCHASER)

ADDRESS 5124 DURHAM RD PHONE 687-1000

PROPERTY LOCATION: COLUMBIA MD. 21044

SUBDIVISION ELIBANK DR. (END) LOT NO. PARCEL 96

ROAD AND DESCRIPTION ELIBANK DR.

SIZE OF LOT 1.22 ACRES TYPE BLDG. SM (NUMBER OF BEDROOMS)

THE SYSTEM INSTALLED UNDER THIS APPLICATION IS ACCEPTABLE ONLY UNTIL PUBLIC FACILITIES BECOME AVAILABLE. I FULLY UNDERSTAND THE FEE CONNECTED WITH THE FILING OF THIS PERC TEST APPLICATION IS NON-REFUNDABLE UNDER ANY CIRCUMSTANCES. I ALSO AGREE TO COMPLY WITH ALL M.O.S.H.A. REQUIREMENTS IN TESTING THIS LOT.

[Signature]  
(SIGNATURE OF APPLICANT)

APPROVED BY \_\_\_\_\_ FOR \_\_\_\_\_ DATE \_\_\_\_\_


REJECTED BY \_\_\_\_\_ FOR \_\_\_\_\_ DATE \_\_\_\_\_

HOLD PENDING FURTHER TESTS \_\_\_\_\_ DATE \_\_\_\_\_

REASONS FOR REJECTION OR HOLDING \_\_\_\_\_

# THIS IS NOT A PERMIT



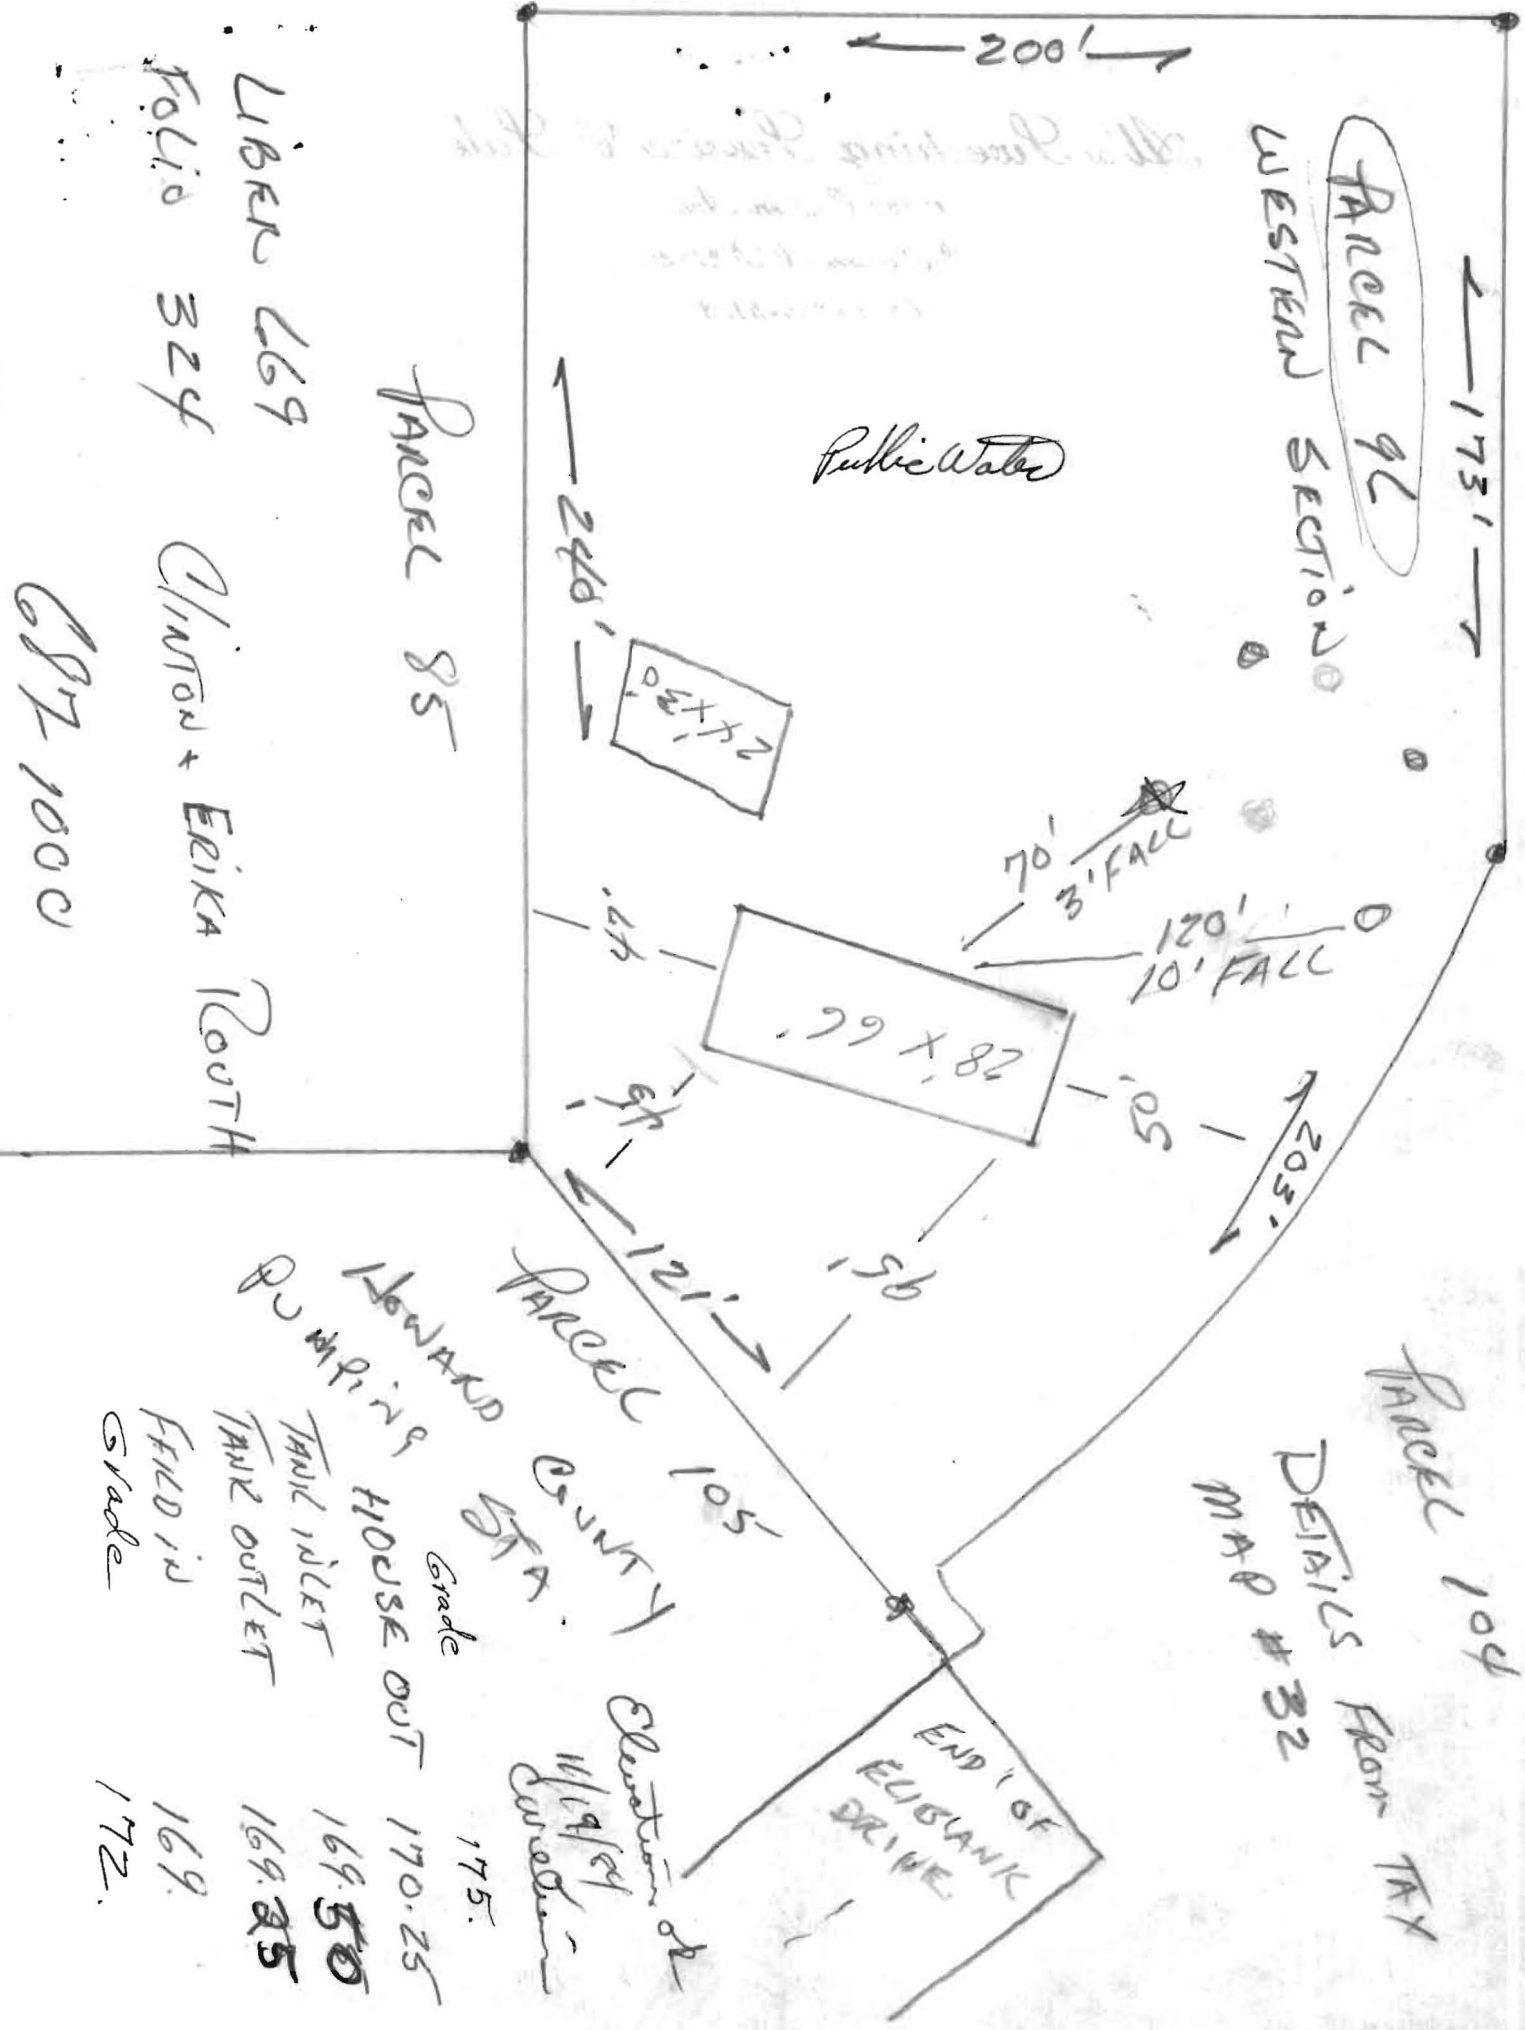

Parcel 92

WESTERN SECTION

Public Water

24 x 30

79 x 82

70' 3' FALL

120' 10' FALL

Parcel 104

DETAILS FROM TAX MAP # 32

Parcel 105

END OF EUBANK DRIVE

ELECTRICAL 11/19/94  
CANDIDIAN

LIBER 669  
Folio 324  
CLINTON & ERIKA ROOTH


Parcel 85

897 1000

HOWARD COUNTY  
Grade  
HOUSE OUT 170.25  
PUMPING  
TANK INLET 169.50  
TANK OUTLET 169.25  
FIELD IN 169.  
Grade 172.

002

11199

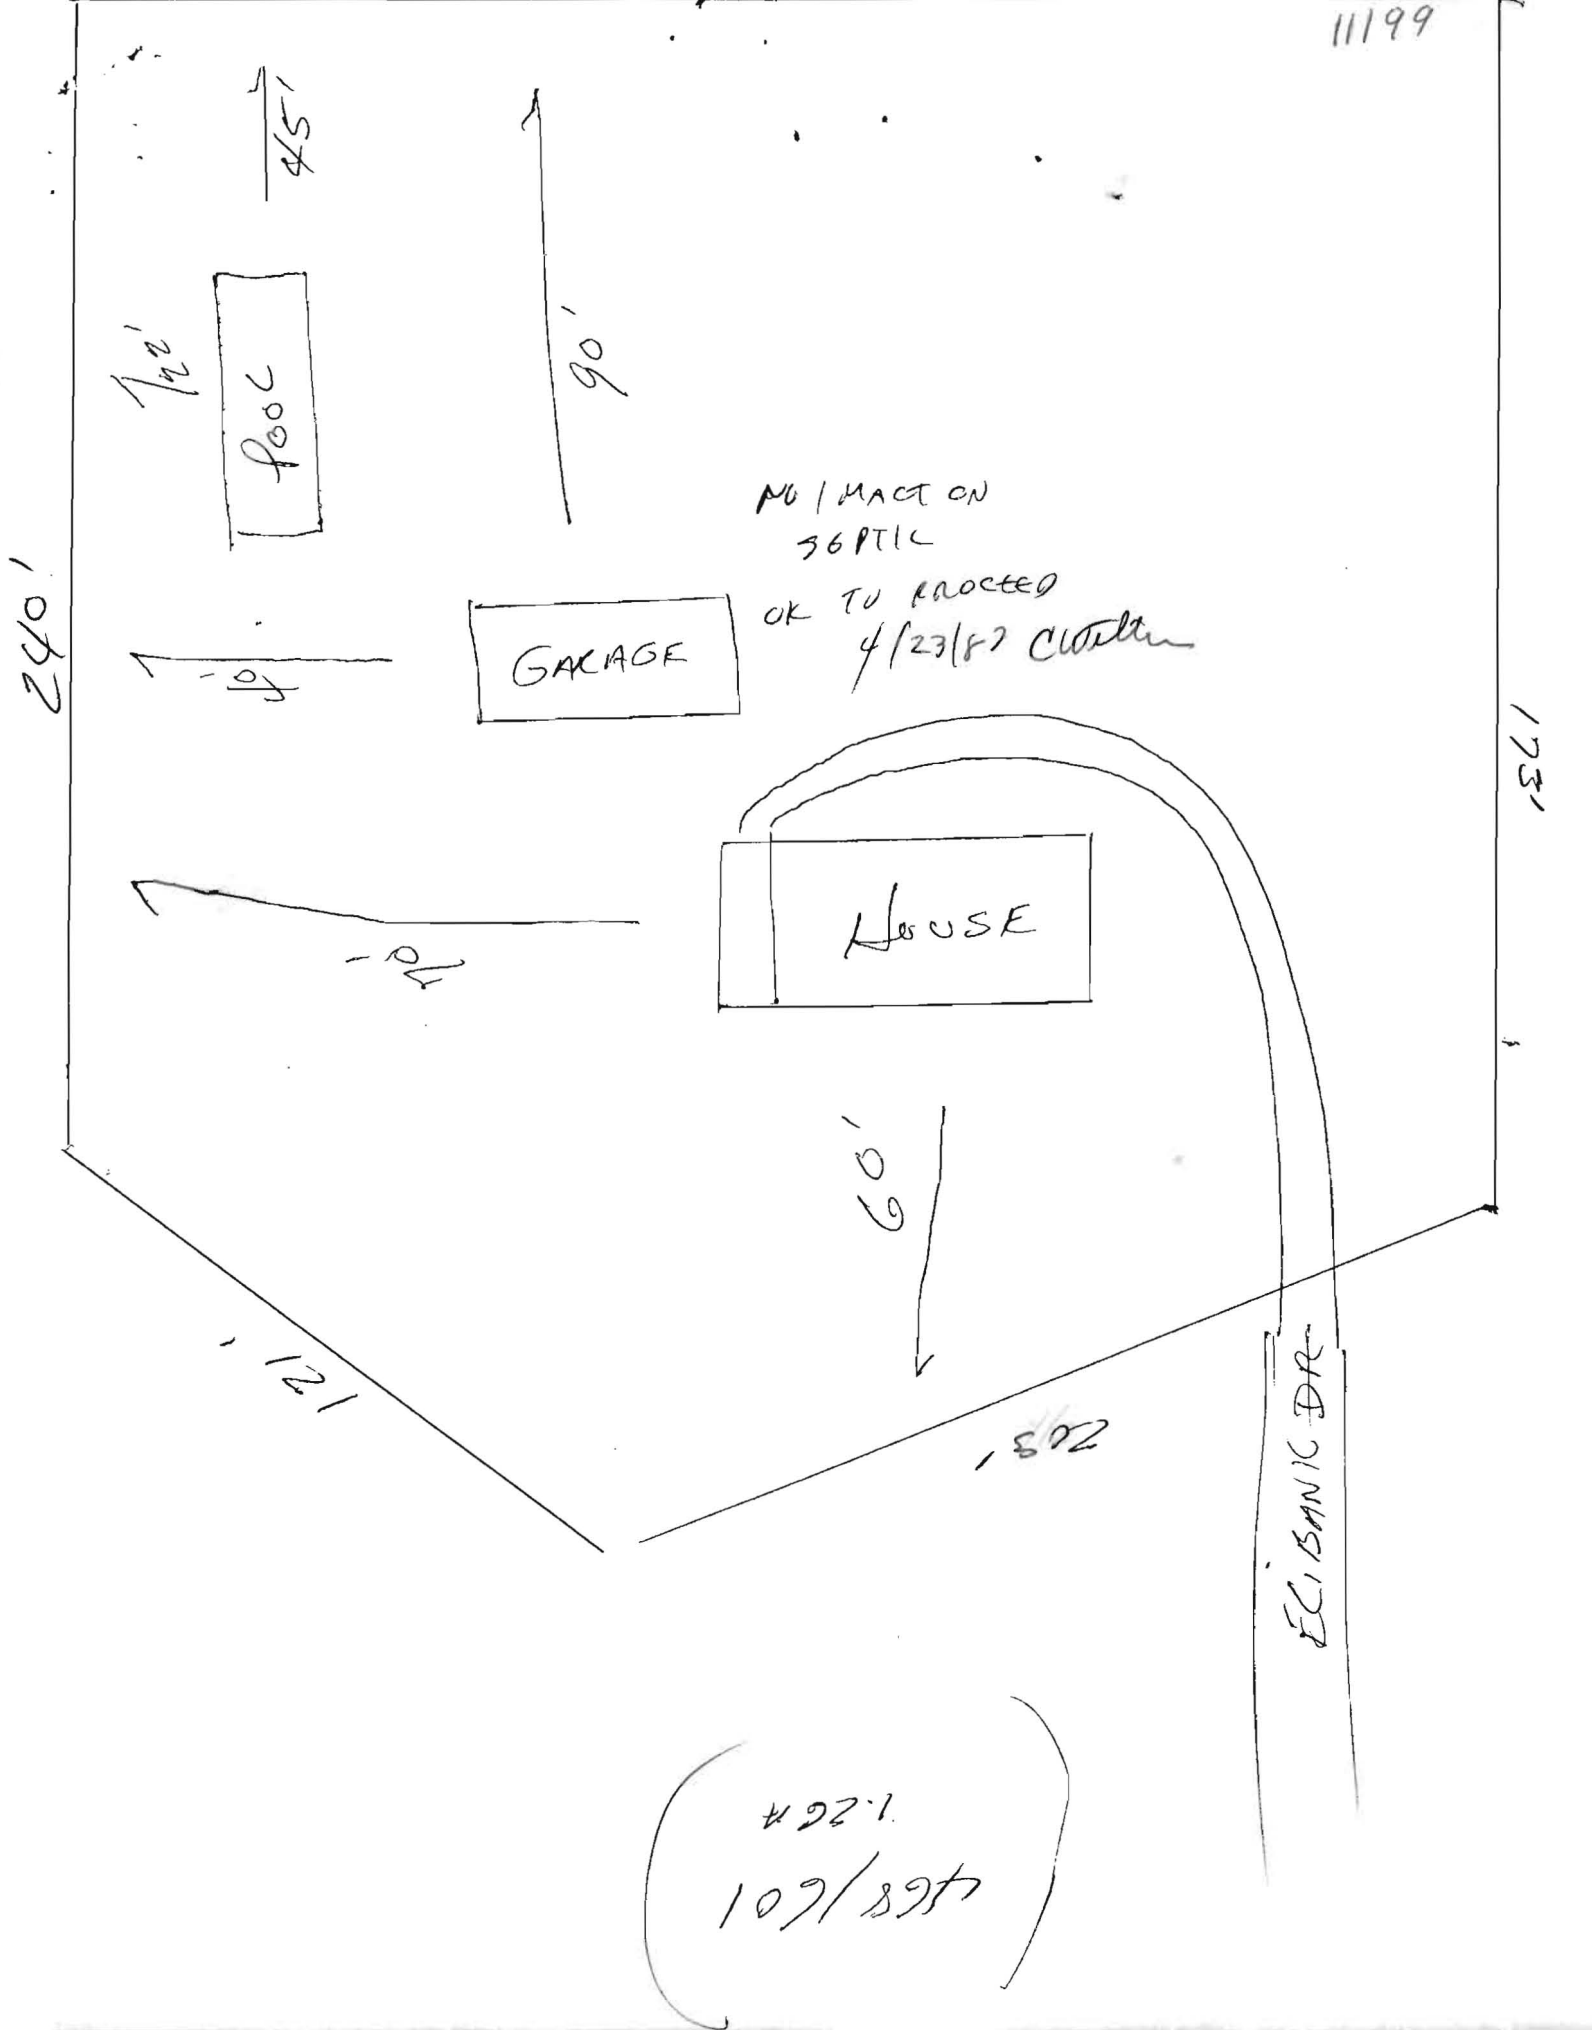

NO / MACT ON SEPTIC

OK TO PROCEED 4/23/87 C. Miller

GARAGE

HOUSE

POOL

ECIBANIC DR

1.26A  
109/897

240'

173'

121'

208'

60'

90'

15'

121'

121'

121'

121'

37  
500

1 inch = 40 feet

Details from Tax Map No 32

Parcel 104

Parcel 105  
(Howard County Pump Station)

Parcel 85

Parcel 96 Western Section

START DIV  
HEAD  
RD

200'

240'

LIBER 669 6426 ECHIBANK DR.

Folio 324

