

12/13/84  
12/14/84  
12/17/84  
11:30  
12-18-84  
10:00  
12-18-84  
10:00  
12-18-84  
10:00

approved  
12-18-84 SA  
P 39593

# PERMIT

SEWAGE DISPOSAL SYSTEM

MARYLAND STATE DEPARTMENT OF HEALTH\*

HOWARD COUNTY  
BUREAU OF ENVIRONMENTAL HEALTH  
992-2330

ELLICOTT CITY  
DISTRICT 1st.  
DATE 11/19/84

INDEXED

Clinton Routh IS PERMITTED TO INSTALL X ALTER  
ADDRESS 6462 Elibank Drive PHONE 687-1000

SUBDIVISION \_\_\_\_\_ ROAD 6426 Elibank Drive LOT Parcel 96

PROPERTY OWNER Clinton Routh

ADDRESS \_\_\_\_\_

IF GARBAGE GRINDER IS USED INCREASE SEPTIC TANK CAPACITY BY 50% AND ABSORPTION AREA BY 22%.

GARBAGE GRINDER? YES \_\_\_\_\_ NO X

SEPTIC TANK CAPACITY 1000 GALLONS NUMBER OF BEDROOMS 3

TRENCHES - 158 sq. ft. per bedroom. Trench to be 2 feet wide. Inlet 3 feet below original grade. Bottom maximum depth 7 feet below original grade. Effective area begins at 3 feet below original grade. 4 feet of stone below distribution pipe. LOCATION: Start the first trench 130 feet from the back (200') lot line and 80' from the right (173.55') lot line. Run trench(s) along level ground toward front of lot. NOTE: No trench to exceed 100 feet in length. If more than one trench used, a distribution box is required. Call for inspection of trench(s) before and after gravel is installed. Provide 6" - 8" diameter cleanout and cap to grade or a above on septic tank.

BLDG. PERMIT SIGNED  
AND RETURNED 9/5/2001  
B00131605 ADD BEDROOM,  
BATH, DEN & REC ROOM

PLANS APPROVED BY Craig Williams DATE 11/19/84

COVER NO WORK UNTIL INSPECTED AND APPROVED.

NEITHER THE HOWARD COUNTY COUNCIL NOR THE HEALTH DEPARTMENT IS RESPONSIBLE FOR THE SUCCESSFUL OPERATION OF ANY SYSTEM.

NOTE: IF TRENCH IS USED CALL FOR INSPECTION BEFORE AND AFTER PLACING GRAVEL IN TRENCH.

NOTE: NO DRY WELL SHALL EXCEED 15 FOOT IN DIAMETER. NO ABSORPTION TRENCH TO EXCEED 100 FEET IN LENGTH.

NOTE: ALL PIPE FROM HOUSE TO SEPTIC TANK MUST BE CAST IRON OR SCHEDULE 40 PVC OR ABS.

PERMIT VOID AFTER THREE YEARS.


NOTE: INSTALL STAND PIPE ON SEPTIC TANK AND DRY WELL. STAND PIPES MUST BE 6 INCHES IN DIAMETER CAST IRON, CONCRETE OR TERRA COTTA, OR PVC OR ABS ACCEPTED. IF TOP OF SEPTIC TANK IS DEEPER THAN 3 FEET MANHOLE TO GRADE REQUIRED

BLDG. PERMIT SIGNED  
AND RETURNED 4/23/87  
Permit # 11199

A 33999

\*INSTALLER IS RESPONSIBLE FOR OBTAINING FINAL APPROVAL ON THIS PERMIT

\*CALL 992-2330 FOR INSPECTION OF SEPTIC SYSTEMS.

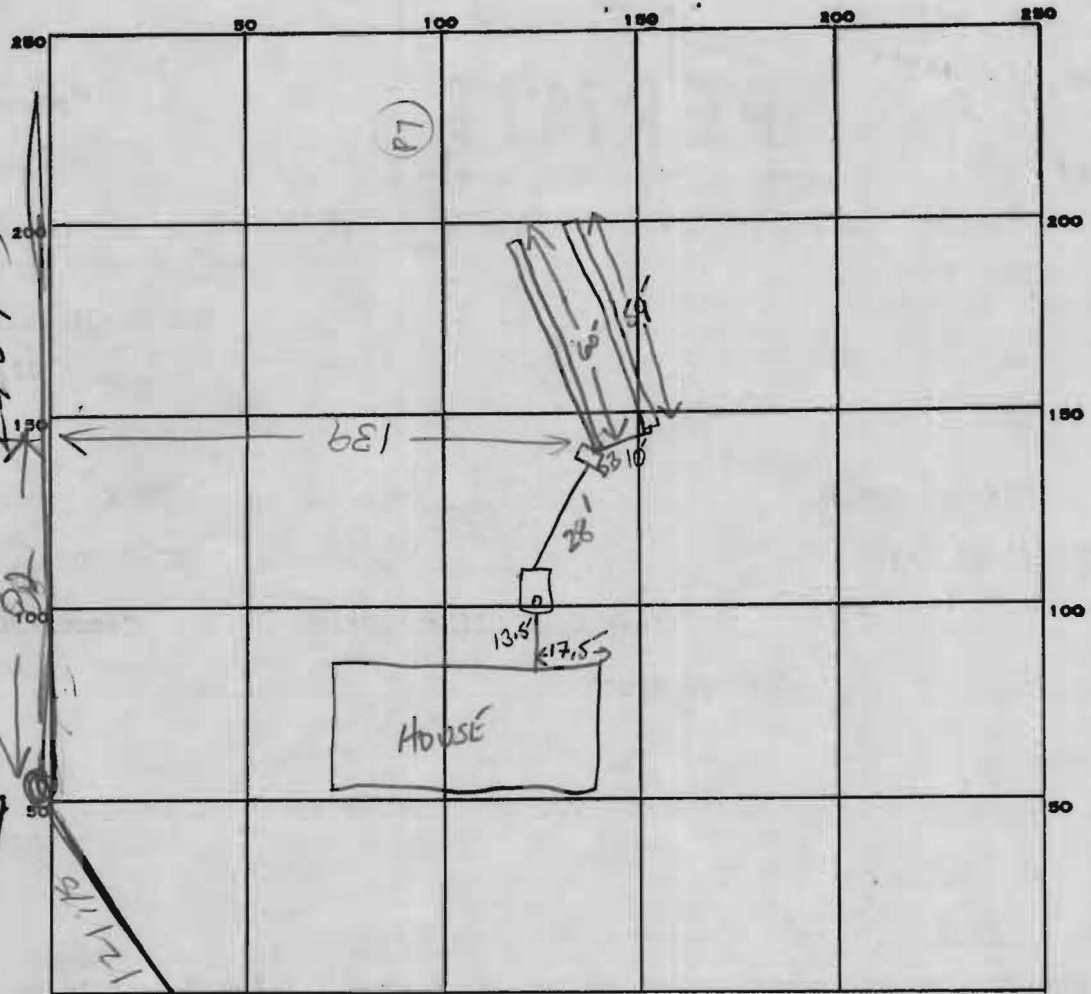

INDICATE NORTH. - NAME ADJOINING ROADWAY AS BASE LINE.

ELIBANK DR

PERMIT CARD

SEPTIC TANK, LEVEL

CLEANOUTS ST

DISTRIBUTION BOX, LEVEL

TRENCH #2 7 FT. TRENCH WIDTH #1 2 FT. #2 2 FT.

TILE FIELD, DEPTH #2 7 FT. TOTAL LENGTH #1 TRENCH (60) FT. #2 TRENCH (59) FT.

GRAVEL DEPTH #1 4 FT. TOTAL LENGTH #2 TRENCH (59) FT. TOTAL 119 FT.

NUMBER OF TRENCHES #2 (60) (2) one side wall TOTAL BOTTOM AREA

SEEPAGE PITS, INSIDE DIAMETER \_\_\_\_\_ FT. DEPTH BELOW INLET \_\_\_\_\_ FT.

ABSORBENT AREA \_\_\_\_\_ SQ. FT.

REMARKS 12/14/84 - OK to cover trench #1, start trench #2 + call for inspection. S. Abel & R.H.

12/17/84 - OK to place down in trench #2, SA

12/18/84 - DB = block, cement around pipes leaving DB; OK to cover all work SA

DATE SYSTEM APPROVED 12/18/84

INSPECTOR S. Abel