

Fill out in triplicate.  
Make \$25.00 check payable:  
Howard County Health Dept. - Sanitation

# APPLICATION

A 22909

*Preliminary*

*4-13' Lateral  
on 10,000 ft.*

SEWAGE DISPOSAL TESTING

P \_\_\_\_\_

STATE OF MARYLAND - DEPARTMENT OF HEALTH AND MENTAL HYGIENE

HOWARD COUNTY HEALTH DEPARTMENT  
ENVIRONMENTAL HEALTH SERVICES  
P. O. BOX 476, ELLICOTT CITY, MARYLAND 21043  
TELEPHONE: 465-5000, EXT. 356

DISTRICT ✓ 3RD

DATE ✓ 2/25/76

*3/19/76  
9:30*

TO: THE COUNTY HEALTH OFFICER  
ELLICOTT CITY, MARYLAND

I, HEREBY, APPLY FOR THE NECESSARY TEST IN ORDER TO CONSTRUCT (OR RECONSTRUCT) A SEWAGE DISPOSAL SYSTEM.

PROPERTY OWNER ✓ G.R. KNAPP

ADDRESS ✓ 8816 BESTHOLD GARTH COLUMBIA 21045 PHONE ✓ 997-2656

PROPERTY LOCATION:

SUBDIVISION ✓ BEHIND GREENHEDGE LOT NO. ✓ BEHIND LOT 29

ROAD AND DESCRIPTION directions END OF EVERGREEN CT.; OFF OF EVERGREEN WAY WHICH IS ABOUT 1 MILE S. OF RT 144 ON TRIADELPHIA RD.

SIZE OF LOT ✓ ~5.25 A (including pipe stem) TYPE BLDG. ✓ SINGLE FAMILY 4 BDRM  
NUMBER OF BEDROOMS

IF NOT SINGLE RESIDENCE DESCRIBE \_\_\_\_\_

THE SYSTEM INSTALLED UNDER THIS APPLICATION IS ACCEPTABLE ONLY UNTIL PUBLIC FACILITIES BECOME AVAILABLE.

SIGNATURE OR APPLICANT [Signature]

APPROVED BY \_\_\_\_\_ FOR \_\_\_\_\_ DATE \_\_\_\_\_  
(KIND OF SYSTEM)

REJECTED BY \_\_\_\_\_ FOR \_\_\_\_\_ DATE \_\_\_\_\_  
(KIND OF SYSTEM)

HOLD PENDING FURTHER TESTS \_\_\_\_\_ DATE \_\_\_\_\_

REASONS FOR REJECTION OR HOLDING 3/22/76 Failed perc but in area tested F.S.

# THIS IS NOT A PERMIT

# APPLICATION

A 22909

## SEWAGE DISPOSAL TESTING

P \_\_\_\_\_

STATE OF MARYLAND - DEPARTMENT OF HEALTH AND MENTAL HYGIENE

HOWARD COUNTY HEALTH DEPARTMENT  
ENVIRONMENTAL HEALTH SERVICES

DISTRICT 3 RD

P. O. BOX 476, ELLICOTT CITY, MARYLAND 21043  
TELEPHONE: 465-5000, EXT. 356

DATE 2/25/76

TO: THE COUNTY HEALTH OFFICER  
ELLICOTT CITY, MARYLAND

I, HEREBY, APPLY FOR THE NECESSARY TEST IN ORDER TO CONSTRUCT (OR RECONSTRUCT) A SEWAGE DISPOSAL SYSTEM.

PROPERTY OWNER G. R. KNAPP

ADDRESS 8816 BESTHOLD GARTH COLUMBIA PHONE 997-2656  
(953-7100 X 7239; BUS.)

PROPERTY LOCATION:

SUBDIVISION BEHIND GREENHEDGE LOT NO. BEHIND LOT 29

ROAD AND DESCRIPTION END OF EVERGREEN CT; OFF OF EVERGREEN WAY  
WHICH IS ABOUT 1 MILE S. OF RT 144 ON TRIADELPHIA RD

SIZE OF LOT 5.25 A TYPE BLDG. SINGLE FAMILY 4 BRM  
NUMBER OF BEDROOMS

IF NOT SINGLE RESIDENCE DESCRIBE \_\_\_\_\_

THE SYSTEM INSTALLED UNDER THIS APPLICATION IS ACCEPTABLE ONLY UNTIL PUBLIC FACILITIES BECOME AVAILABLE.

SIGNATURE OR APPLICANT [Signature]


APPROVED BY \_\_\_\_\_ FOR \_\_\_\_\_ DATE \_\_\_\_\_  
(KIND OF SYSTEM)

REJECTED BY \_\_\_\_\_ FOR \_\_\_\_\_ DATE \_\_\_\_\_  
(KIND OF SYSTEM)

HOLD PENDING FURTHER TESTS \_\_\_\_\_ DATE \_\_\_\_\_

REASONS FOR REJECTION OR HOLDING \_\_\_\_\_

# THIS IS NOT A PERMIT

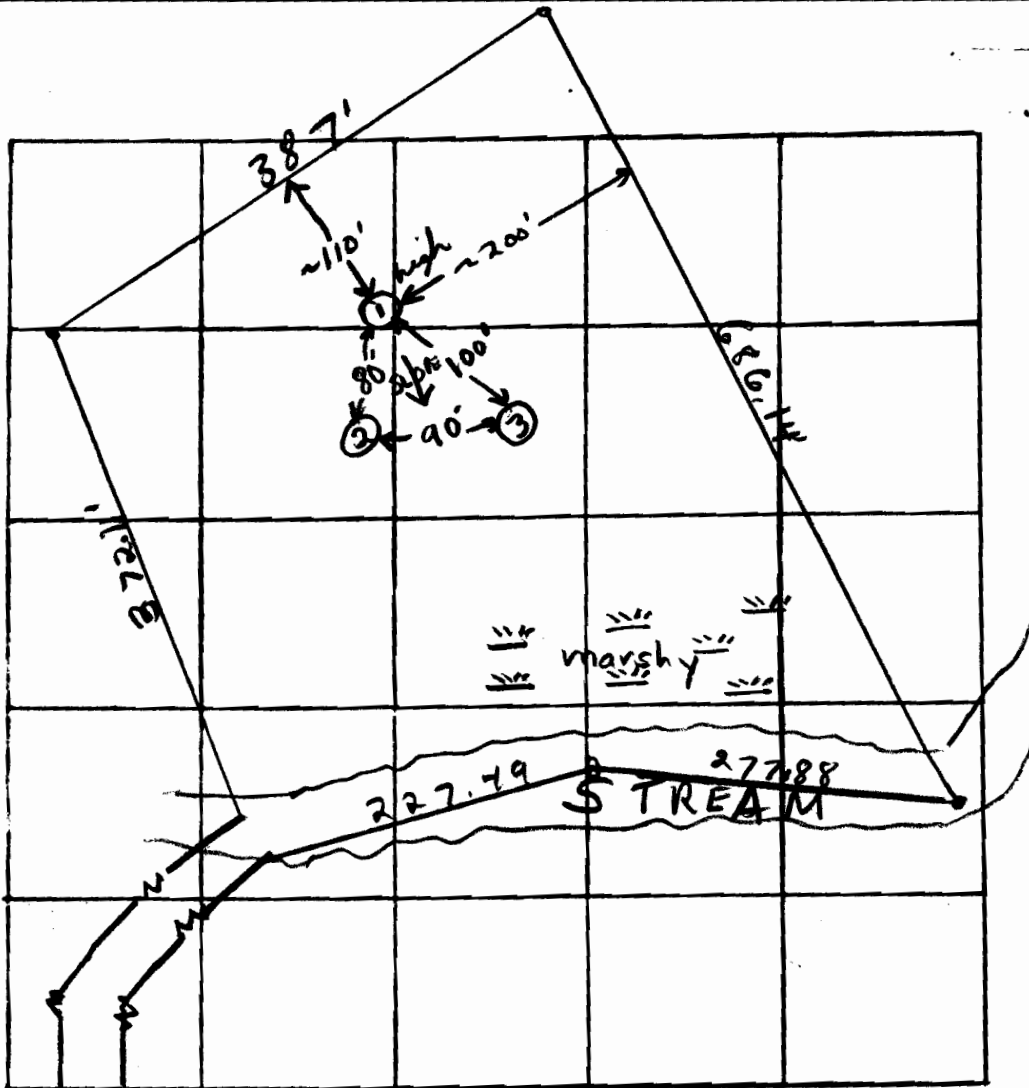

INDICATE NORTH - NAME ADJOINING ROADWAY AS BASE LINE.

Evergreen Way

DATE	TEST NO.	DEPTH	PRE-WET		TEST - 1" DROP		TIME
			START	STOP	START	STOP	
3/19/70	1 high	12'	Water at 12'	clayey to 3'	silty loam below		
	2	6'	Water at 6'				
	3	10'	Water at 10'				

REMARKS

TYPE OF SOIL silty-sandy loam below top - "clayey soil"

TESTED BY F.S.

ALSO PRESENT: Mr. Knapp

March 22, 1976

Mr. G. R. Knapp  
8816 Besthold Garth  
Columbia, Maryland 21045


Dear Mr. Knapp:

This is to advise that the percolation test run on your property located at the end of Evergreen Court on March 19, 1976 failed the percolation tests in the area tested.


Very truly yours,

Frank Skinner,  
Sanitarian

FS:hs

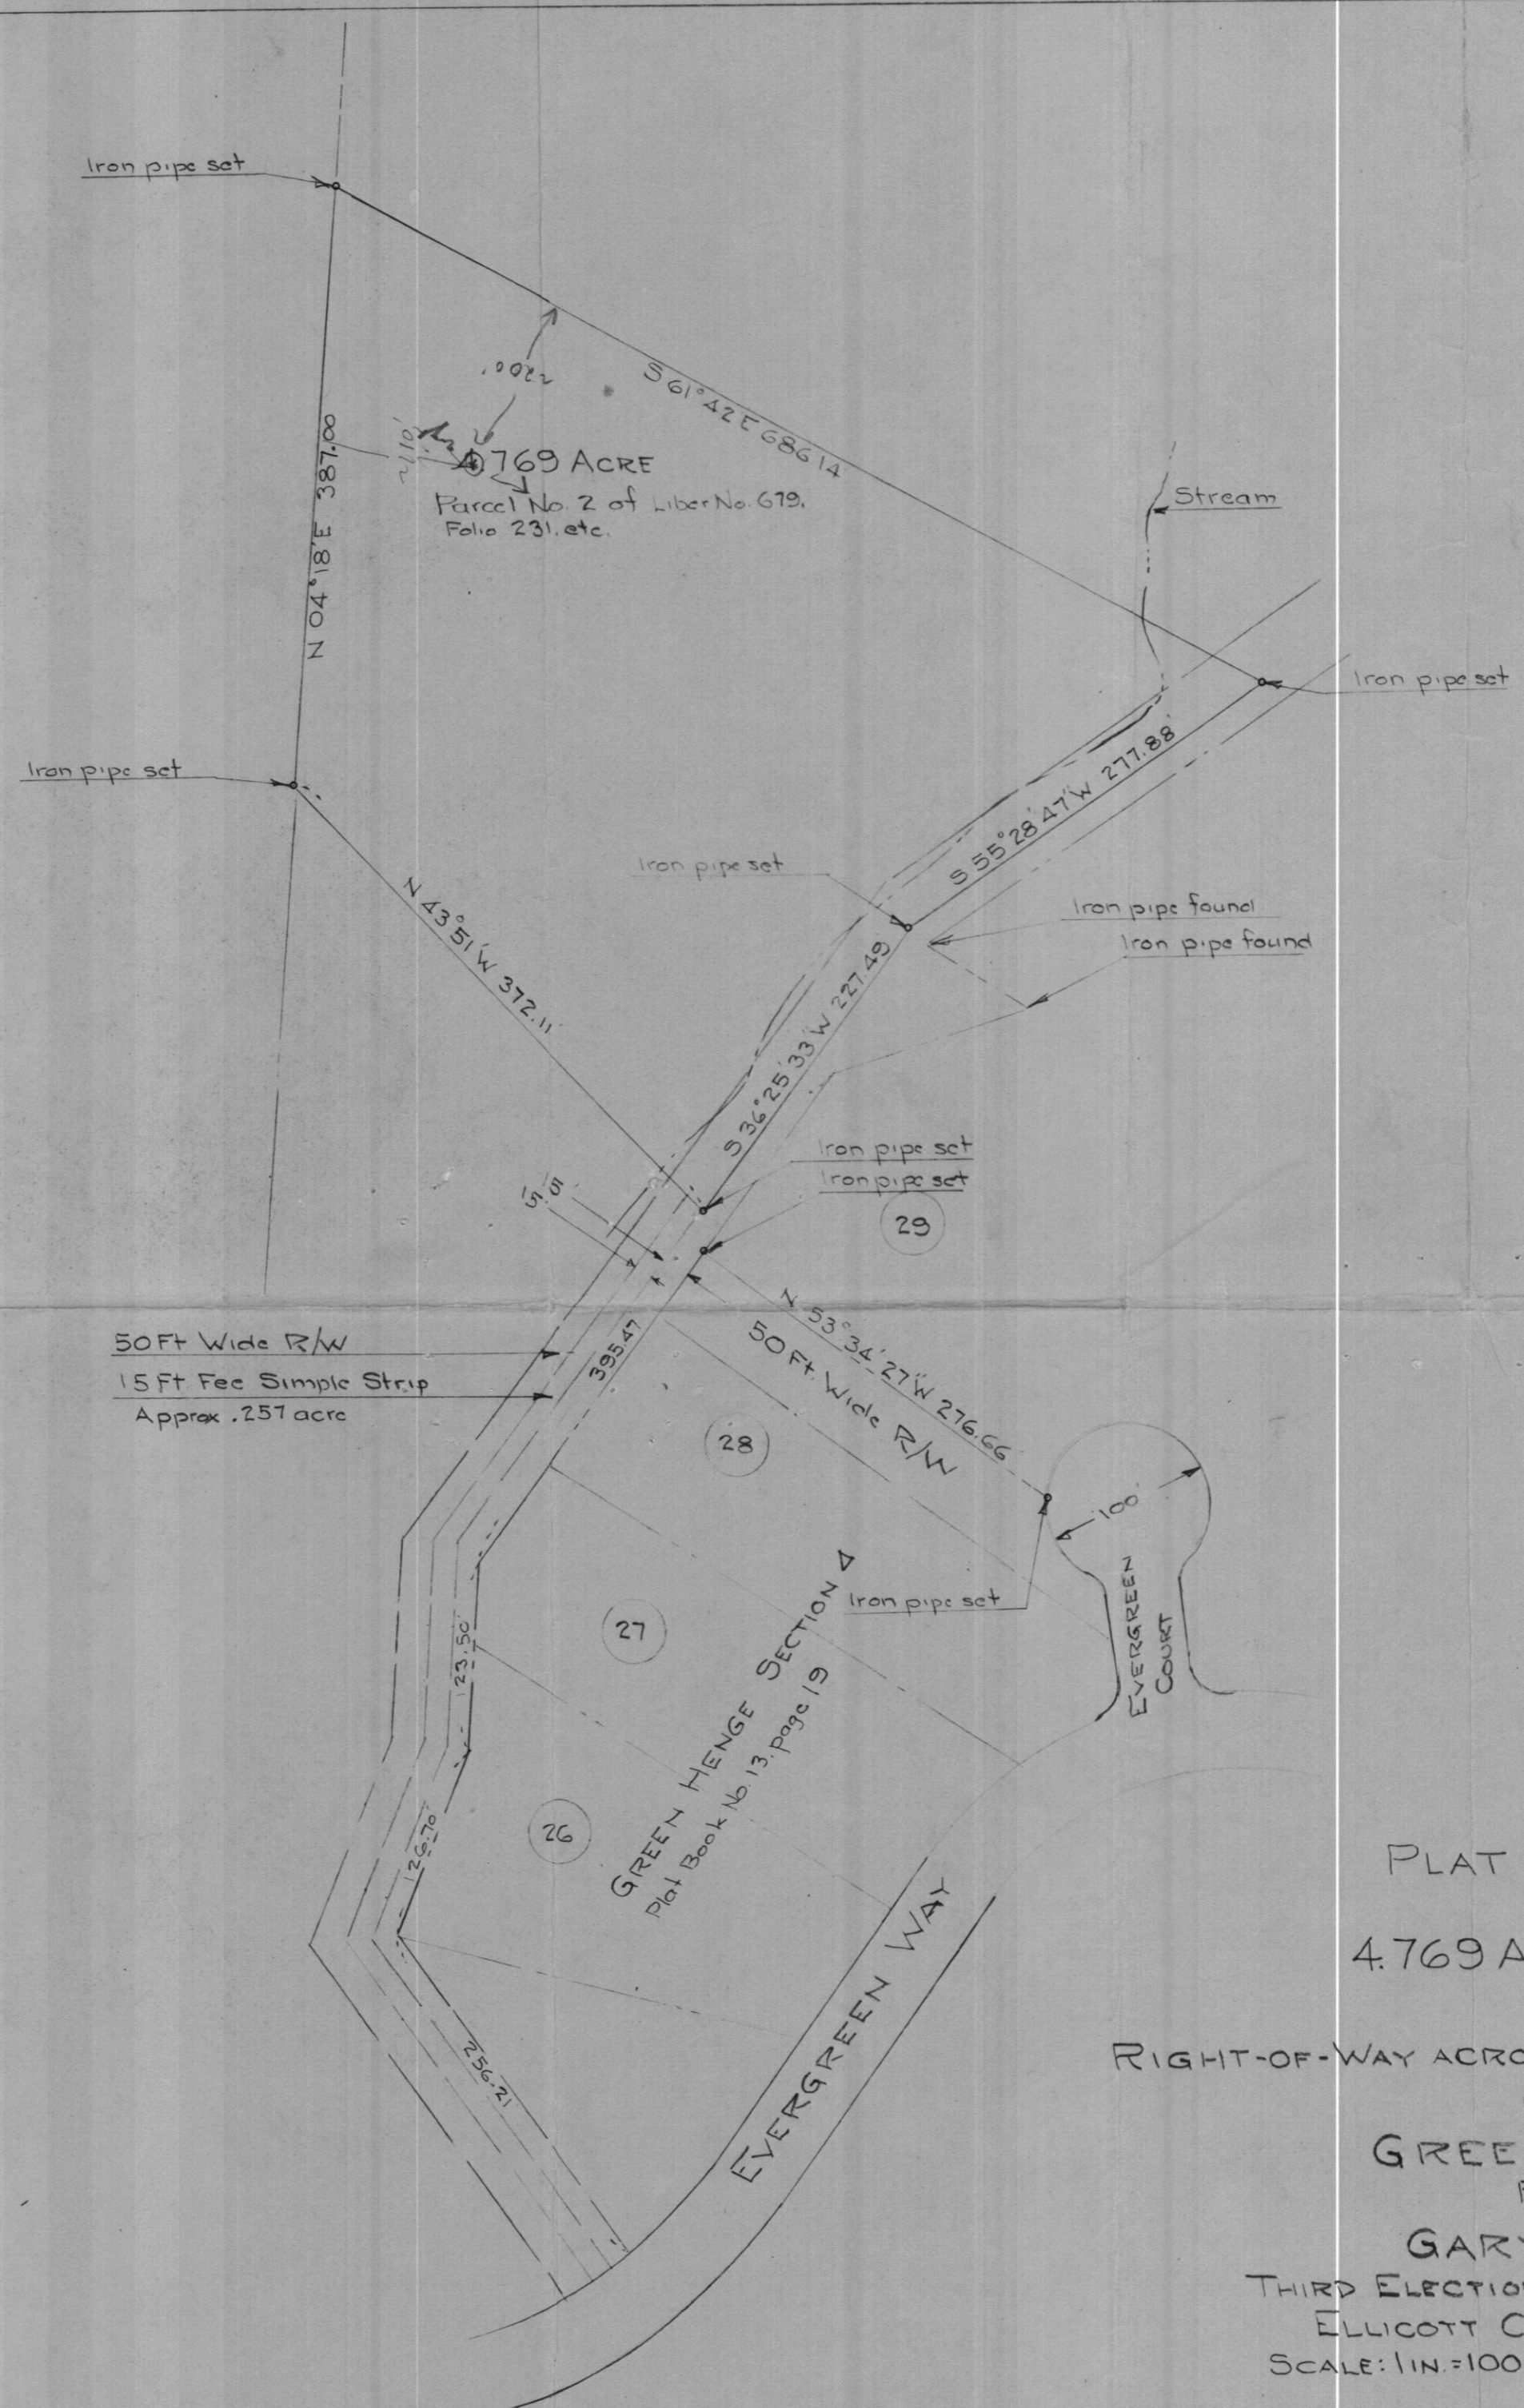

PLAT OF SURVEY  
A  
4.769 ACRE TRACT  
E  
RIGHT-OF-WAY ACROSS LOT No. 28 SECTION 4  
OF  
GREEN HENGE  
FOR  
GARY KNAPP  
THIRD ELECTION DIST. HOWARD Co.  
ELLCOTT CITY, MARYLAND.  
SCALE: 1 IN. = 100 FT    FEBRUARY 23, 1976

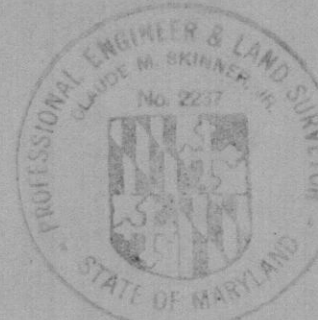

David M. Stein  
C. A. 280