

APPLICATION

A 11442

SEWAGE DISPOSAL TESTING

P _____

MARYLAND STATE DEPARTMENT OF HEALTH

HOWARD COUNTY

ELLICOTT CITY

3 bedrooms - Septic Tank 750 gallons

DISTRICT 3

2 dry wells - 150 sq. ft. each absorbent & dwell area below
main vent pipe at least 40 ft. apart, measured edge to edge. First dry well to be located 160 ft. from front lot line and 70 ft. from right side lot line as seen when facing lot from Congress way.

DATE 1/20/66

Depth of dry well to be no greater than 9 ft. below original grade.

4 bedrooms - Septic Tank 1000 gallons

2 dry wells - 200 sq. ft. each absorbent sidewalk area below the inlet pipe at least 40 ft. apart, measured edge to edge, located same as above.

TO: THE COUNTY HEALTH OFFICER

ELLICOTT CITY, MARYLAND

Depth of dry wells no greater than 9 ft. below original grade.

I, HEREBY, APPLY FOR THE NECESSARY TESTS IN ORDER TO CONSTRUCT OR RECONSTRUCT A SEWAGE DISPOSAL SYSTEM.

PROPERTY OWNER Catell, Inc.

ADDRESS Cathar Rd., Ellicott City, Md. PHONE HQ 5-2677

PROPERTY LOCATION:

SUBDIVISION Green Hedges LOT NO. 34, Sec. 3

ROAD AND DESCRIPTION Evergreen Way

OCCUPANT _____ PHONE _____

PERSON TO CONSTRUCT SYSTEM _____

ADDRESS _____ PHONE _____

SIZE OF LOT 115' x 284' x 170' x 266' TYPE BLDG. 3 or 4
NUMBER OF BEDROOMS

IF NOT SINGLE RESIDENCE DESCRIBE _____

SIGNATURE OF APPLICANT /s/ Carl C. Hall, President


APPROVED BY J. H. Kalms FOR 2 dry wells DATE 3/24/67
(KIND OF SYSTEM)

REJECTED BY _____ FOR _____ DATE _____
(KIND OF SYSTEM)

HOLD PENDING FURTHER TESTS _____ DATE _____

REASONS FOR REJECTION OR HOLDING _____

THIS IS NOT A PERMIT

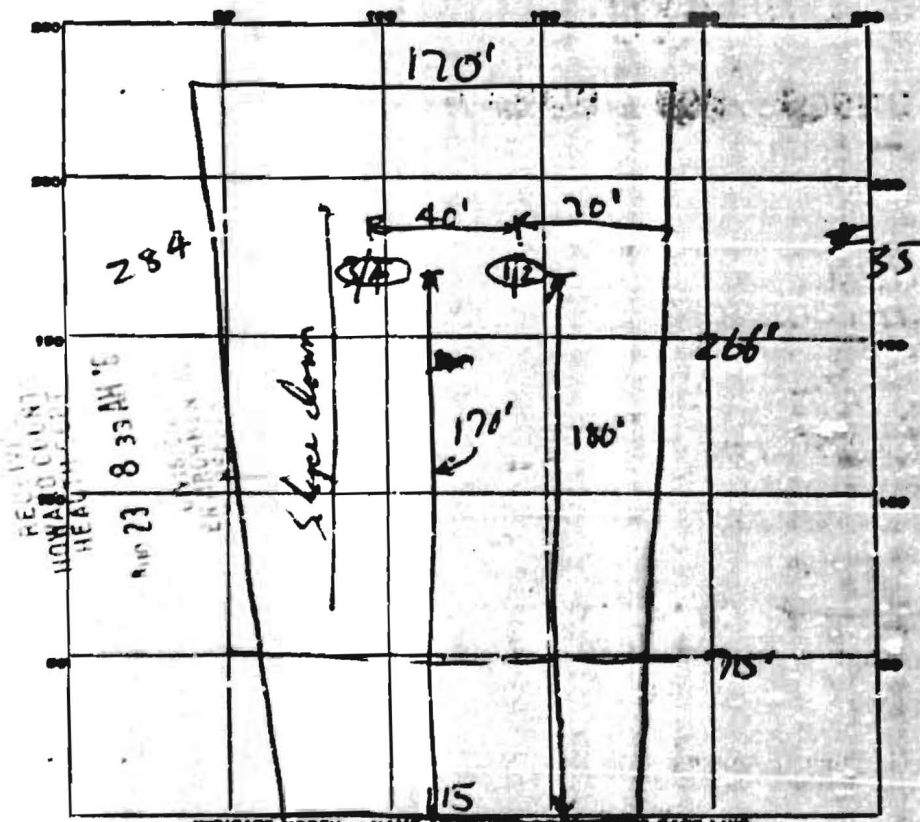

European Way

DATE	TEST NO.	DEPTH	PRE-WET		TEST - 1" DROP		TIME
			START	STOP	START	STOP	
12/1/66	1	4 ft.	2:36	2:37	2:37	2:38	1 min.
	2	8 ft.	2:37	2:38	2:38	2:40	2 min.
	3	4 1/2 ft.	2:45	2:45	→	2:46	30 sec. 4/4.5
	4	9 ft.	2:45	2:46	2:46	2:47	1 min. 1.1

SOIL AUGER FINDING: Must dig one hole to 13' on slope R.F. #34
 TESTED BY: JRE 12/1/66
 REMARKS: