

8/23/68
after 1st
permit

PERMIT

SEWAGE DISPOSAL SYSTEM

MARYLAND STATE DEPARTMENT OF HEALTH

HOWARD COUNTY

ELLICOTT CITY

INDEXED

DISTRICT 3

DATE 8/19/68

P 15048
A 11442

Malnor General Contractors

IS PERMITTED TO INSTALL ALTER

ADDRESS Box 140 Ridge Rd., E.F.D. 3, Balto., Md. 21207 PHONE 922-1090

A SEWAGE DISPOSAL SYSTEM LOCATED AT _____

SUBDIVISION Green House ROAD Evergreen Way LOT 34, Sec. 3

PROPERTY OWNER Garvell, Inc.

ADDRESS Shethon Rd., Ellicott City, Md.

SPECIFICATIONS

DRAIN FIELD _____ DEPTH _____ FEET, BOTTOM AREA _____ SQ. FT.

SEEPAGE FITS _____ ABSORBENT SIDE-WALL AREA _____ SQ. FT.

SEPTIC TANK CAPACITY 750 GALLONS

FOR GARBAGE GRINDER, INCREASE DISPOSAL AREA 25% & TANK CAPACITY 50%.

OTHER Septic Tank - 750 gal. 2 dry wells - 150 sq. ft. each absorbent sidewall area below the inlet pipe at least 40 ft. apart measured edge to edge. First dry well to be located 180 ft. from front lot line and 70 ft. from right side lot line as seen when facing lot from Evergreen Way. Depth of dry well to be no greater than 8 ft. below original grade.


PLANS APPROVED BY J. H. Kilmore DATE 3/26/67

FILL SEPTIC TANK AND DISTRIBUTION BOX WITH WATER BEFORE CALLING FOR AN INSPECTION. COVER NO WORK UNTIL INSPECTED AND APPROVED.

NEITHER THE HOWARD COUNTY COMMISSIONERS NOR THE HEALTH DEPARTMENT IS RESPONSIBLE FOR THE SUCCESSFUL OPERATION OF ANY SYSTEM.

NOTIFY THE HEALTH DEPARTMENT 48 HOURS BEFORE EXCAVATIONS ARE TO BE BACK FILLED.

A 11442

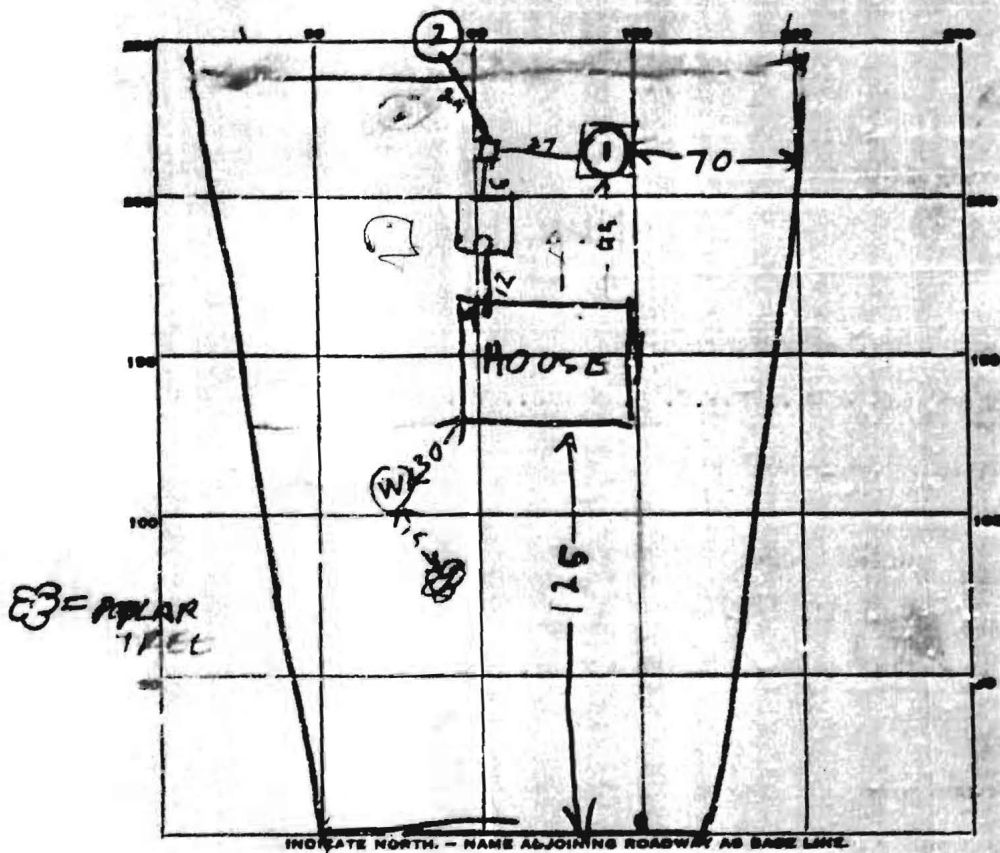

PERMIT CARD NO

SEPTIC TANK, LEVEL OK consider 1000 CLEANOUTS OK
 Top is 7 FT below grade
 DISTRIBUTION BOX, LEVEL OK

TILE FIELD, DEPTH _____ FT. TRENCH WIDTH _____ FT.

GRAVEL DEPTH _____ IN. TOTAL LENGTH _____ FT.

NUMBER OF TRENCHES _____ TOTAL BOTTOM AREA _____

SEEPAGE FITS, INSIDE D:AMETER _____ FT. DEPTH BELOW INLET _____ FT.

TOTAL ABSORBENT AREA 213 not counting stone
589 sq. ft. counting stone

REMARKS 23 AUG 68. 3 BEDROOM HOUSE

300 sqft sidewalk around Dry Well #1 Top is 21 ft below grade

11 ft sidewalk 11 ft diameter of hole is 36 ft 175 sqft not

counting stone 24 sqft counting stone Dry Well #2 Top is 10 FT

Depth below inlet 8 FT diameter is 36 ft below grade Perimeter 42 FT

249 sqft not counting stone 336 sqft counting stone

DATE SYSTEM APPROVED 23 AUG 68 INSPECTOR Raymond Hodges