

PRELIMINARY

APPLICATION

SEWAGE DISPOSAL TESTING


STATE OF MARYLAND - DEPARTMENT OF HEALTH AND MENTAL HYGIENE

HOWARD COUNTY HEALTH DEPARTMENT
ENVIRONMENTAL HEALTH SERVICES

P. O. BOX 476, ELLICOTT CITY, MARYLAND 21043
TELEPHONE: 486-8000, EXT. 388

DISTRICT 8th

DATE 3/9/73

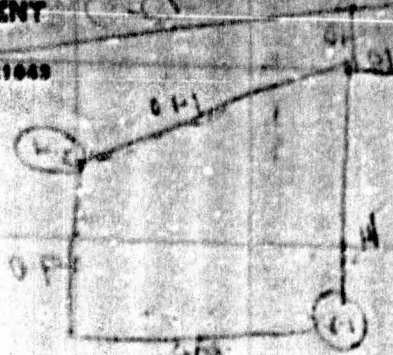

TO: THE COUNTY HEALTH OFFICER
ELLICOTT CITY, MARYLAND

I, HEREBY, APPLY FOR THE NECESSARY TEST IN ORDER TO CONSTRUCT (OR RECONSTRUCT) A SEWAGE DISPOSAL SYSTEM.

PROPERTY OWNER William L. Evans

ADDRESS Route 108, Clarksville, Md. PHONE 286-2638

PROPERTY LOCATION:

SUBDIVISION _____ LOT NO. 2

ROAD AND DESCRIPTION St. Michael's Road

SIZE OF LOT 40,500 sq. ft. TYPE BLDG. 3 or 4 bedrooms
NUMBER OF BEDROOMS

IF NOT SINGLE RESIDENCE DESCRIBE _____

THE SYSTEM INSTALLED UNDER THIS APPLICATION IS ACCEPTABLE ONLY UNTIL PUBLIC FACILITIES BECOME AVAILABLE.

SIGNATURE OF APPLICANT W/ William L. Evans

APPROVED BY _____ FOR _____ DATE _____

(KIND OF SYSTEM)


REJECTED BY _____ FOR _____ DATE _____

(KIND OF SYSTEM)

HOLD PENDING FURTHER TESTS _____ DATE _____

REASONS FOR REJECTION OR HOLDING _____

THIS IS NOT A DEPOSIT

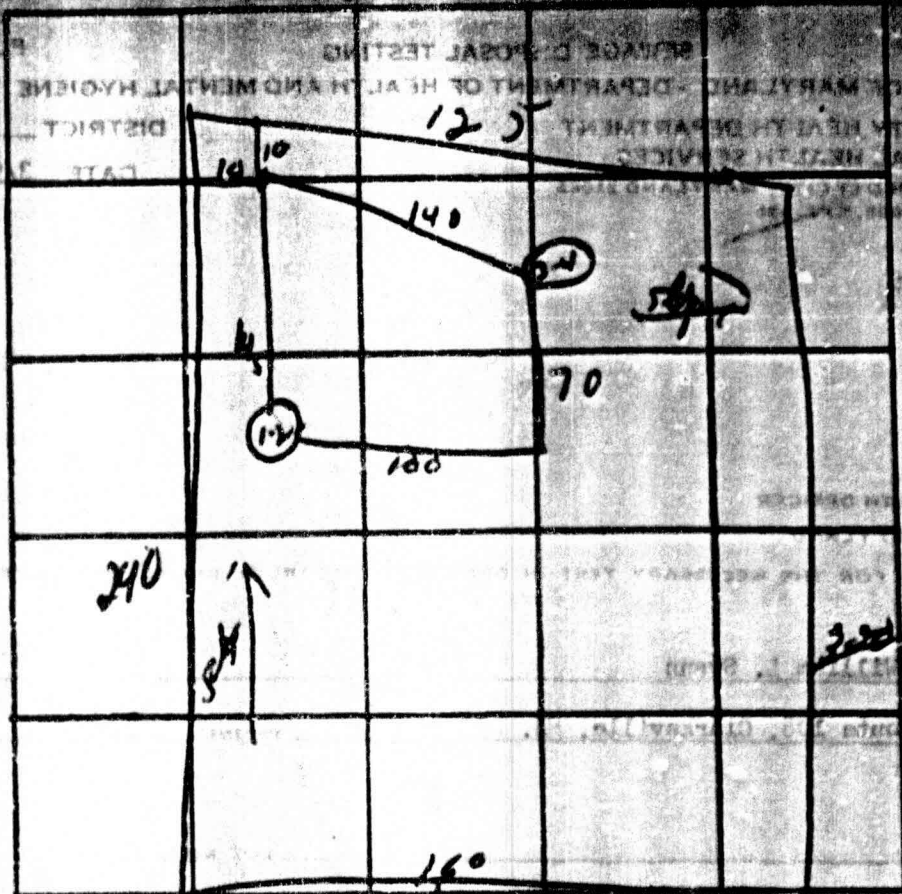

INDICATE NORTH - NAME ADJOINING ROADWAY AS BASE LINE

Fluorine test

DATE	TEST NO.	DEPTH	PRE-WET		TEST - 1" DROP		TIME
			START	STOP	START	STOP	
3/27/77	1	4 1/2 ft	10 25	10 28	10 34	10 52	18 min
	2	12 ft	10 26	10 32	10 33	10 50	17 min
	3	3 1/2 ft	10 23	10 22	10 22	10 43	9 min
	4	12 ft	10 20	10 24	10 24	10 42	15 min
	5	9 ft - shale					
	6	5					

REMARKS


TYPE OF SOIL

shale

APPROVED WITH HOWARD COUNTY AND DEPARTMENT OF PUBLIC WORKS FOR WIDENING OF ST. MICHAEL'S ROAD


WILLIAM L SWANN

118059

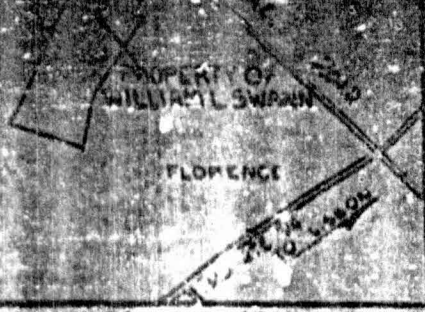

SCALE 1" = 1200'

ST. MICHAEL'S ROAD
525°36'50" E 23.80'
WILLIAM L SWANN II DATE
PARCEL NO 4575

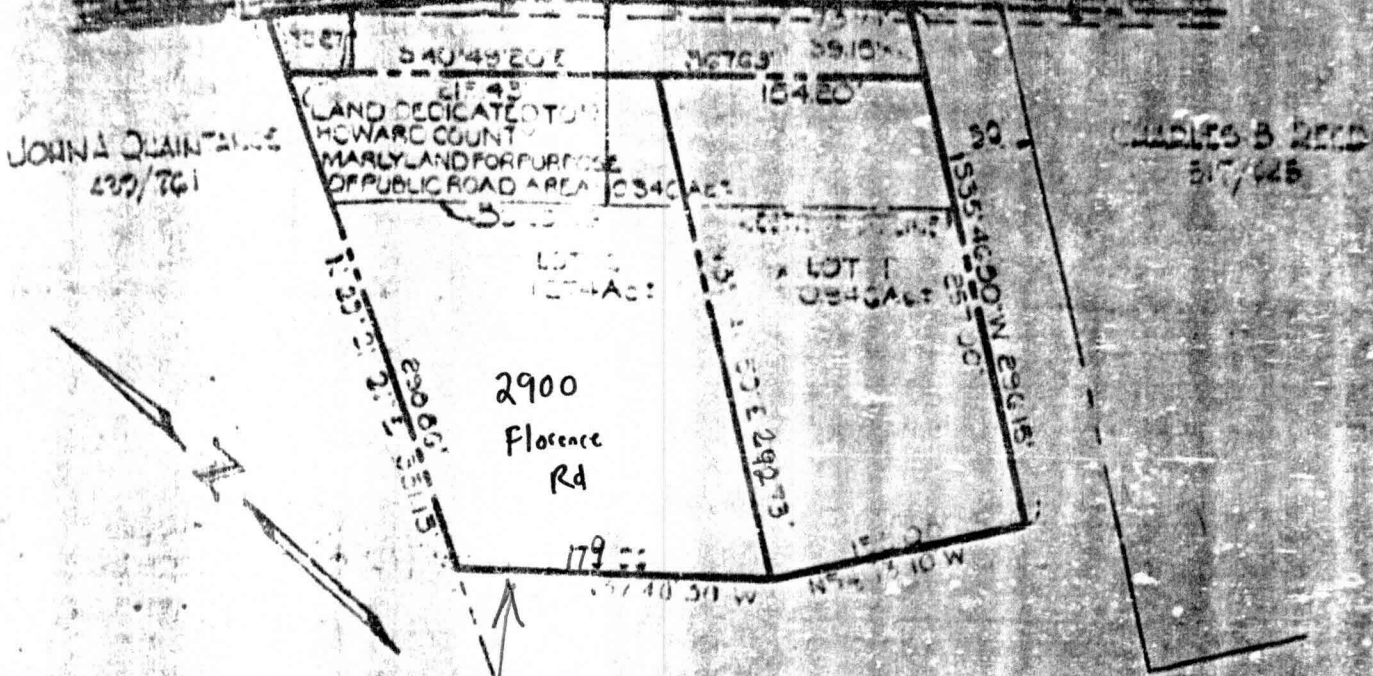


WILLIAM L SWANN
567/510

- NOTE
1. TOTAL AREA OF TRACT - 2.5662
 2. NUMBER OF LOTS - 2
 3. TOTAL AREA WITHIN TRACT - 2.2204
 4. ZONED - R40
 5. PROPERTY LOCATED ON TAX MAP 13 PARCEL 175


APPROVED FOR PRIVATE WATER & PRIVATE SEWERAGE SYSTEMS HOWARD COUNTY HEALTH DEPT
 APPROVED HOWARD COUNTY OFFICE

107
of 10900

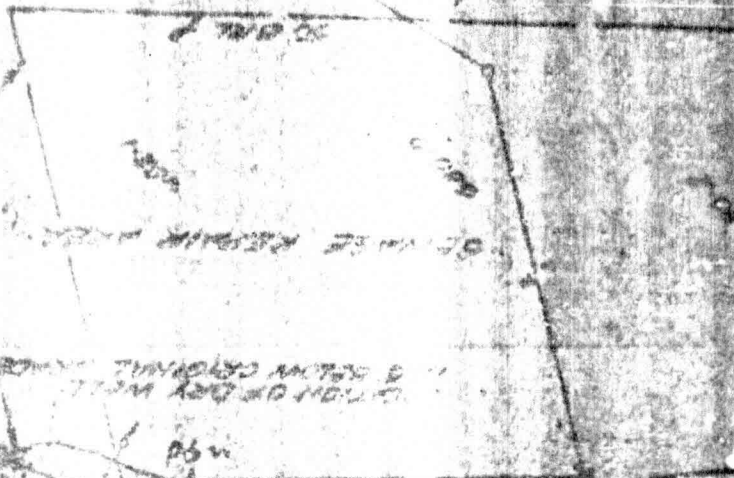

100

100

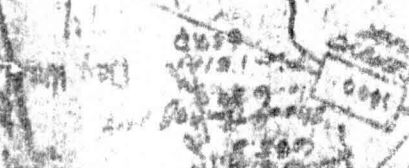

100

100

FLORENCE
ROAD