

6/27/75  
A.M. if possible  
final inspection

# PERMIT

SEWAGE DISPOSAL SYSTEM

MARYLAND STATE DEPARTMENT OF HEALTH

HOWARD COUNTY

## INDEXED

P 21357

A 18059

18059

ELLICOTT CITY

DISTRICT 4

DATE 5/12/75

Howard Pickett IS PERMITTED TO INSTALL  ALTER

ADDRESS Watersville Road, Mt. Airy, Md. PHONE 629-0543

A SEWAGE DISPOSAL SYSTEM LOCATED AT

SUBDIVISION ROAD 2150 Florence Road LOT 2

PROPERTY OWNER Frank N. Smith

ADDRESS

SPECIFICATIONS - 3 bedrooms

DRAIN FIELD DEPTH FEET. BOTTOM AREA SQ. FT.

SEEPAGE PITS ABSORBENT SIDE-WALL AREA SQ. FT.

SEPTIC TANK CAPACITY 1,000 GALLONS

FOR GARBAGE GRINDER INCREASE DISPOSAL AREA 22% & TANK CAPACITY 50%.

OTHER Dry well - 171 sq. ft. absorbent sidewall area per bedroom to begin below the first 3/4 ft. of original grade. Max. depth permitted for dry well is 12 1/2 ft. below original grade. Place dry well in area as per attached drawing. Trench will also be added.

NOTE: ALL PIPE FROM HOUSE TO DISPOSAL AREA MUST BE CAST IRON. PERMIT VOID AFTER THREE YEARS.


NOTE: INSTALL STAND PIPE ON SEPTIC TANK AND DRYWELL. STAND PIPE MUST BE 6" IN DIA., CAST IRON, CONCRETE OR TERRA COTTA ACCEPTED.

PLANS APPROVED BY D. W. Monaghan DATE 10/21/74

FILL SEPTIC TANK AND DISTRIBUTION BOX WITH WATER BEFORE CALLING FOR AN INSPECTION. COVER NO WORK UNTIL INSPECTED AND APPROVED.

NEITHER THE HOWARD COUNTY COMMISSIONERS NOR THE HEALTH DEPARTMENT IS RESPONSIBLE FOR THE SUCCESSFUL OPERATION OF ANY SYSTEM.

NOTE: CALL FOR INSPECTION OF TRENCH WHEN EXCAVATED BEFORE ANY GRAVEL IS INSTALLED.

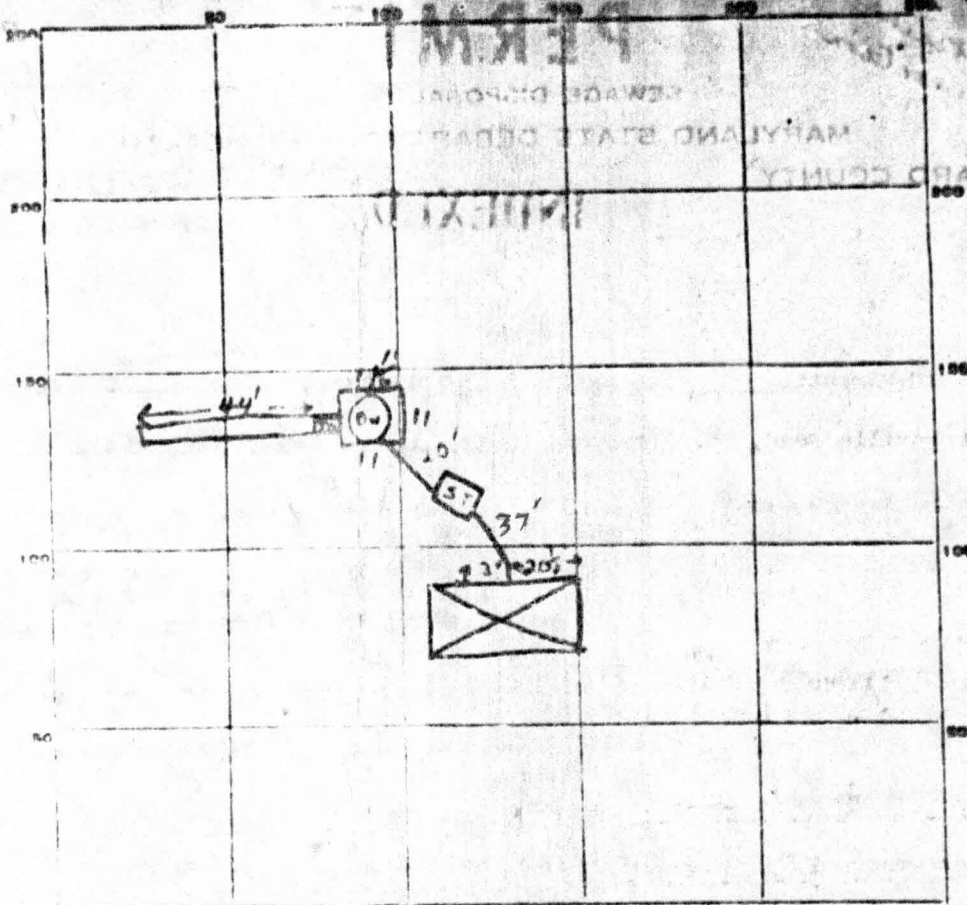

INDICATE NORTH - NAME ADJOINING ROADWAY AS BASE LINE.  
 Florence Rd.

PERMIT CARD Virginia Code Section 101-10 ST | D.W.  
 SEPTIC TANK, LEVEL ✓ CLEANOUTS ✓  
 DISTRIBUTION BOX, LEVEL \_\_\_\_\_  
 TILE-FIELD, DEPTH 10 FT. TRENCH WIDTH 2 FT.  
 GRAVEL DEPTH 5 FT. TOTAL LENGTH 44 FT. 30' 2" 11  
 NUMBER OF TRENCHES 1 TOTAL BOTTOM AREA \_\_\_\_\_  
 SEEPAGE PITS, INSIDE DIAMETER 45 FT. DEPTH BELOW INLET 9 FT. 40' 5" 5'  
 ABSORBENT AREA \_\_\_\_\_ SQ. FT.

REMARKS 6/24/75 Install gravel pipe in tank & pipe in out of system. Clean  
records needed on tank & gravel 5' S. & W. 2. 6/27/75

DATE SYSTEM APPROVED 6/29/75 INSPECTOR C. B. Stecker