

6/30/75  
6/25/75  
7/2/75

# PERMIT

SEWAGE DISPOSAL SYSTEM

P. 2025  
A. 1625

MARYLAND STATE DEPARTMENT OF HEALTH

HOWARD COUNTY

## INDEXED

ELLICOTT CITY

DISTRICT 3

## INDEXED

DATE 6/3/75

Naylor Plumbing Co., Inc. IS PERMITTED TO INSTALL  ALTER

ADDRESS Westley Road, Fishersburg, Md. PHONE 239-8141

A SEWAGE DISPOSAL SYSTEM LOCATED AT \_\_\_\_\_

SUBDIVISION \_\_\_\_\_ ROAD 13200 Jolly Hunter Road LOT \_\_\_\_\_  
Old Rolling Road

PROPERTY OWNER Chester W. Walker

ADDRESS \_\_\_\_\_

SPECIFICATIONS - 3 bedrooms

DRAIN FIELD \_\_\_\_\_ DEPTH \_\_\_\_\_ FEET, BOTTOM AREA \_\_\_\_\_ SQ. FT.

SEEPAGE PITS \_\_\_\_\_ ABSORBENT SIDE-WALL AREA \_\_\_\_\_ SQ. FT.

SEPTIC TANK CAPACITY 1,000 GALLONS

FOR GARBAGE GRINDER, INCREASE DISPOSAL AREA 22% & TANK CAPACITY 50%.

OTHER Dry well - 300 sq. ft. absorbent sidewall area to begin below the first 4 ft.

of non-porous soil. Maximum depth permitted for dry well is 11 ft. below original grade.

Locate dry well 60 ft. from left side line and 80 ft. from front property line as seen from Old Rolling Road.

Septic tank any greater than 3 ft. below grade needs manhole cleanout to grade.

NOTE: ALL PIPE FROM HOUSE TO DISPOSAL AREA MUST BE CAST IRON.

PERMIT VOID AFTER THREE YEARS.

NOTE: INSTALL CLEANOUTS ON SEPTIC TANK AND DRY WELL. CLEANOUTS MUST BE 6" IN DIA., CAST IRON.

PLANS APPROVED BY Robert V. Torre DATE 7/7/71  
CONCRETE OR TERRA COTTA ACCEPTED.


FILL SEPTIC TANK AND DISTRIBUTION BOX WITH WATER BEFORE CALLING FOR AN INSPECTION. COVER NO WORK UNTIL INSPECTED AND APPROVED.

NEITHER THE HOWARD COUNTY COMMISSIONERS NOR THE HEALTH DEPARTMENT IS RESPONSIBLE FOR THE SUCCESSFUL OPERATION OF ANY SYSTEM.

*garage permit signed 9/25/78  
serial # 37257*

*A/6025*

*515285 E*

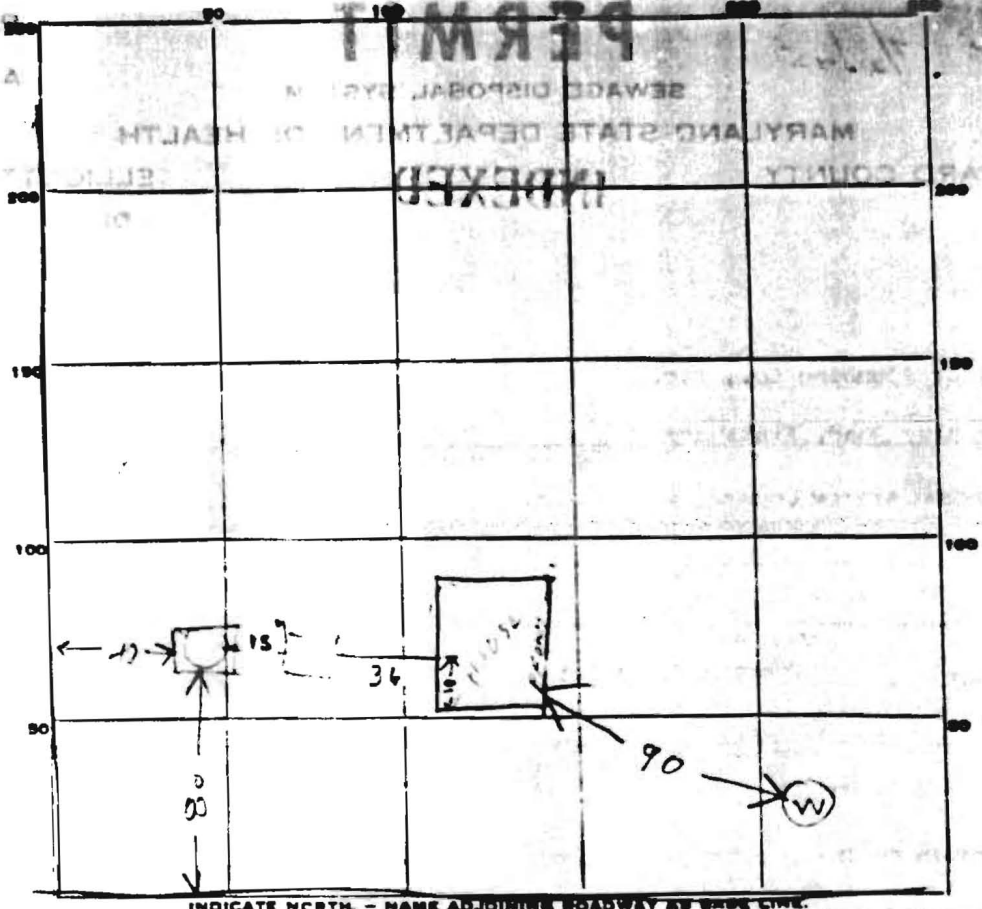

INDICATE NORTH - NAME ADJOINING ROADWAY BY BASE LINE.

PERMIT CARD Yes

SEPTIC TANK, LEVEL OK 1000 - 1000 CLEANOUTS OK

DISTRIBUTION BOX, LEVEL TOP IS 15' BY 85' W. 30' 00'

TILE FIELD, DEPTH \_\_\_\_\_ FT. TRENCH WIDTH \_\_\_\_\_ FT.

GRAVEL DEPTH \_\_\_\_\_ IN. TOTAL LENGTH \_\_\_\_\_ FT.

NUMBER OF TRENCHES \_\_\_\_\_ TOTAL BOTTOM AREA \_\_\_\_\_

SEEPAGE PITS, INSIDE DIAMETER 13x15 FT. DEPTH BELOW INLET 7 FT.

ABSORBENT AREA 392 SQ. FT.

REMARKS 1. IS DEPT. INLET TO BE 4' FROM  
W. 30' 00' DRYWELL HOLE DUG NOW  
OK TO COVER TANK. FINISH DRY WELL & CALL FOR INSPECTION  
W. 30' 00' RIT  
6-13-75 - 410 mat on dry well. R.T 7/2/75 lid on  
dry well - ok to cover (Note D. within 6" of surface)  
 DATE SYSTEM APPROVED 7/2/75 INSPECTOR C. B. Wheeler